




GRUNNMYND 2. HÆÐAR
1:100

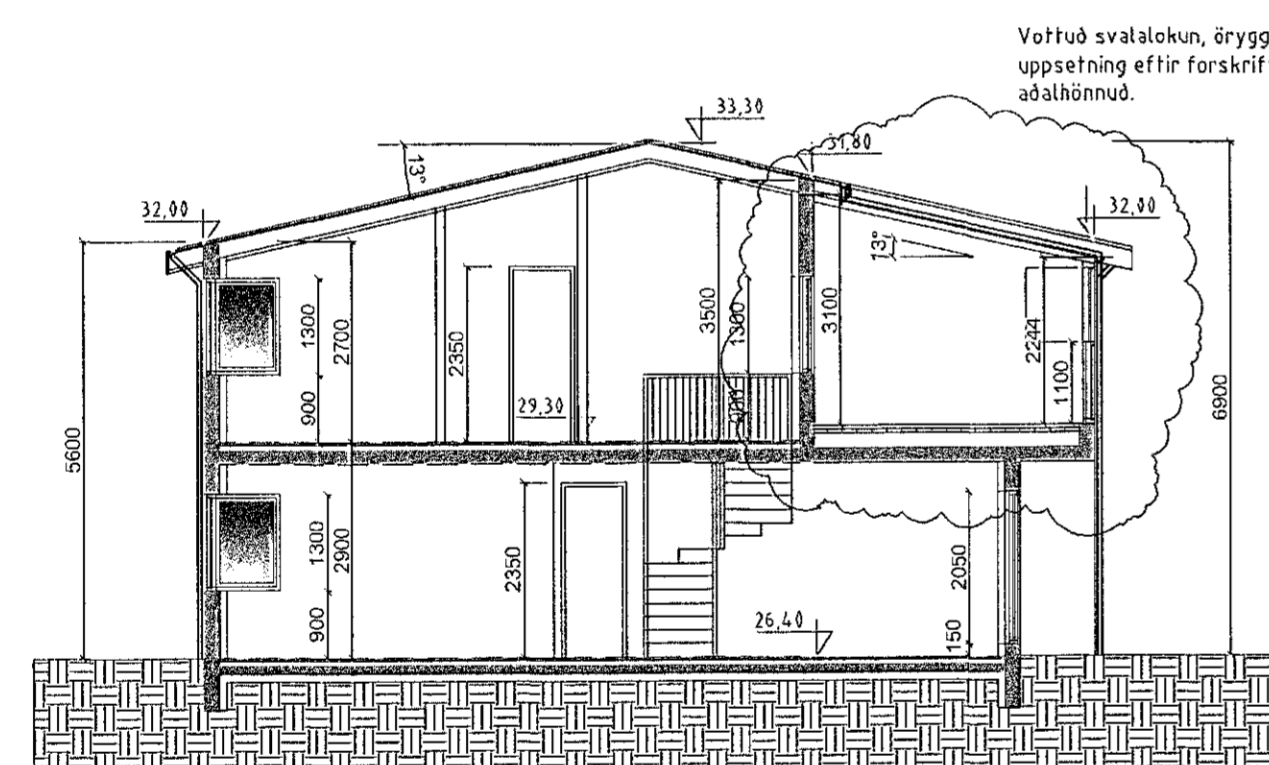


SNEIDING A-A HÚS 10
1:100

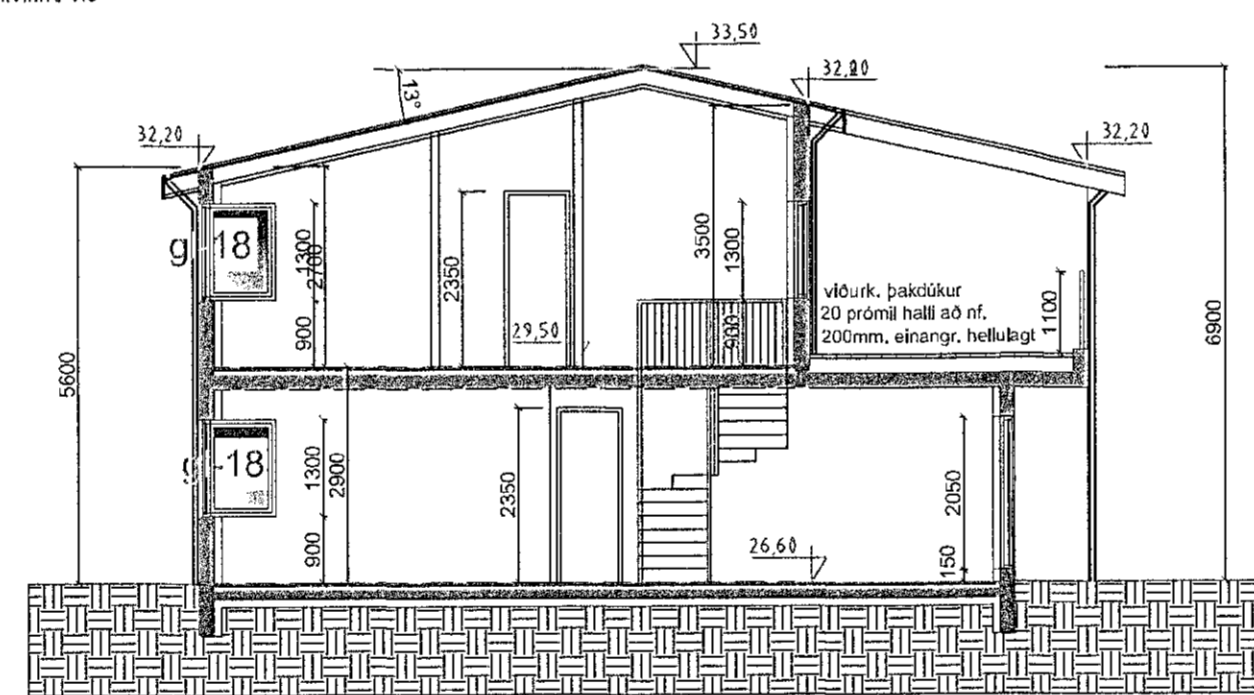

SNEIDING A-A
1:100

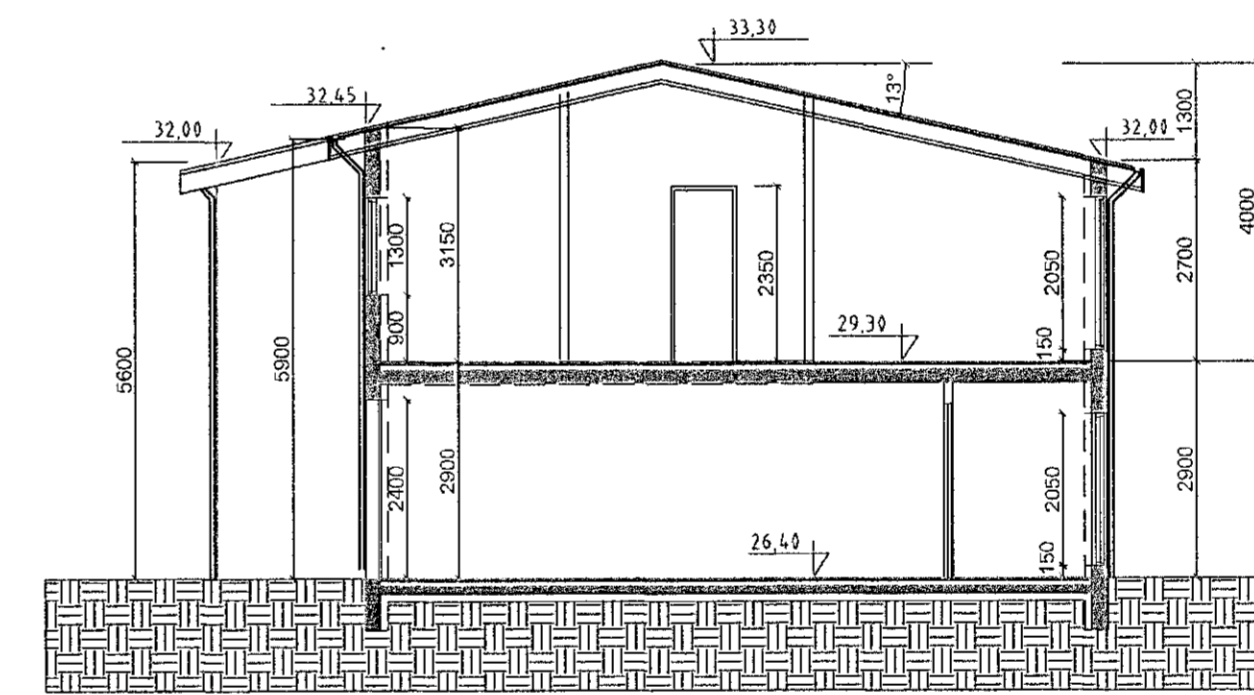

SNEIDING B-B
1:100

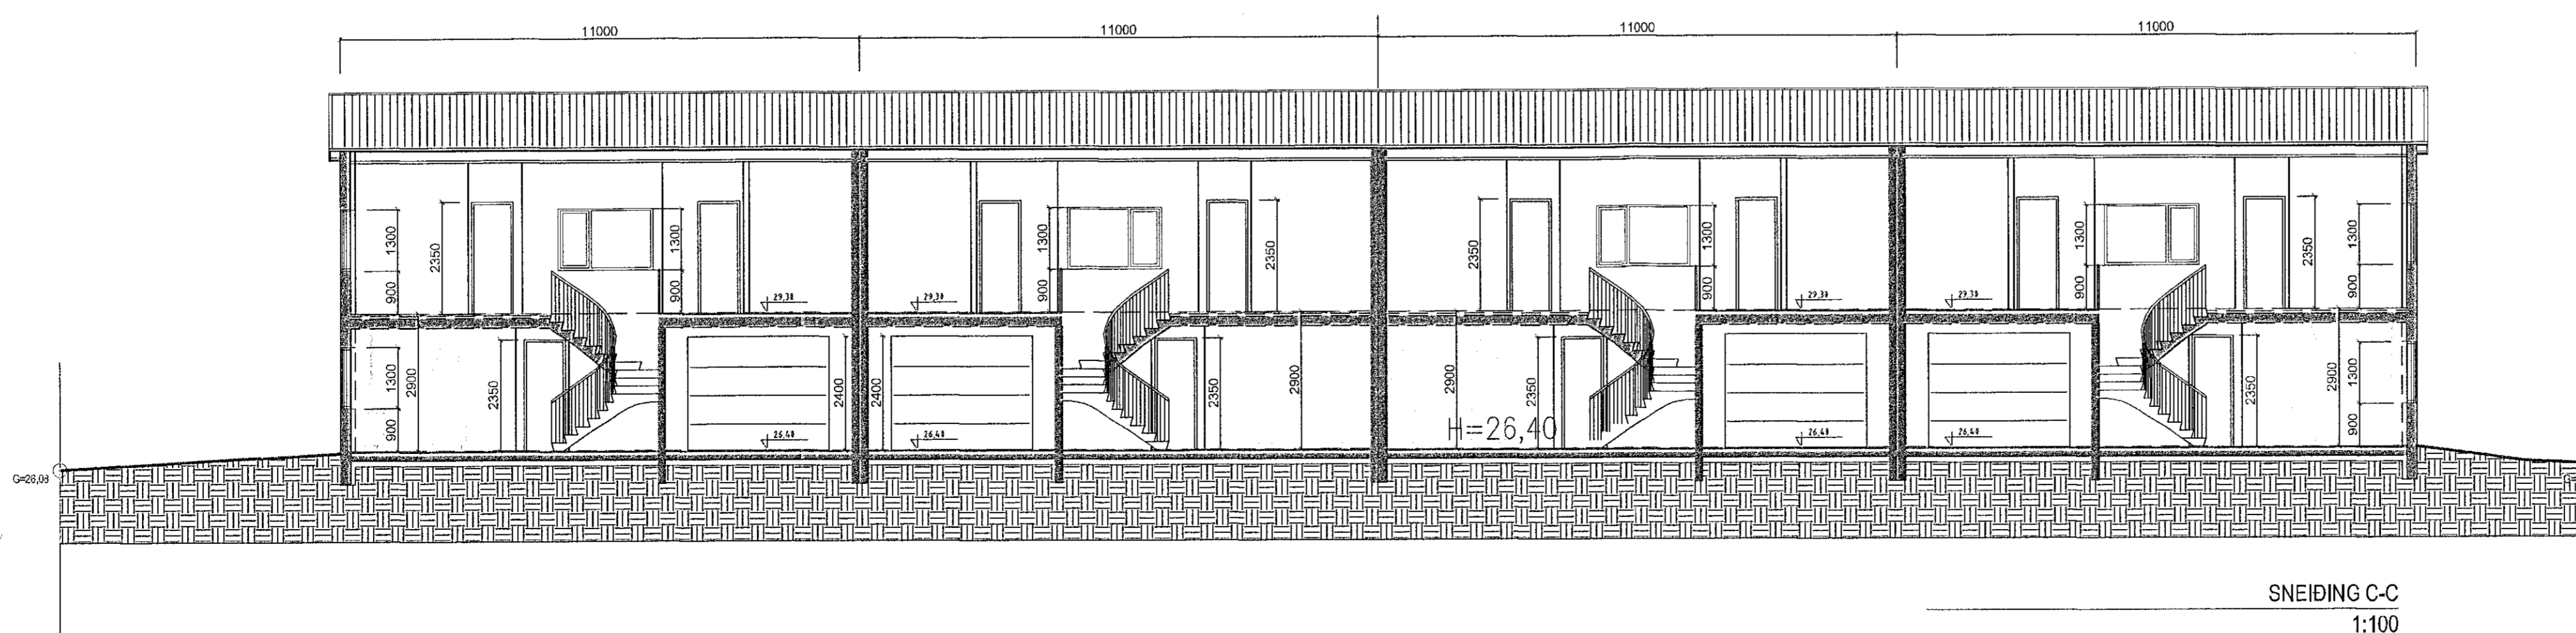

SNEIDING C-C
1:100

Vofuð svalatökun, öryggisglær samkv. reglugerð og uppsetningu eflir forskrift framleiðanda í samvinnu við aðalhönnuð.

NR.	DAGS.	BREYTING	SP.
01	11.12.19	SVIALALOKUN Á HÚSI NR. 18	
02	02.01.20	SPJALDLOKALOKUN 65% ÖPNUN	



460902-2150

554-3232
899-3234
E-MAIL kjartan@vikar.is

HÖNNUN - SKIPULAG - RÁÐGJÖF
KJARTAN RAFNSSON FILLIDSA 270365-3539
JÓN M. HALLDÓRSSON BYGGINGAFR. 091162-9509

Jón M. Halldórsson
VERK
KVISTAVELLIR 18-24
HAFNARFIRÐI

TEKNING
GRUNNMYND OG SNEIDINGAR

KVARDI
1:100

DAGS.
17.08.2006
TEKNAÐ AF
KR, JM/H

TEKNING NR.

10-03