




GRUNNMYND 2. HÆÐAR  
1:100

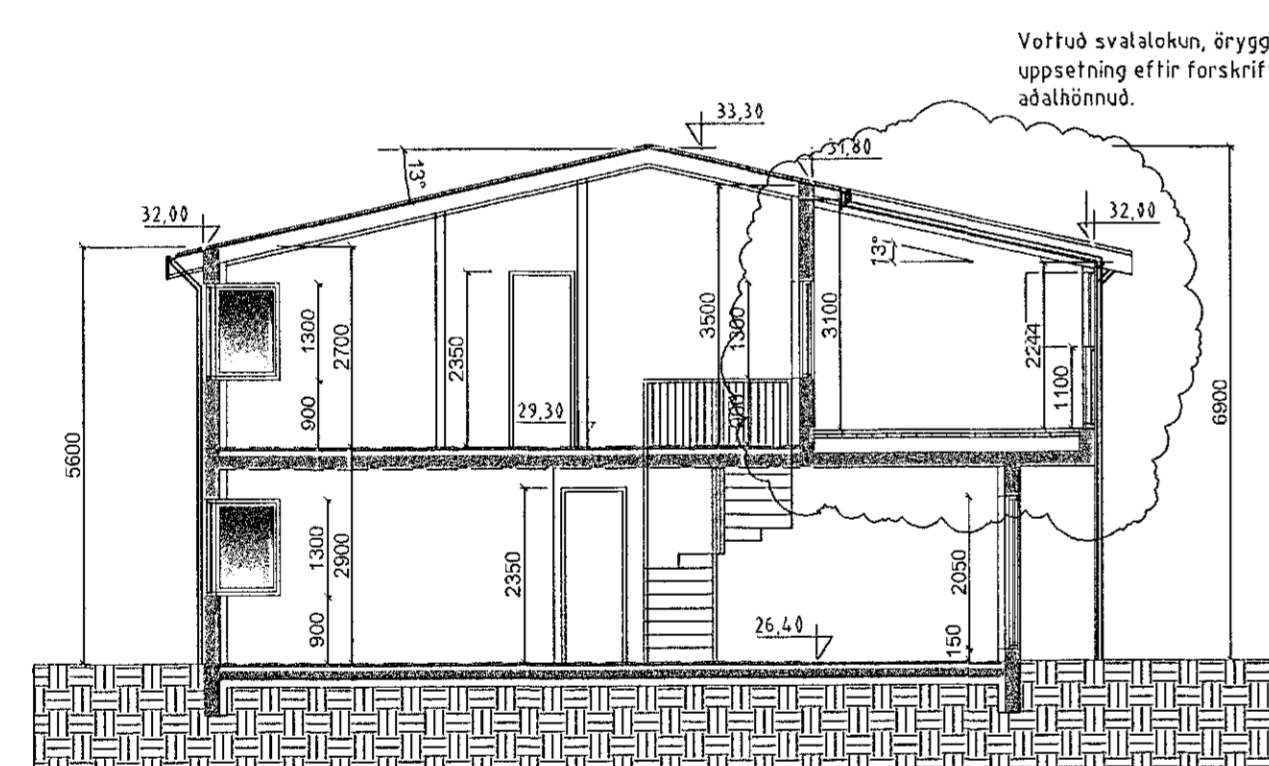


SNEIDING A-A HÚS 10  
1:100

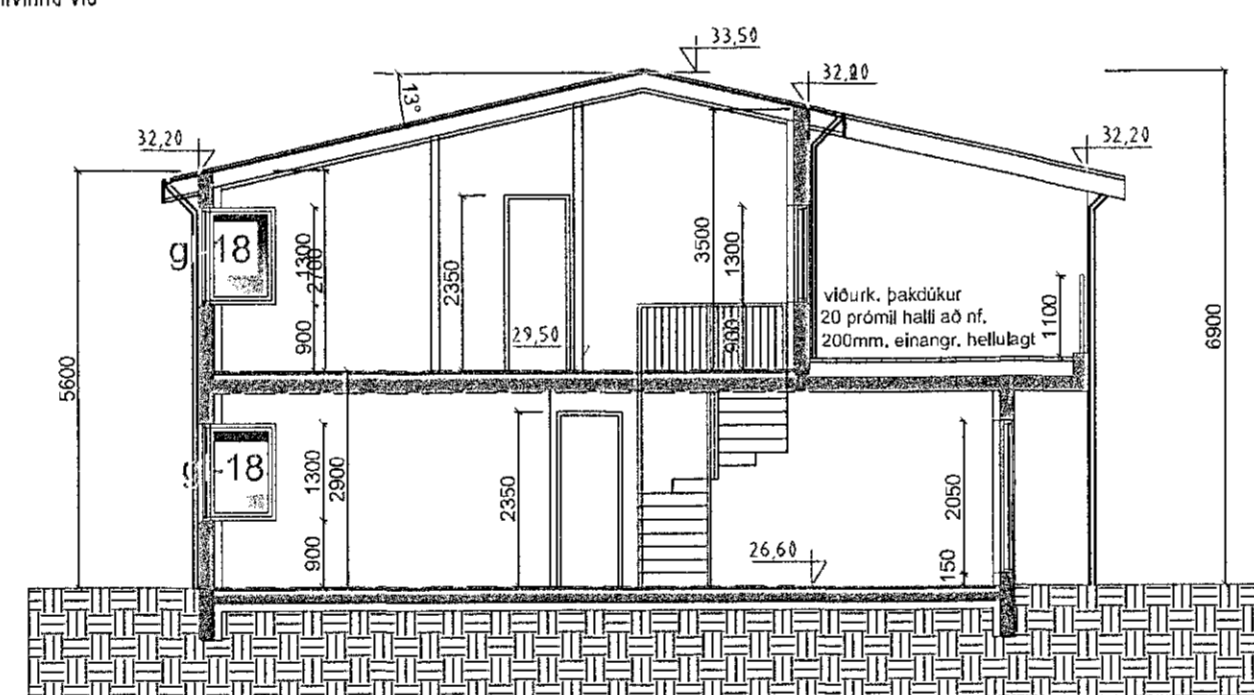

SNEIDING A-A  
1:100

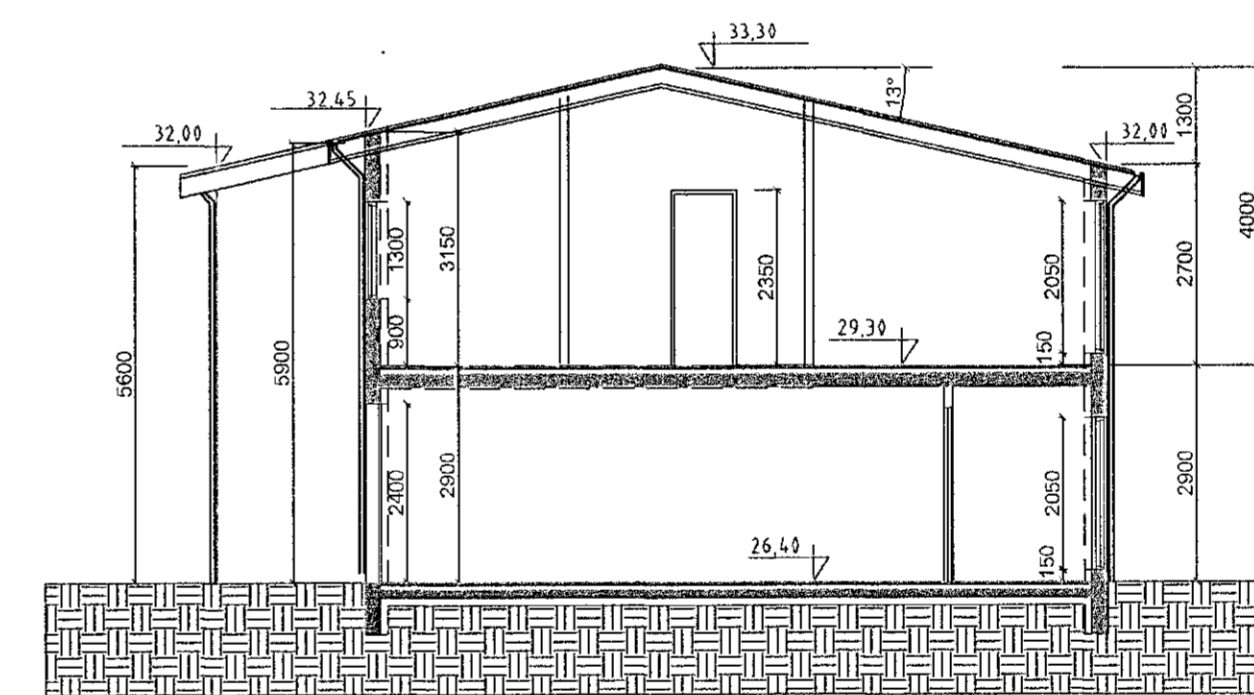

SNEIDING B-B  
1:100

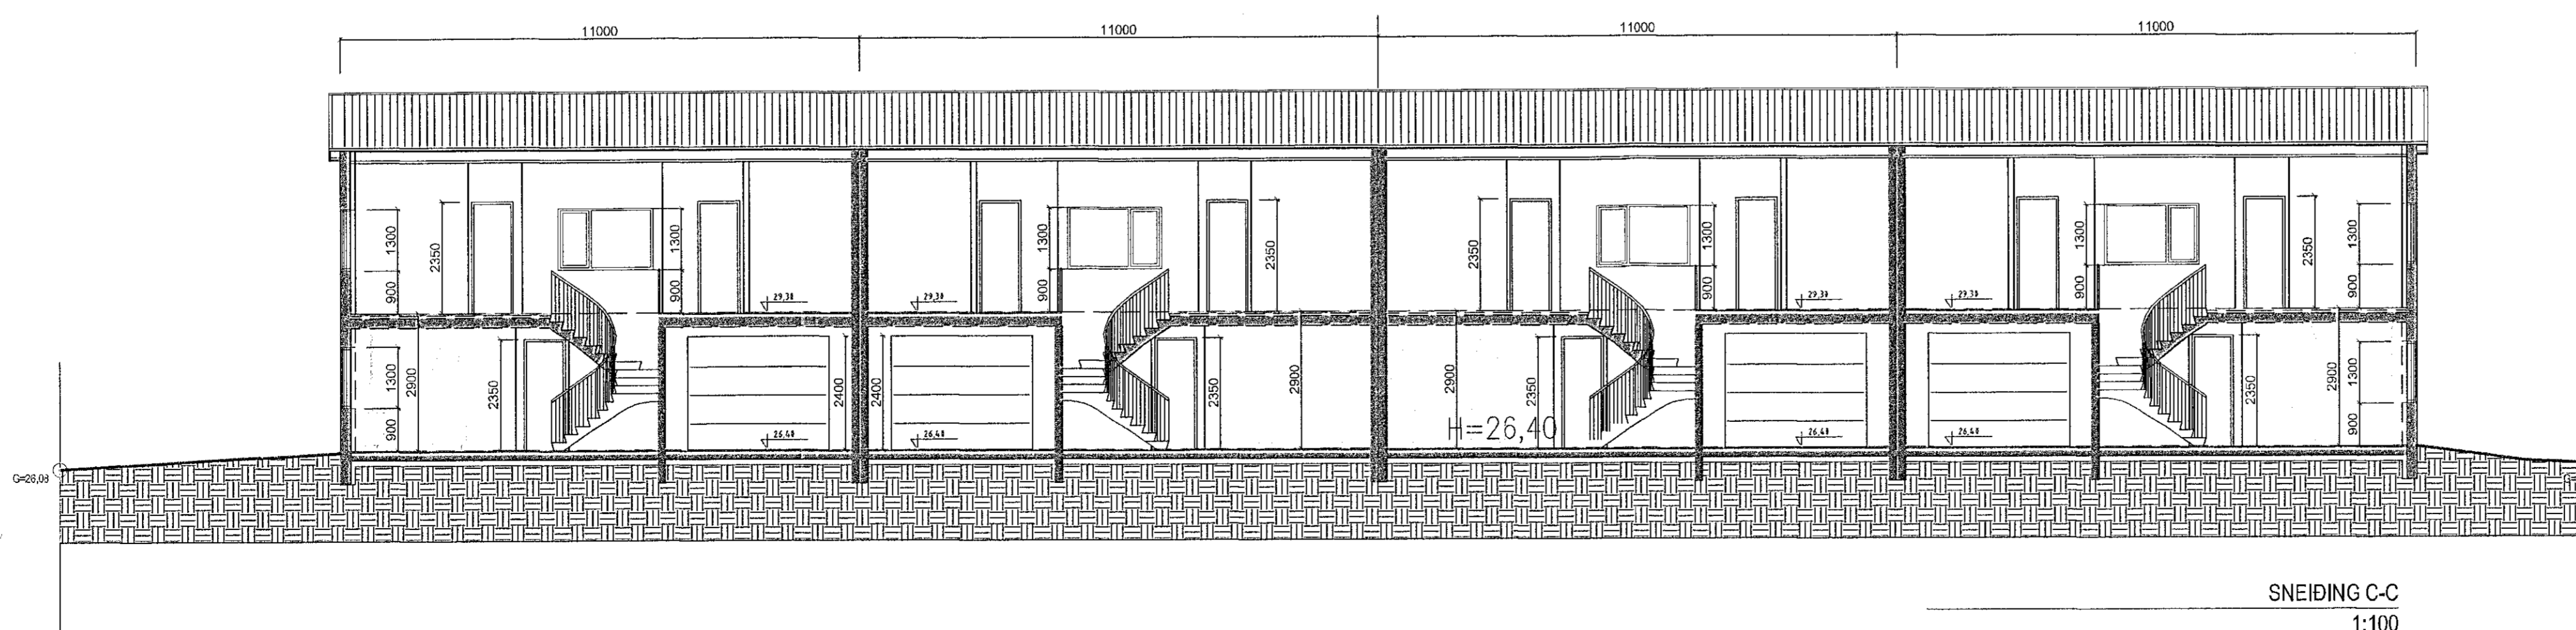

SNEIDING C-C  
1:100

NR.	DAGS.	BREYTING	SP.
01	11.12.19	SVIALALOKUN Á HÚSI NR. 18	
02	02.01.20	SPJALDLOKALOKUN 65% ÖPNUN	



460902-2150

554-3232  
899-3234  
kjartan@vikar.is

HÖNNUN - SKIPULAG - RÁÐGJÖF  
KJARTAN RAFNSSON FJELDGA  
JÓN M. HALLDÓRSSON BYGGINGAFR.

*Kjartan Rafnsson*  
VERK  
KVISTAVELLIR 18-24  
HAFNARFIRÐI

TEKNING  
GRUNNMYND OG SNEIDINGAR

KVARDI  
1:100

DAGS.  
17.08.2006  
TEKNAÐ AF  
KR, JM/H

TEKNING NR.

10-03