
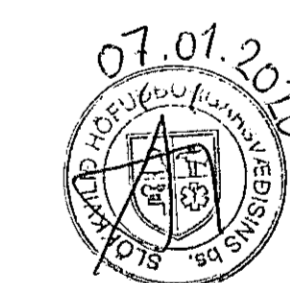
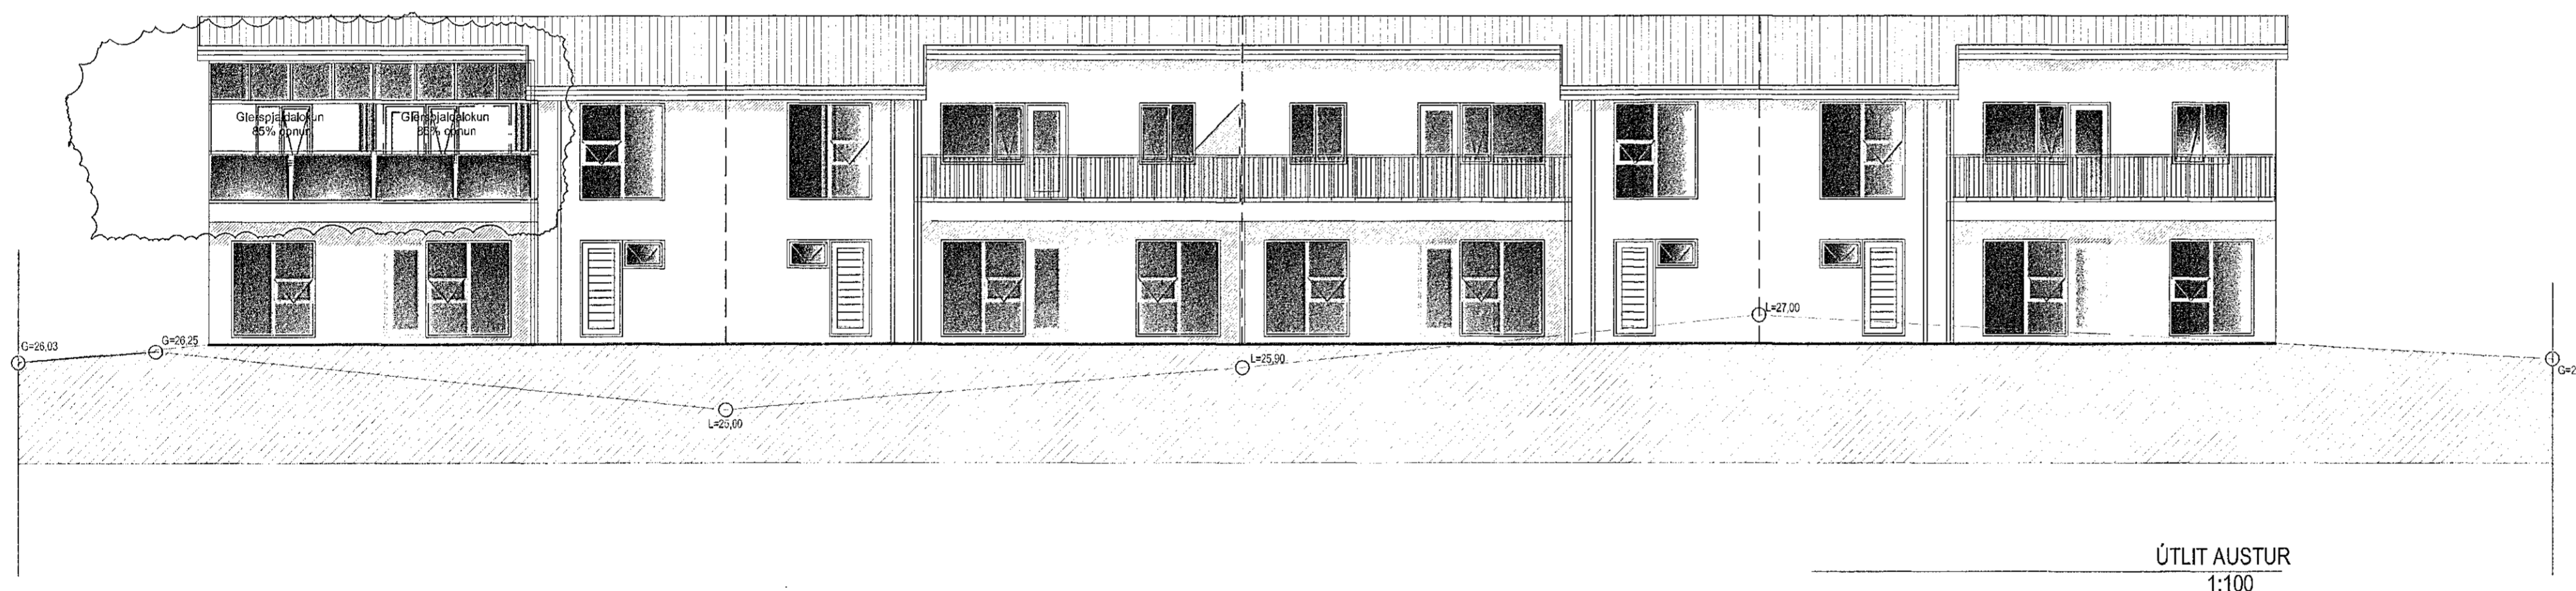
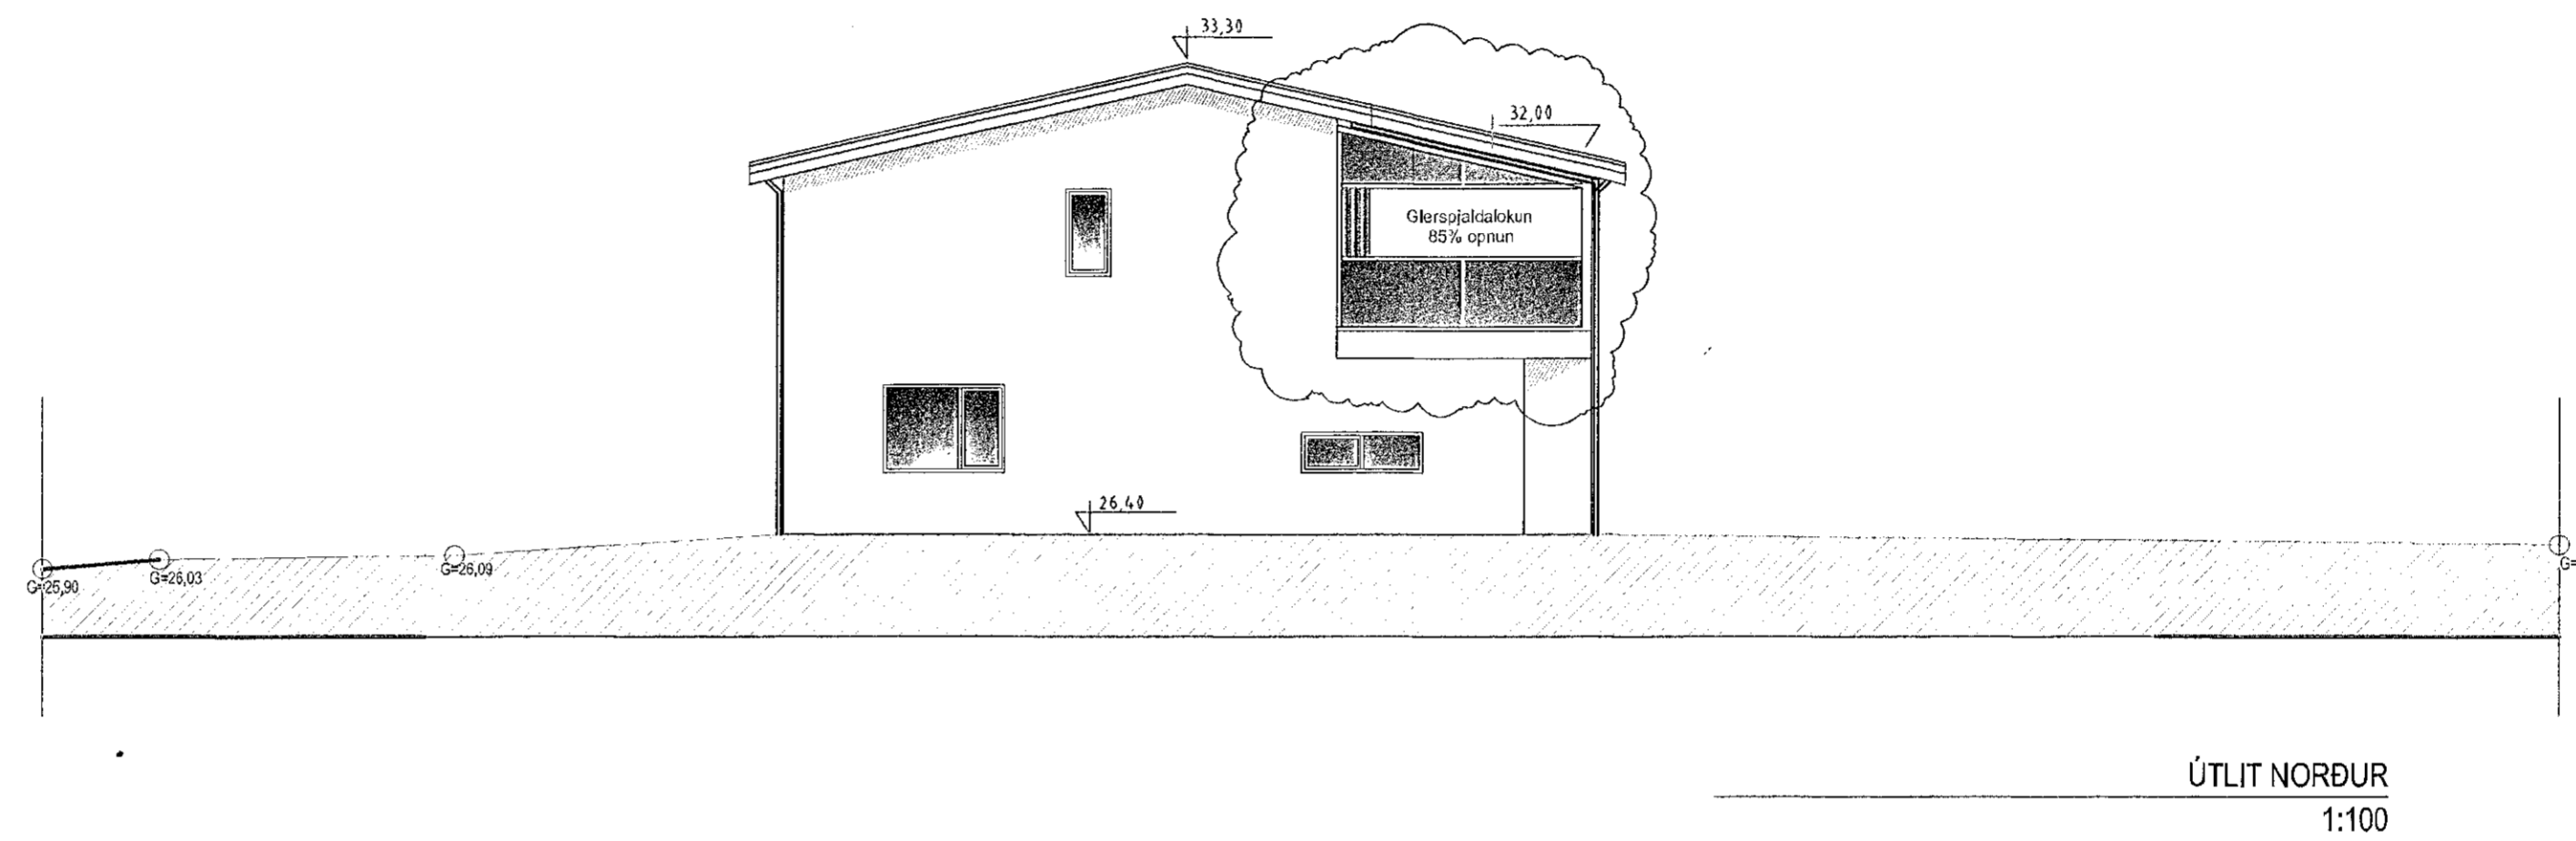


Samþykkt þann
 08. JAN. 2020
 Byggingarfulltrúinn í Hafnarfirði
Selma Þórunn

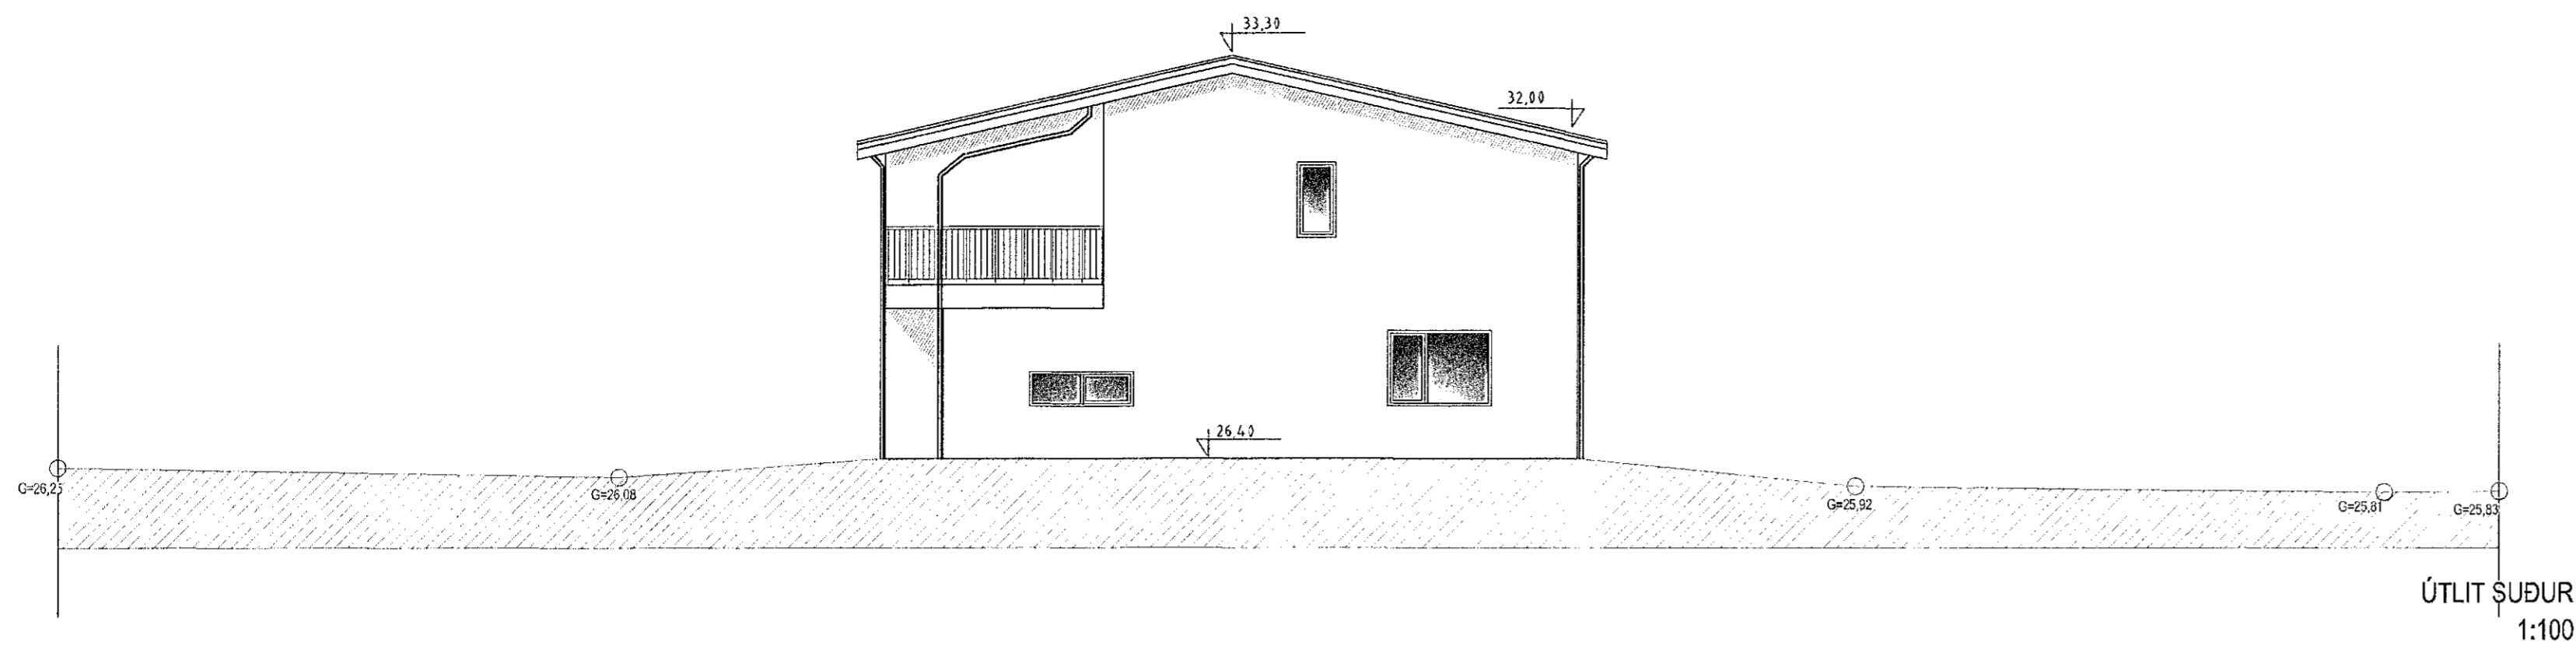

NR.	DAGS.	BREYTING	Sp.
01	11.12.19	SVALALOKUN Á HÚSI NR. 18	
02	02.01.20	SPJALDLOKALOKUN 85% OPNUN	

K.J. HÖNNUN EHF 460902-2150
 TEL: 554-3232
 TEL: 899-3234
 E-MAIL: kjhonnun@visir.is

HÖNNUN - SKIPULAG - RÁÐGJÖF
 KJARTAN RAFNSSON FÍLÍÐSA 270305-0539
 JÓN M. HALLDÓRSSON BYGGINGAFR. 691162-3509

SAMÞYKKT
Selma Þórunn
 VERK
 KVISTAVELLIR 18-24
 HAFNARFIRÐI

TEKNING
 ÚTLIT

KVARDI
 1:100

DAGS.
 17.08.2006
 TEKNAÐ AF
 KR, JMH

TEKNING NR.

10-04