
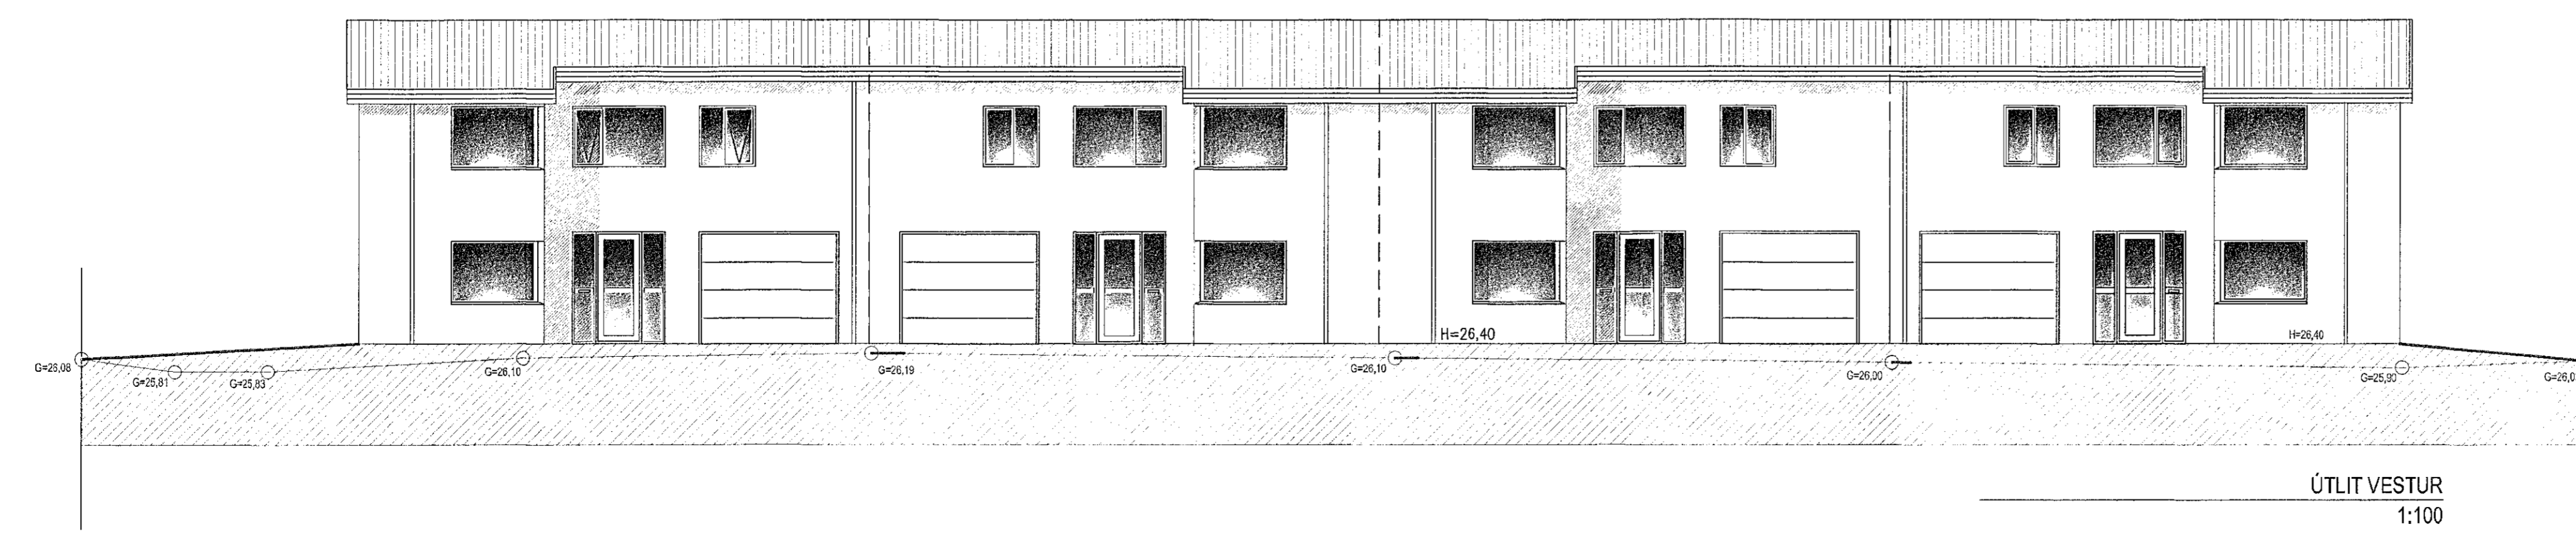
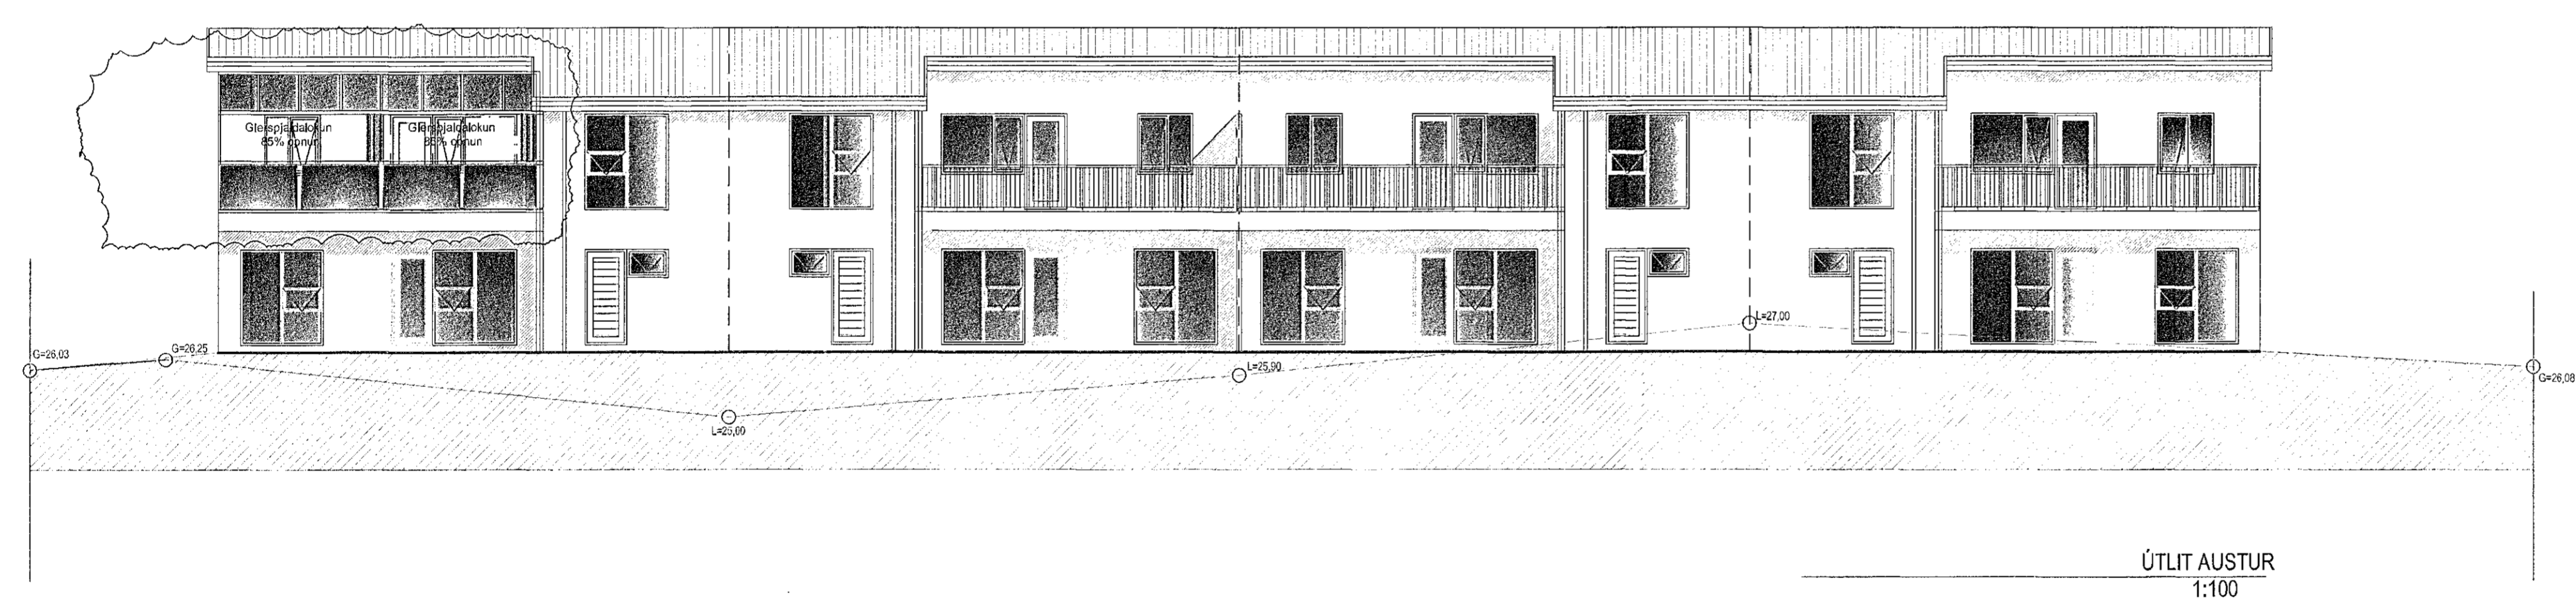
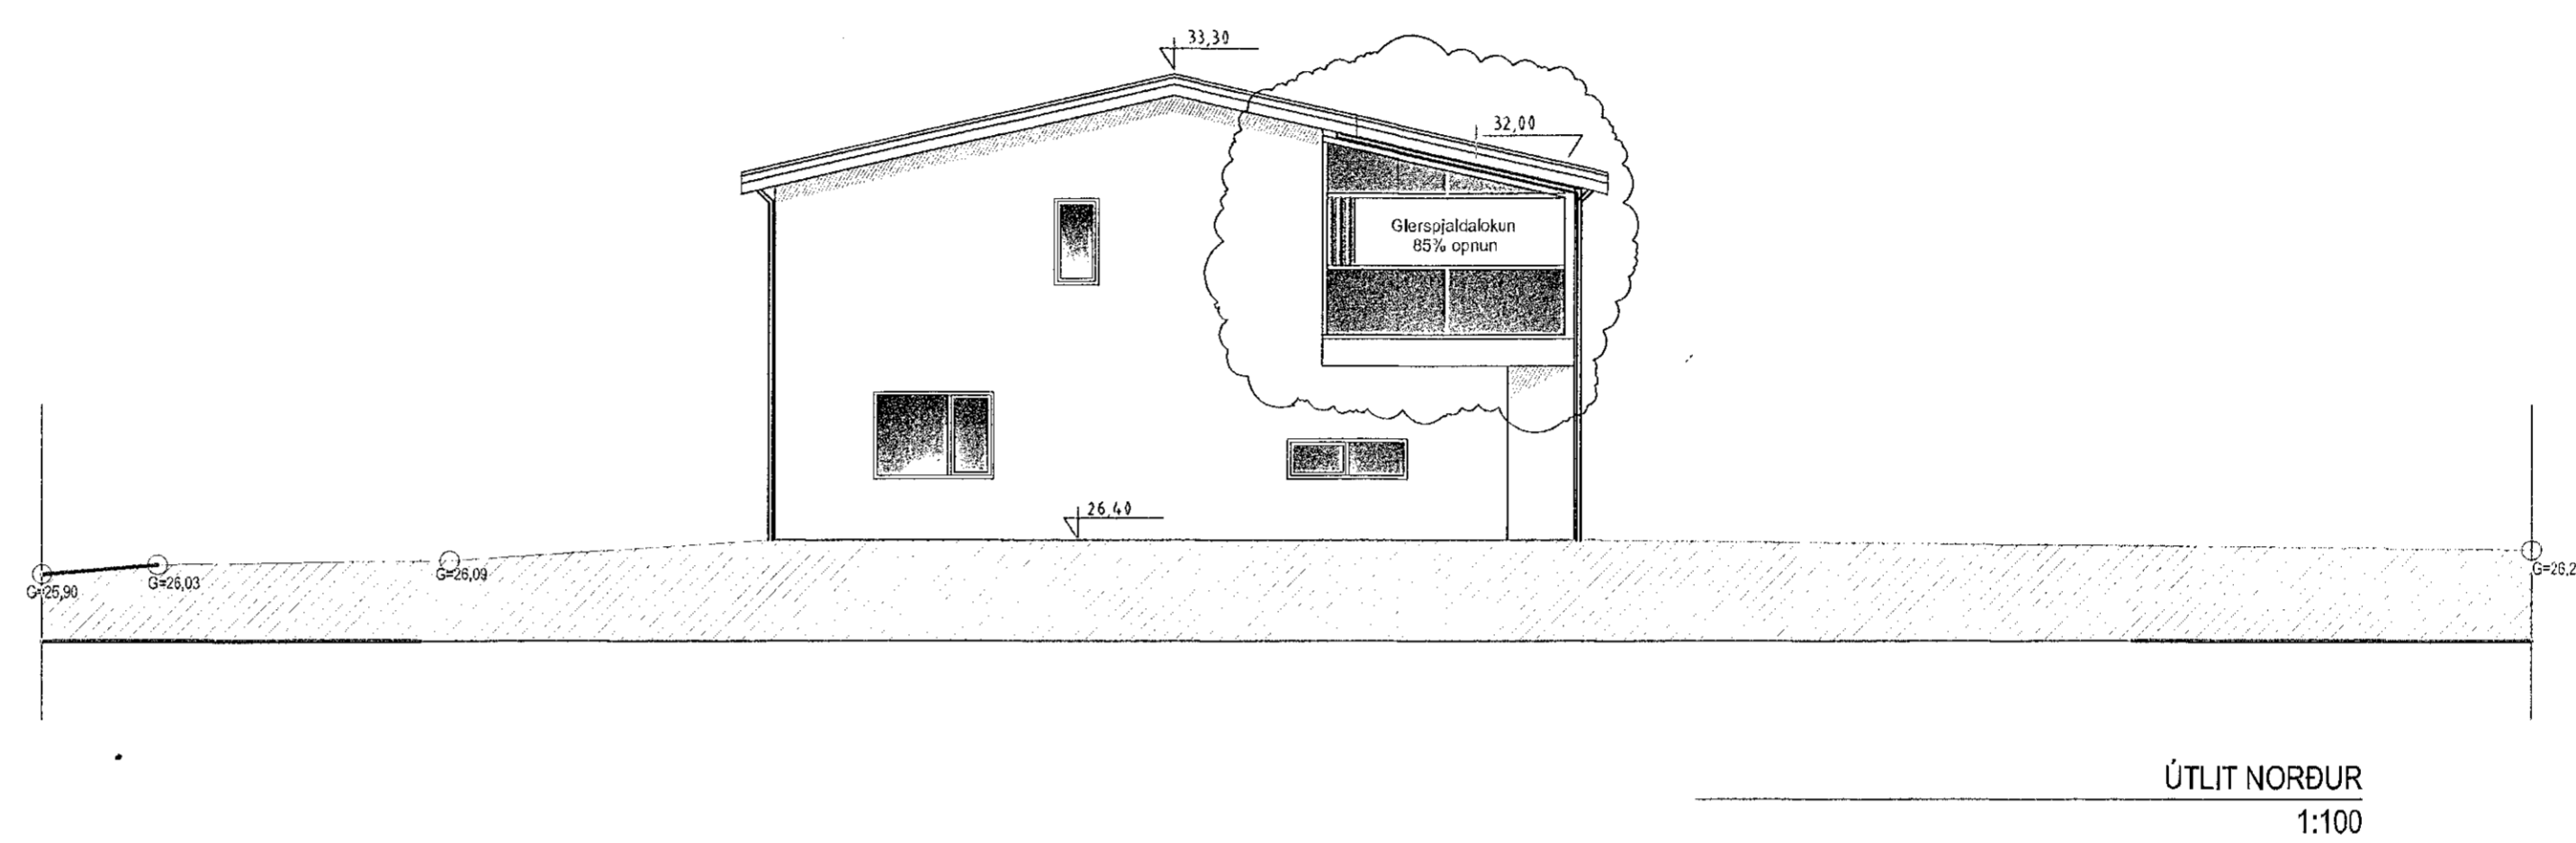


Samþykkt þann
08. JAN. 2020
Byggingarfulltrúinn í Hafnarfirði
Selma Þórunn

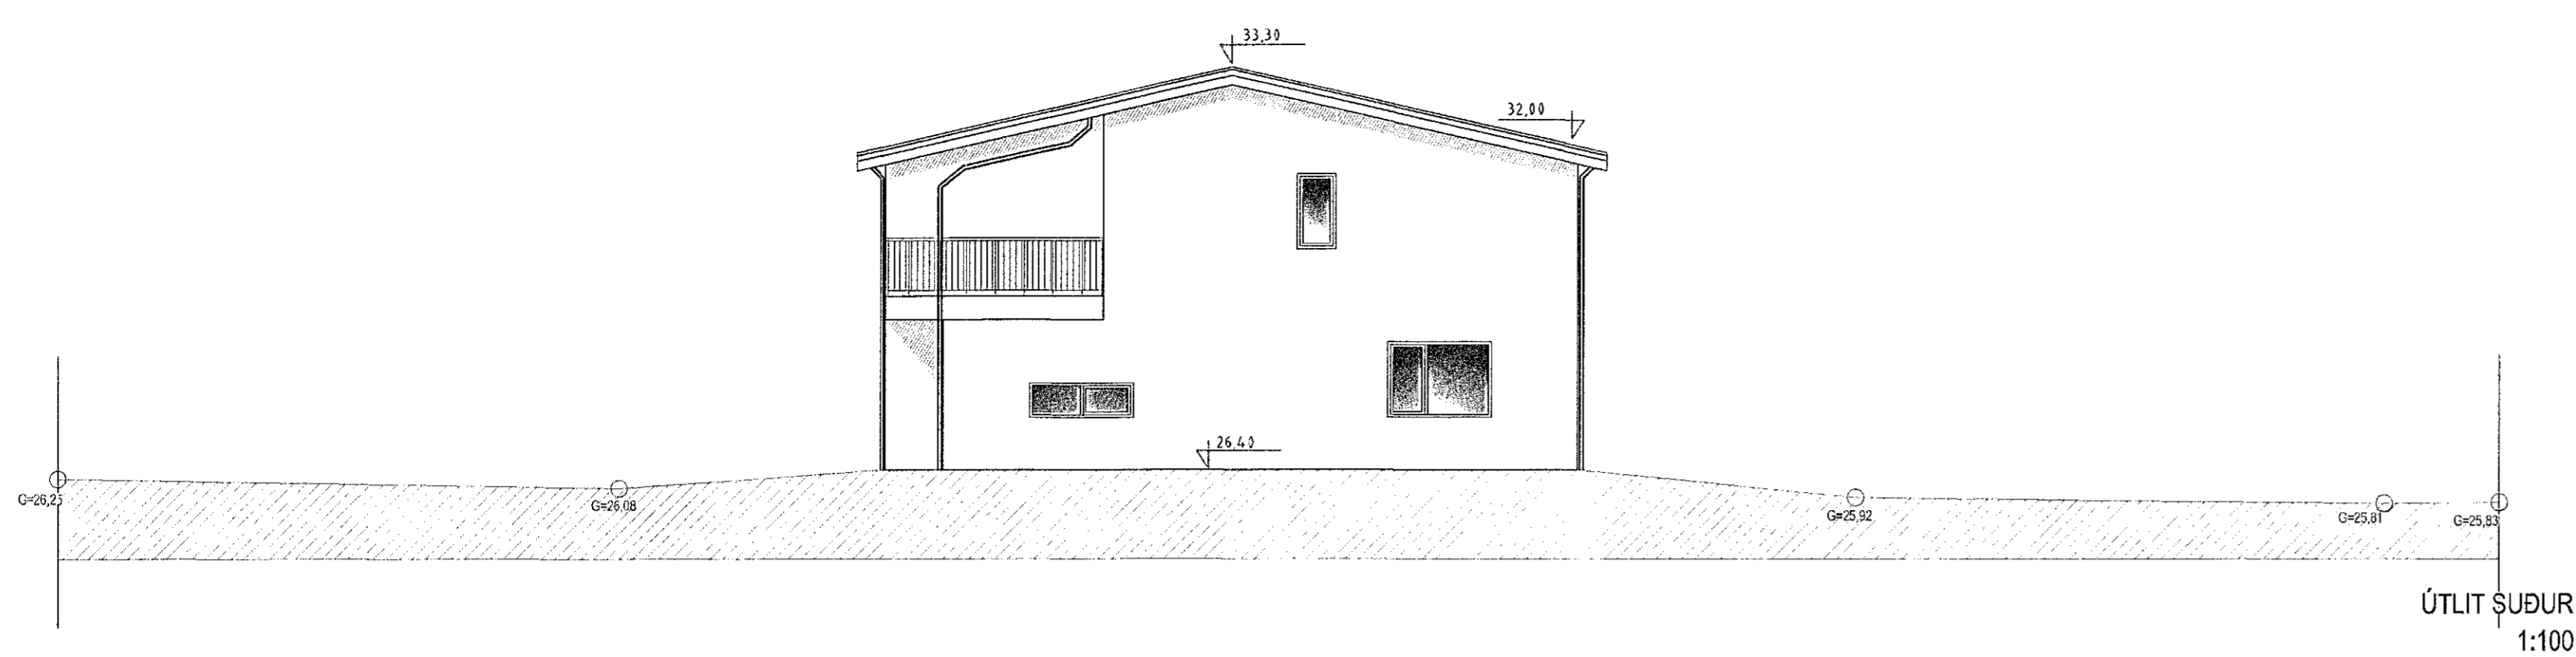

NR.	DAGS.	BREYTING	Sp.
01	11.12.19	SVALALOKUN Á HÚSI NR. 18	
02	02.01.20	SPJALDLOKALOKUN 85% OPNUN	

K.J. HÖNNUN EHF 460902-2150
TEL: 554-3232
TEL: 899-3234
E-MAIL: khonnun@visir.is

HÖNNUN - SKIPULAG - RÁÐGJÖF
KJARTAN RAFNSSON FÍLÍÐSA 270305-0539
JÓN M. HALLDÓRSSON BYGGINGAFR. 691162-3509

SAMÞYKKT
VERK *Selma Þórunn*
KVISTAVELLIR 18-24
HAFNARFIRÐI

TEKNING
ÚTLIT

KVARDI
1:100

DAGS.
17.08.2006
TEKNAÐ AF
KR, JMH

TEKNING NR.

10-04