



B-B.
1 : 100

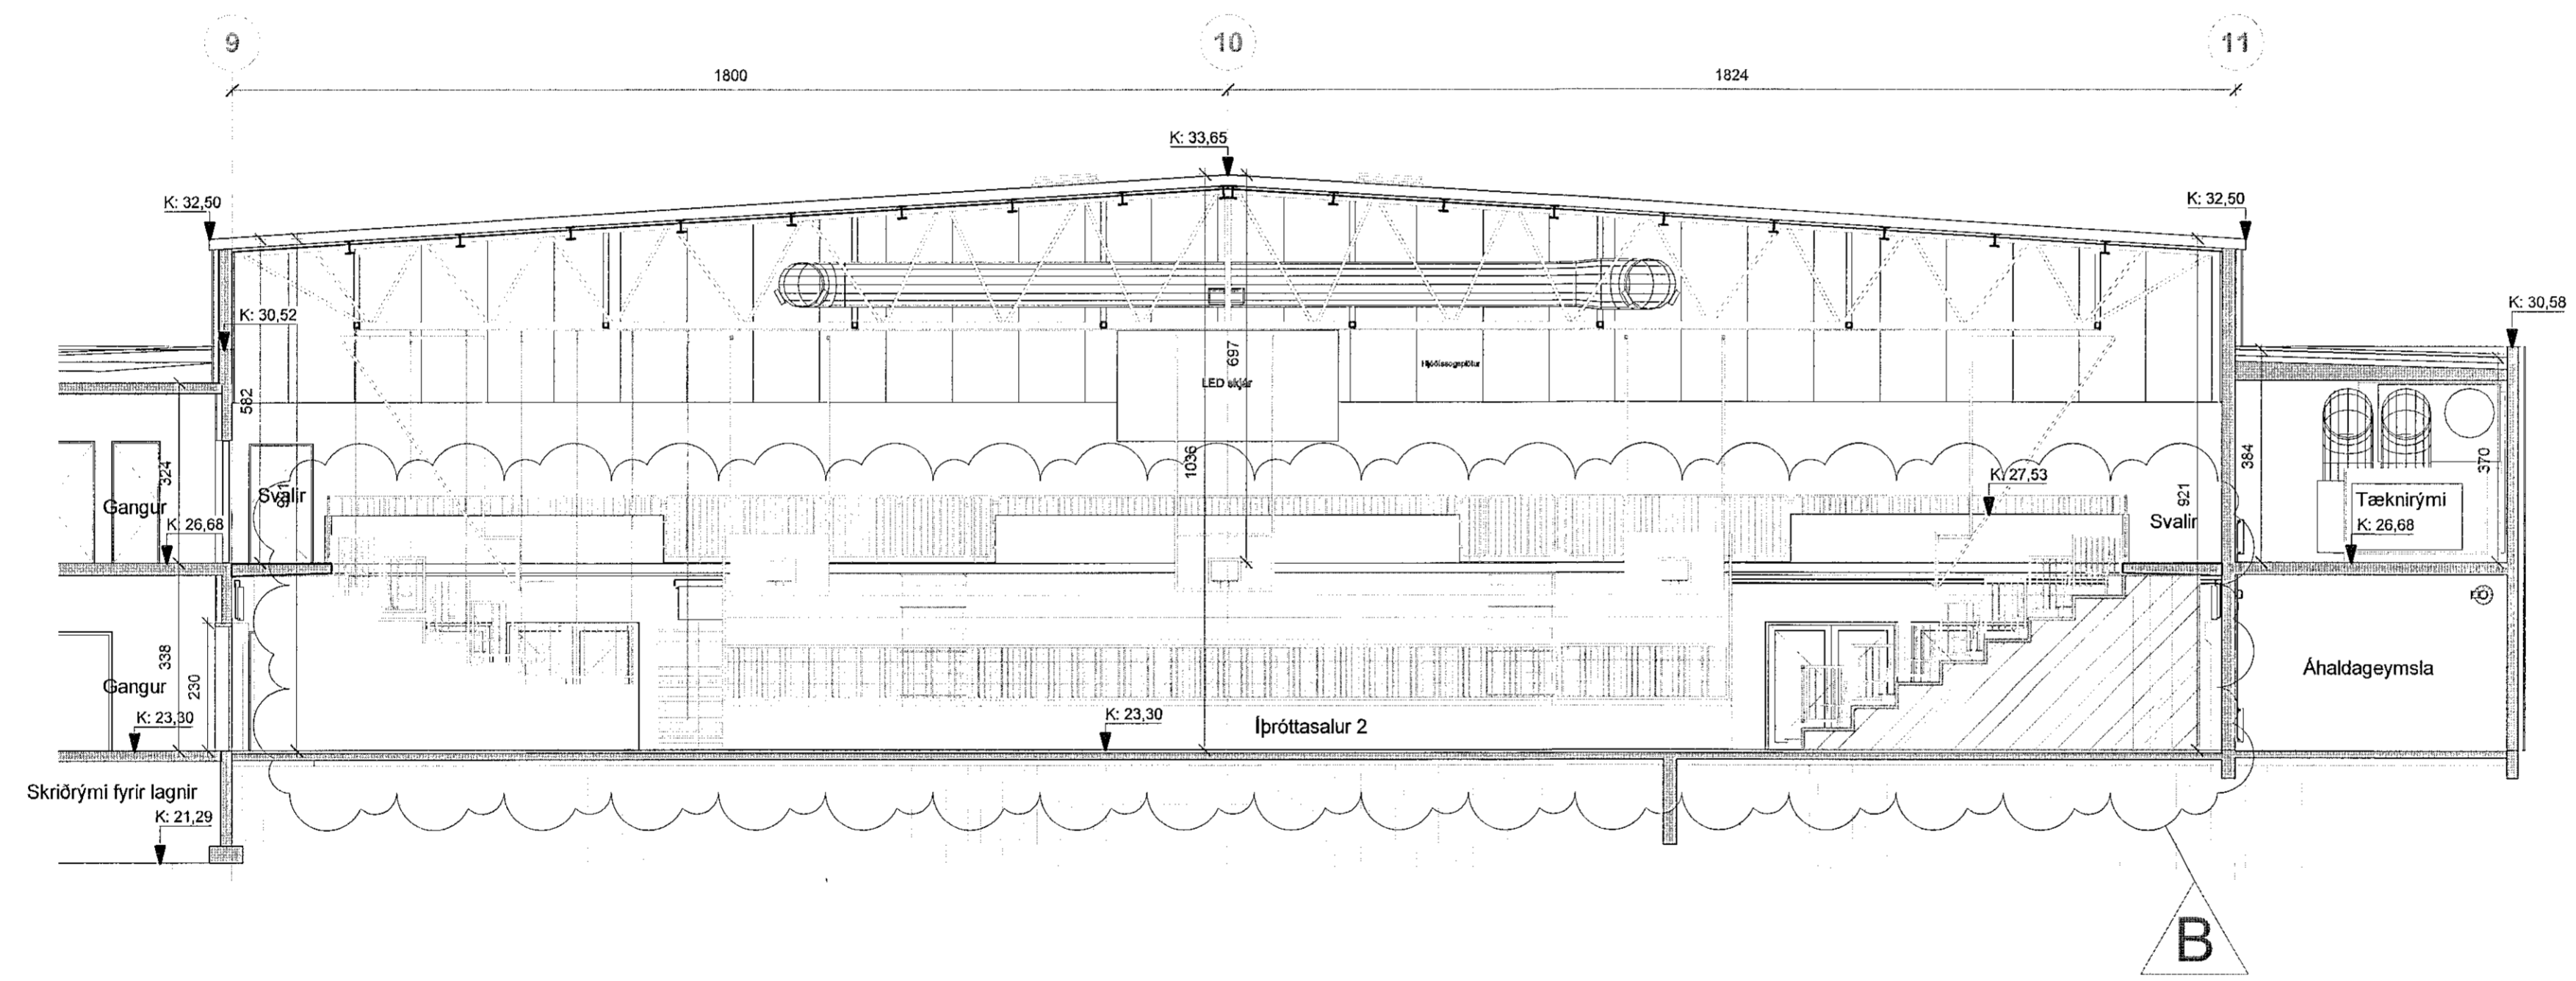

B-B - NA
1 : 100

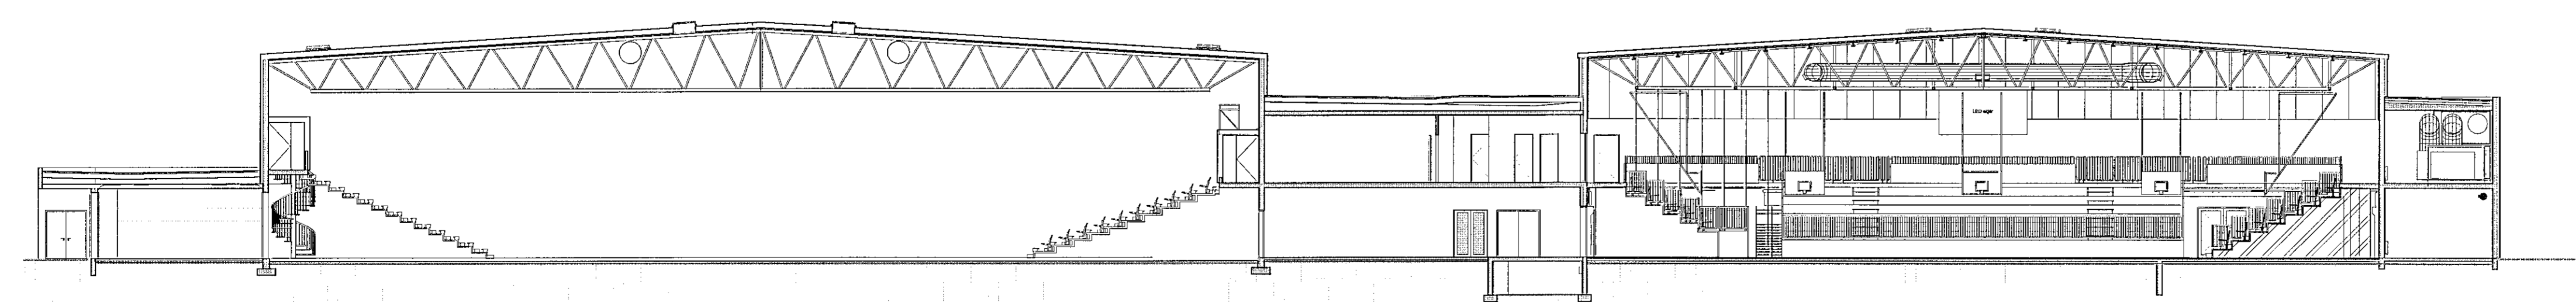

B-B yfirlit
1 : 200

HEILBRIGDISEFTIRLIT
HAFNARFIJARDAR-
OG KÖPVOGSSVÆÐIS
Gæðastigi 5 - 210 Reykjavík
27.2.2020
26.02.2020

- Skýringar vegna breytinga
- B Stúkur og bekkir uppfærðir í íþróttasal 2
 - A Nýjar tæknisvalir í eldri íþróttasal (sal nr.1).

B	TÞ	HMH	23.01.2020
A	KJH	HMH	09.02.2018
ÚTGÁFA	TEIKNAD	YFIRFARID	Dags

ASK ARKITEKTAR EHF
GERDUGUTU 9
101 REYKJAVÍK
115 0500
www.ask.is

ASK ARKITEKTAR
Hilgý Mía Haldrúnsson
ASKARF.F.A.I. xt. 301258-7046
hilgimar@ask.is

VERK NR.	9623	ALGÆNI - NÖMUR TEIKNINGAR	A-111	ÚTGÁFA	B
VERK NR.	9623	ALGÆNI - NÖMUR TEIKNINGAR	A-111	ÚTGÁFA	B