


Grunnmynd 2. hæð; 1:100

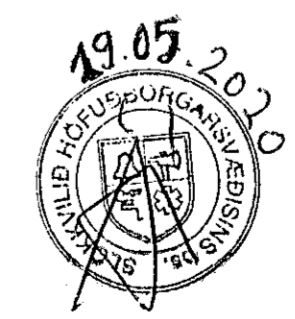

+ARKITEKTAR

Hlíðarás 26
Hafnarfirði

Grunnmynd 2. hæð

dags.	07.05.2020
mkv.	1:100
teikn.	H/ÁK
verknr.	1118

[Signature]
02

1118_Hlíðarás 26 (2020.05.02)(23).pin: 02 Grunnmynd 2. hæð; 100%; 6,7.230, 14.32