



Sampykkt þann
11. AGÚ. 2020
Byggingarfulltrúinn í Hafnarfirði
Haukur Ásgeirsson

ÚTGÁFUFRILL


NÚMÉR:	DAGS:	SKÝRINGAR:	UNNIÐ:
A	11.06.'13	ÝMSAR BREYTINGAR	JSS
DAGS:	SAMRÆM HÖNNUÐUR		

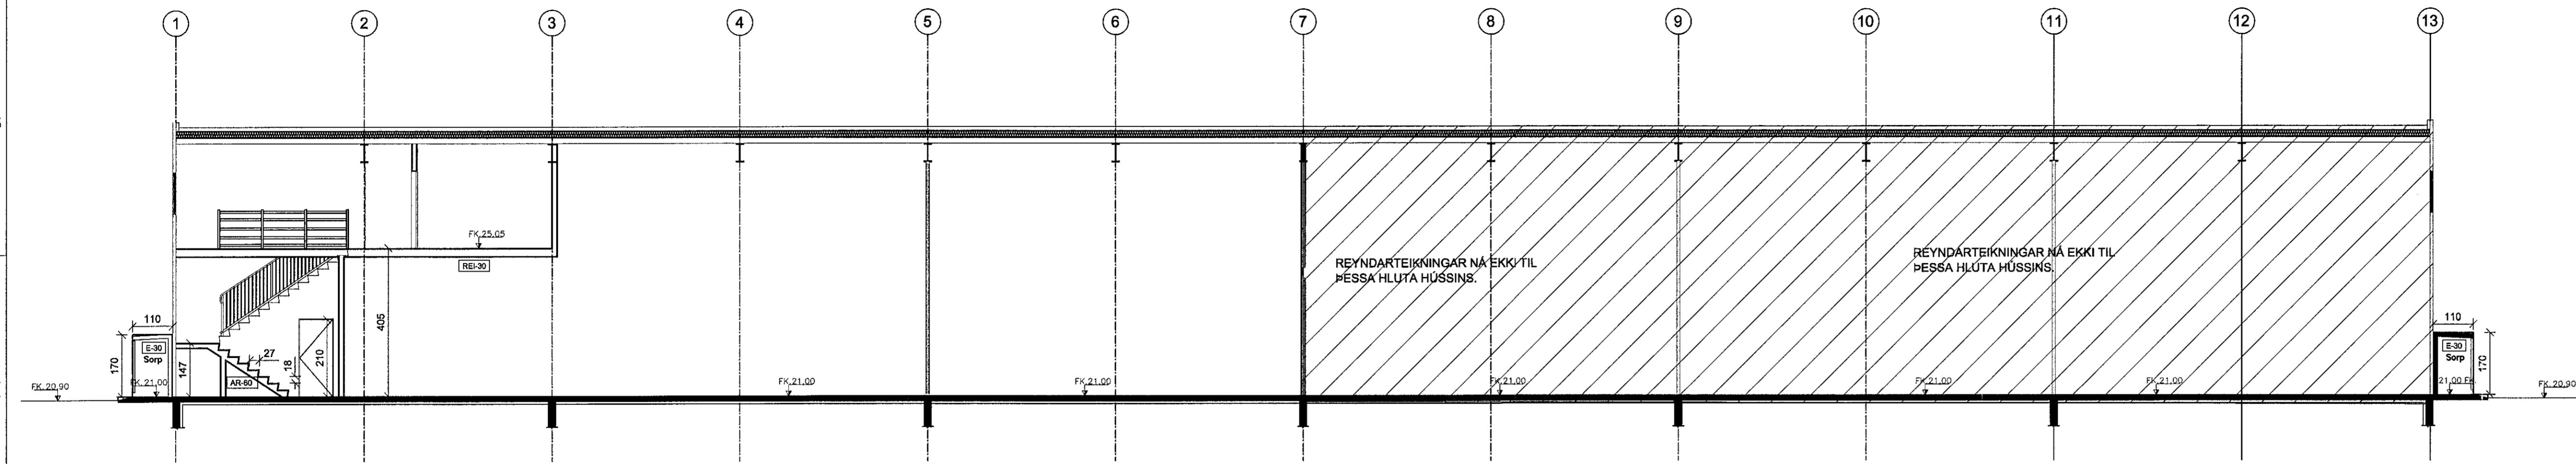

SNID A-A 1:100

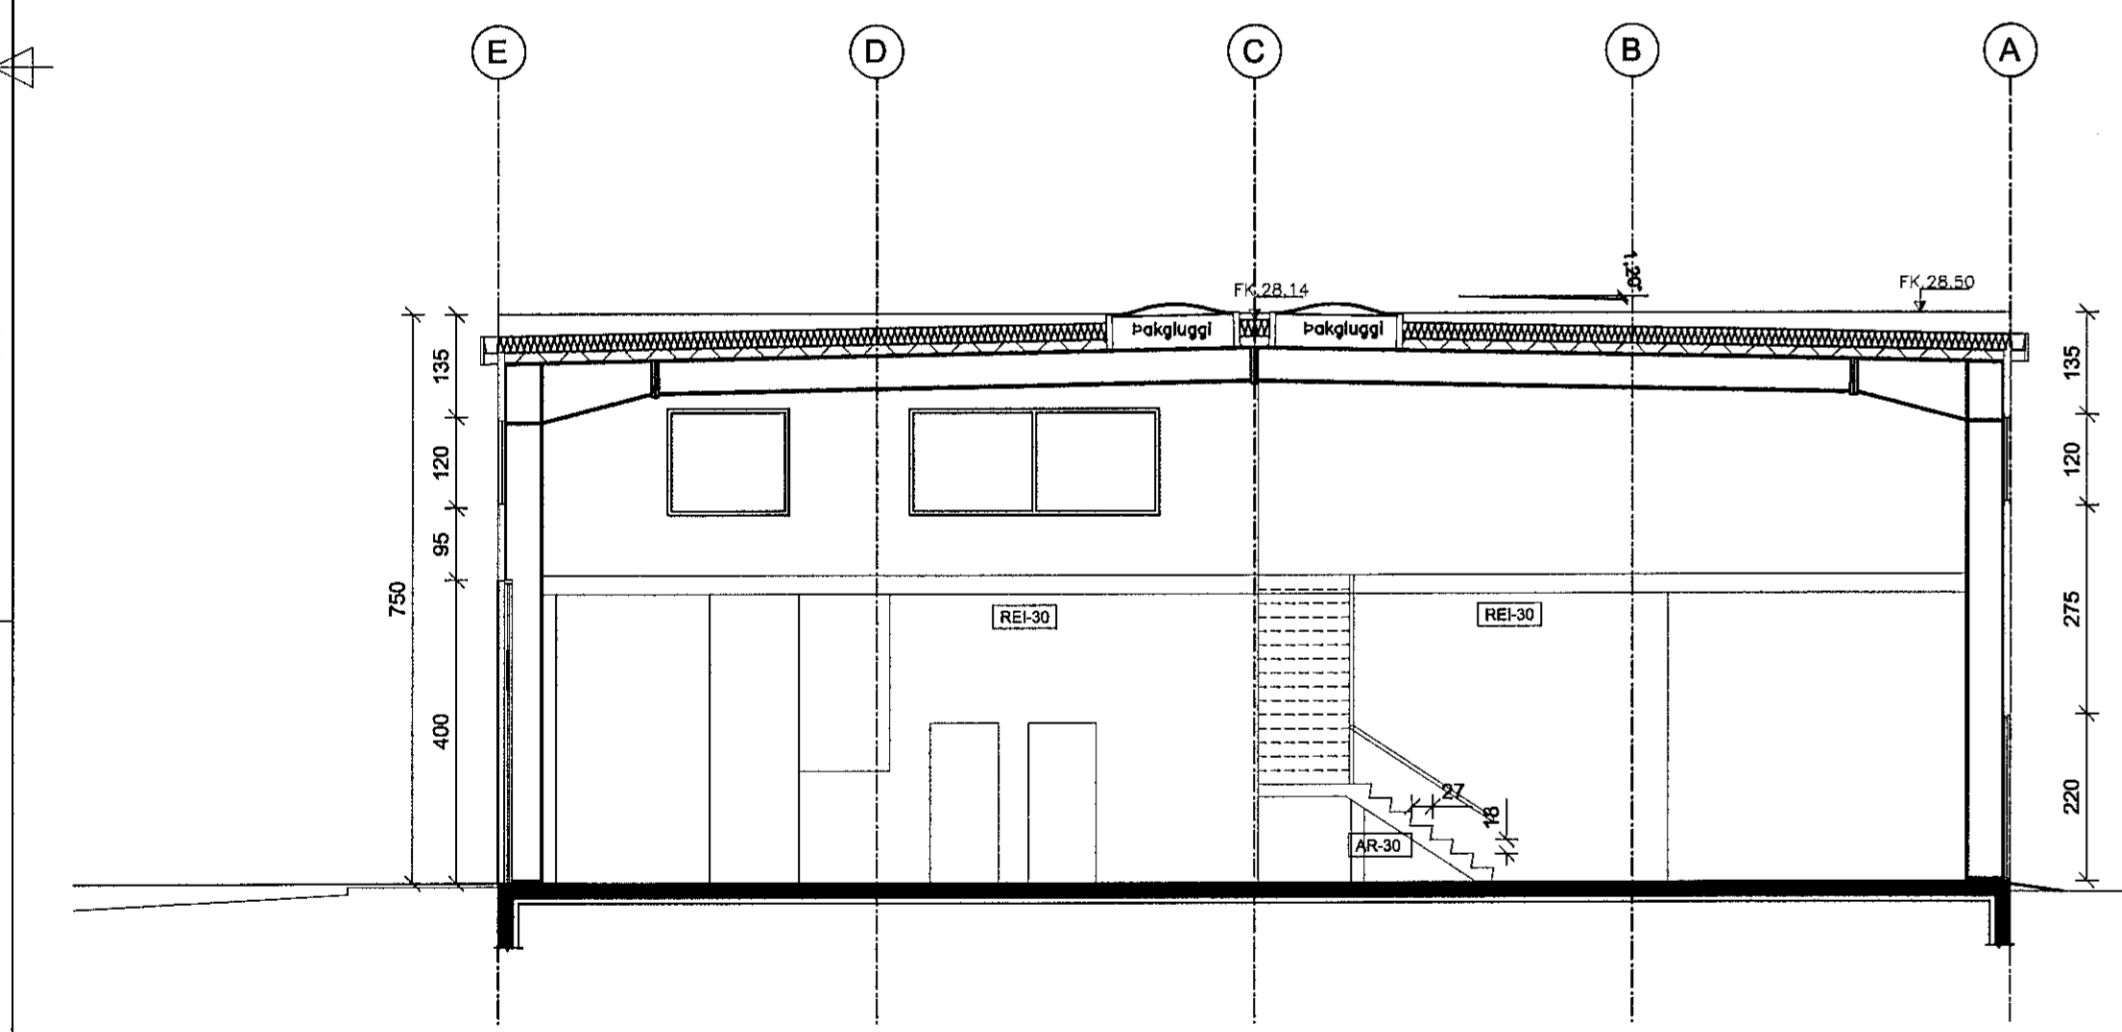

SNID B-B 1:100

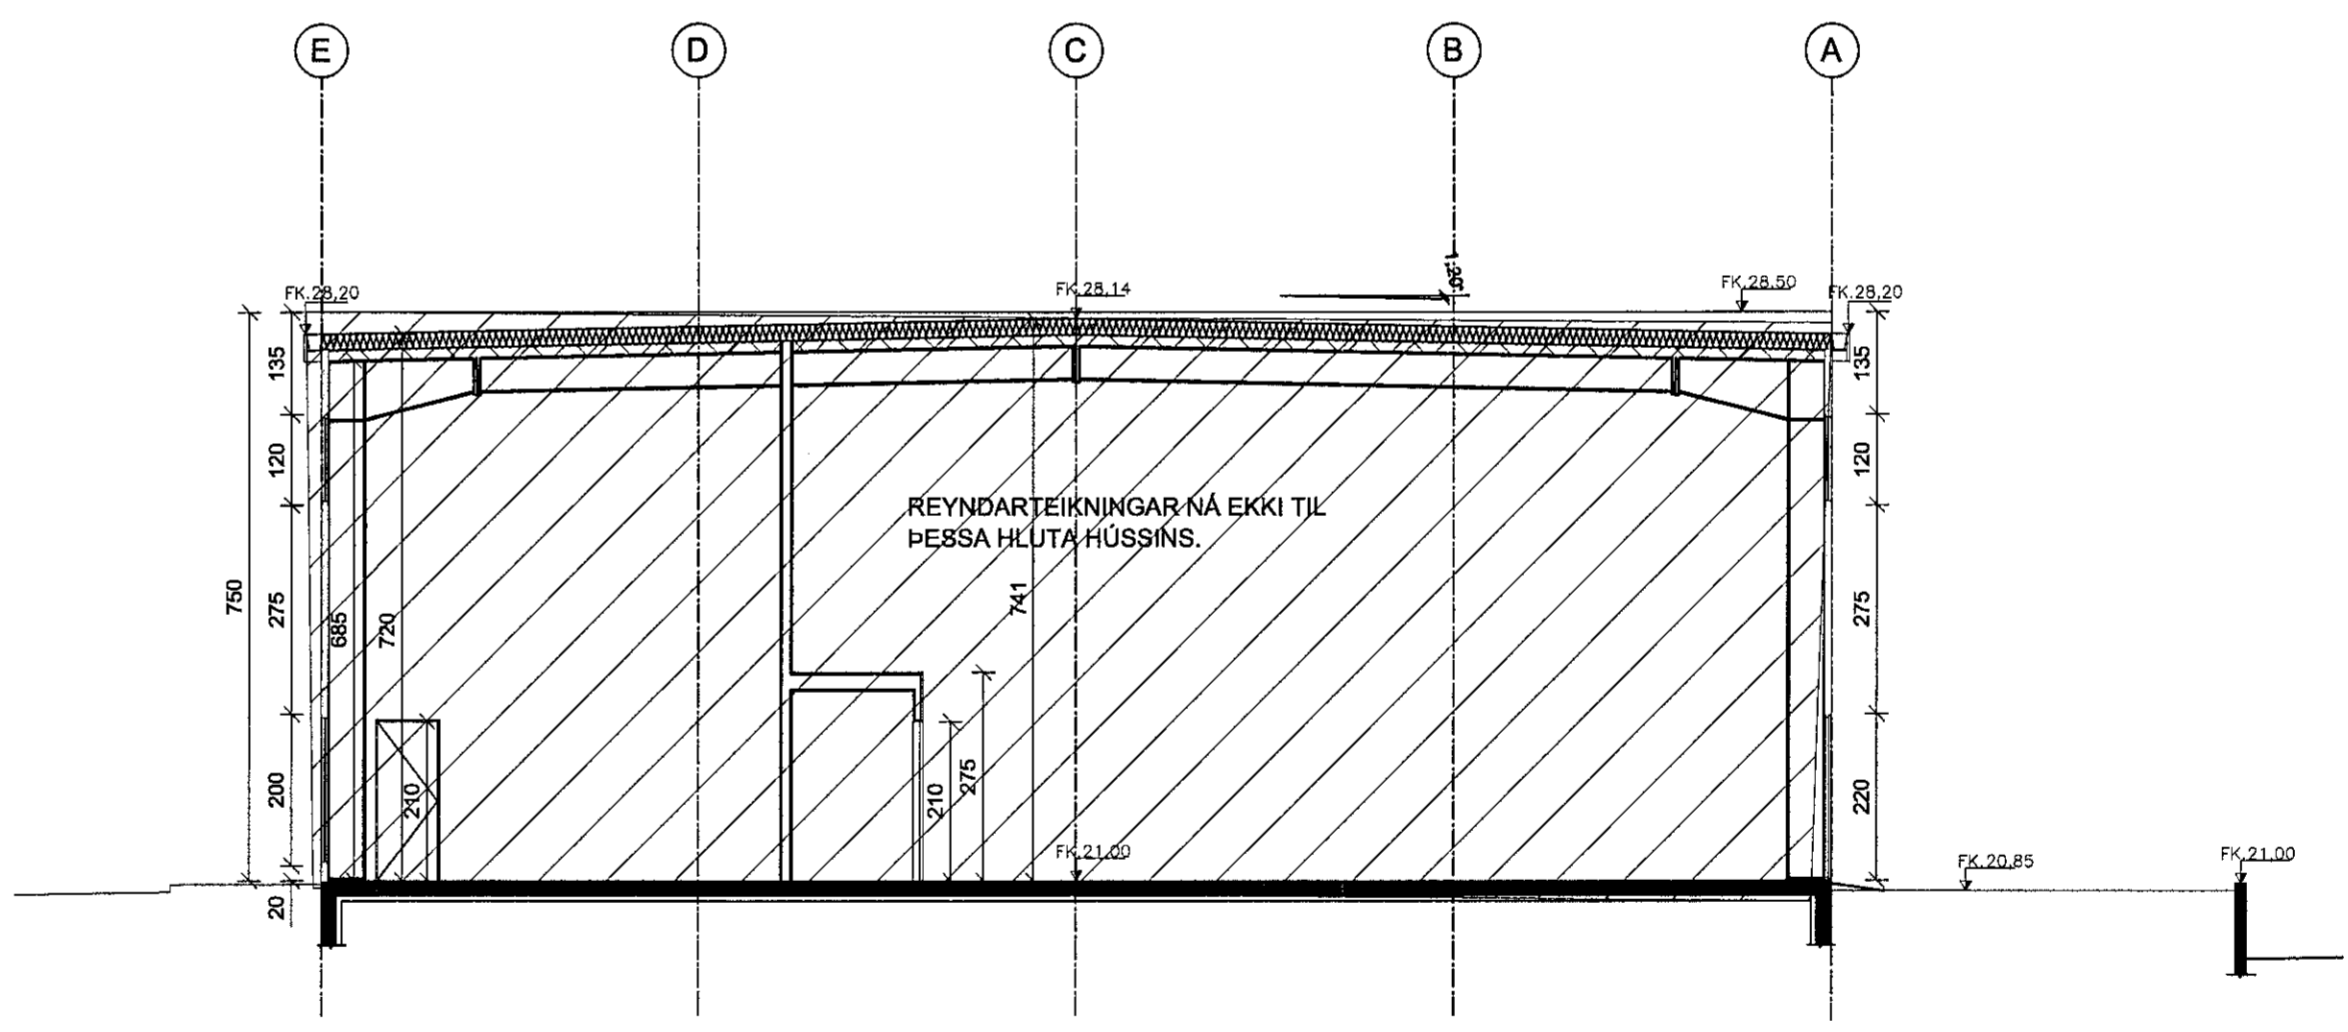

SNID C-C 1:100

Verkfræðistofa Hauks Ásgeirssonar
DALVEGI 18
201 KÓPAVOGUR
SÍMI: 534 8815 / 897 8132
FAX: 534 8818
NETFANG: haukur@vha.is
kt: 560600-3050
HEIMASÍÐA: www.vha.is

HEITI VERKS:
**SUÐURHELLA 7
HAFNARFIRÐI
IÐNÁÐARHÚSNÆÐI
REYNDARTEIKNING**

HEITI TEIKNINGAR:
SNID

MKV: 1:100	DAGS: 10.06.'13	VERK NR: 2050	
TEIKNAD. JSS	YFIRFARID H.Á.	SAMBYKKT H.Á.	NR. TEIKNINGAR
DAGS undirskr. 10.07.20	NAFN HÖNNUÐAR Haukur Ásgeirsson kt. 301255-4629		4
UNDIRSKR. HÖNNUÐAR			ÚTGÁFA B

