


Breytt 06.06.2003: rýmisnúmer, skráningartölur
Breytt 03.09.2002, glerjun svala
BR. 19.05.1995 GRUNNM. ENDAÞEÐA, GLUGGI 'A' NORÐURGAFL
BR. 08.07.1993 SÚLUR STOFA

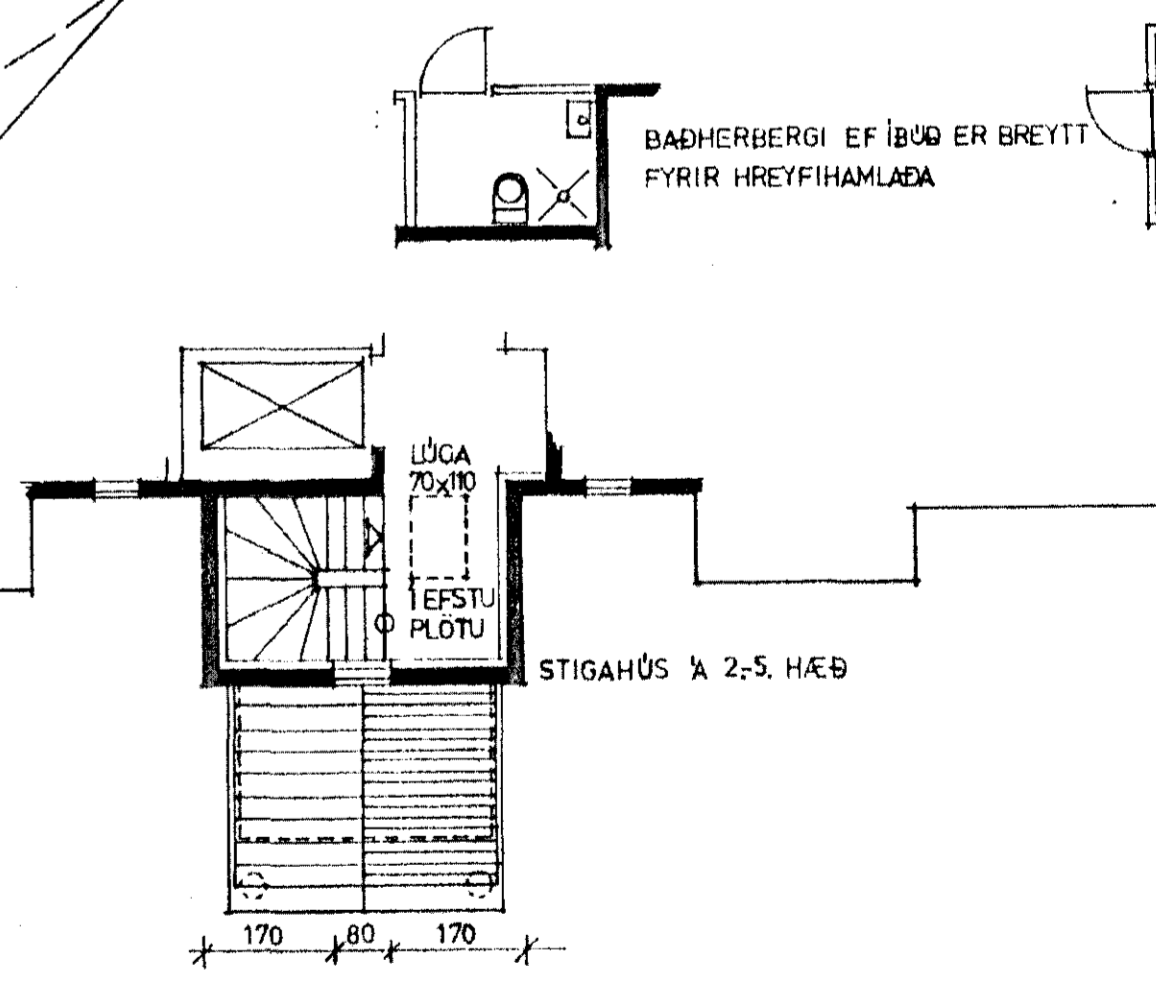

líniþróun Adalsteinsson
HÁHOLT 16, HAFNARFIRÐI

2. útgáfa		BLO3
DAGS. 01.07.2011	MKV. 1:100	HANNAÐ SA/PVB/TEIKN. SA
SIGURÞÓR ADALSTEINSSON, ARKITEKT. PALL V. BJARNASON, ARKITE		

líniþróun Adalsteinsson