


# Úr Gildi

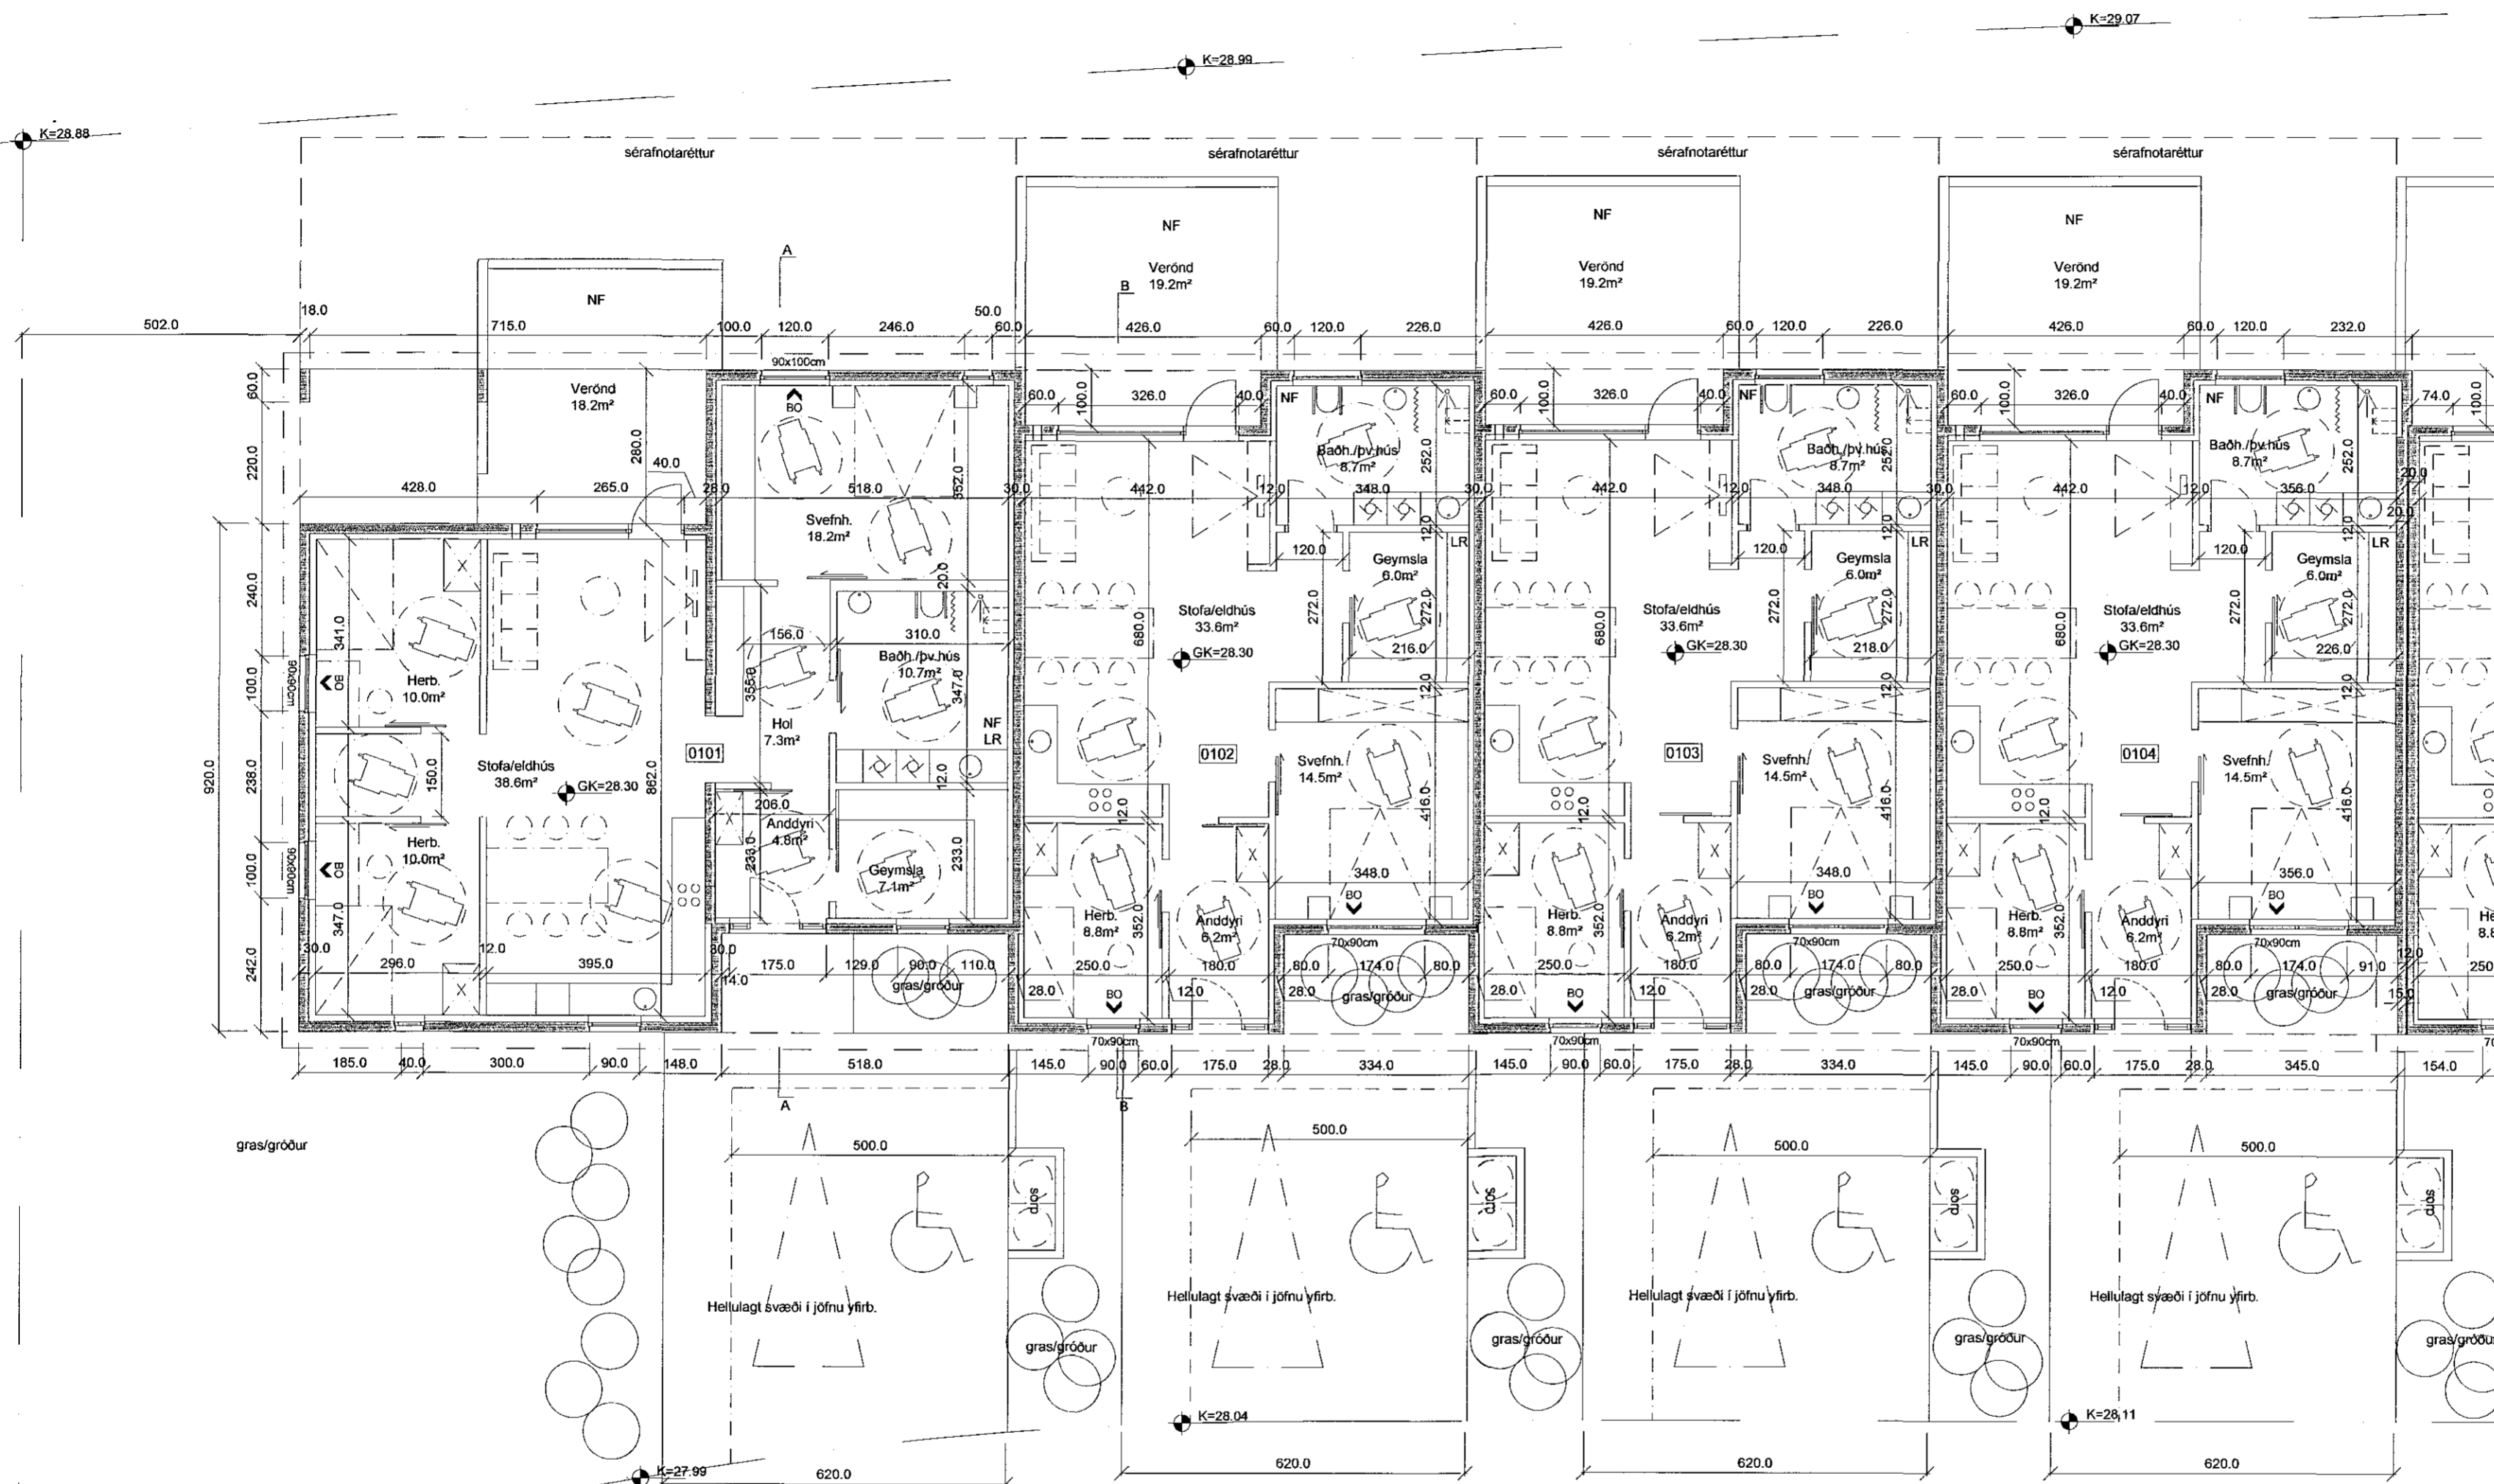

C:		
B:		
A:	Gluggasetning, tvífaldir veggur milli íbúða 0104-0105	23.06.14
BREYTINGAR:		DAGS:
<b>HNOÐRAVELLIR 52-58, HAFNARFIRÐI</b>		
ADALUPPDRATTUR	VERK:	
	KVARÐI:	1:100
GRUNNMYND, 1 AF 2	DAGS:	06.05.14
	TEKNI:	IFC, LME
	SKRÁ:	

*Logi Már Einarsson*  
Logi Már Einarsson arkitekt fal kt. 210864 - 2969

