




# Úr Gildi

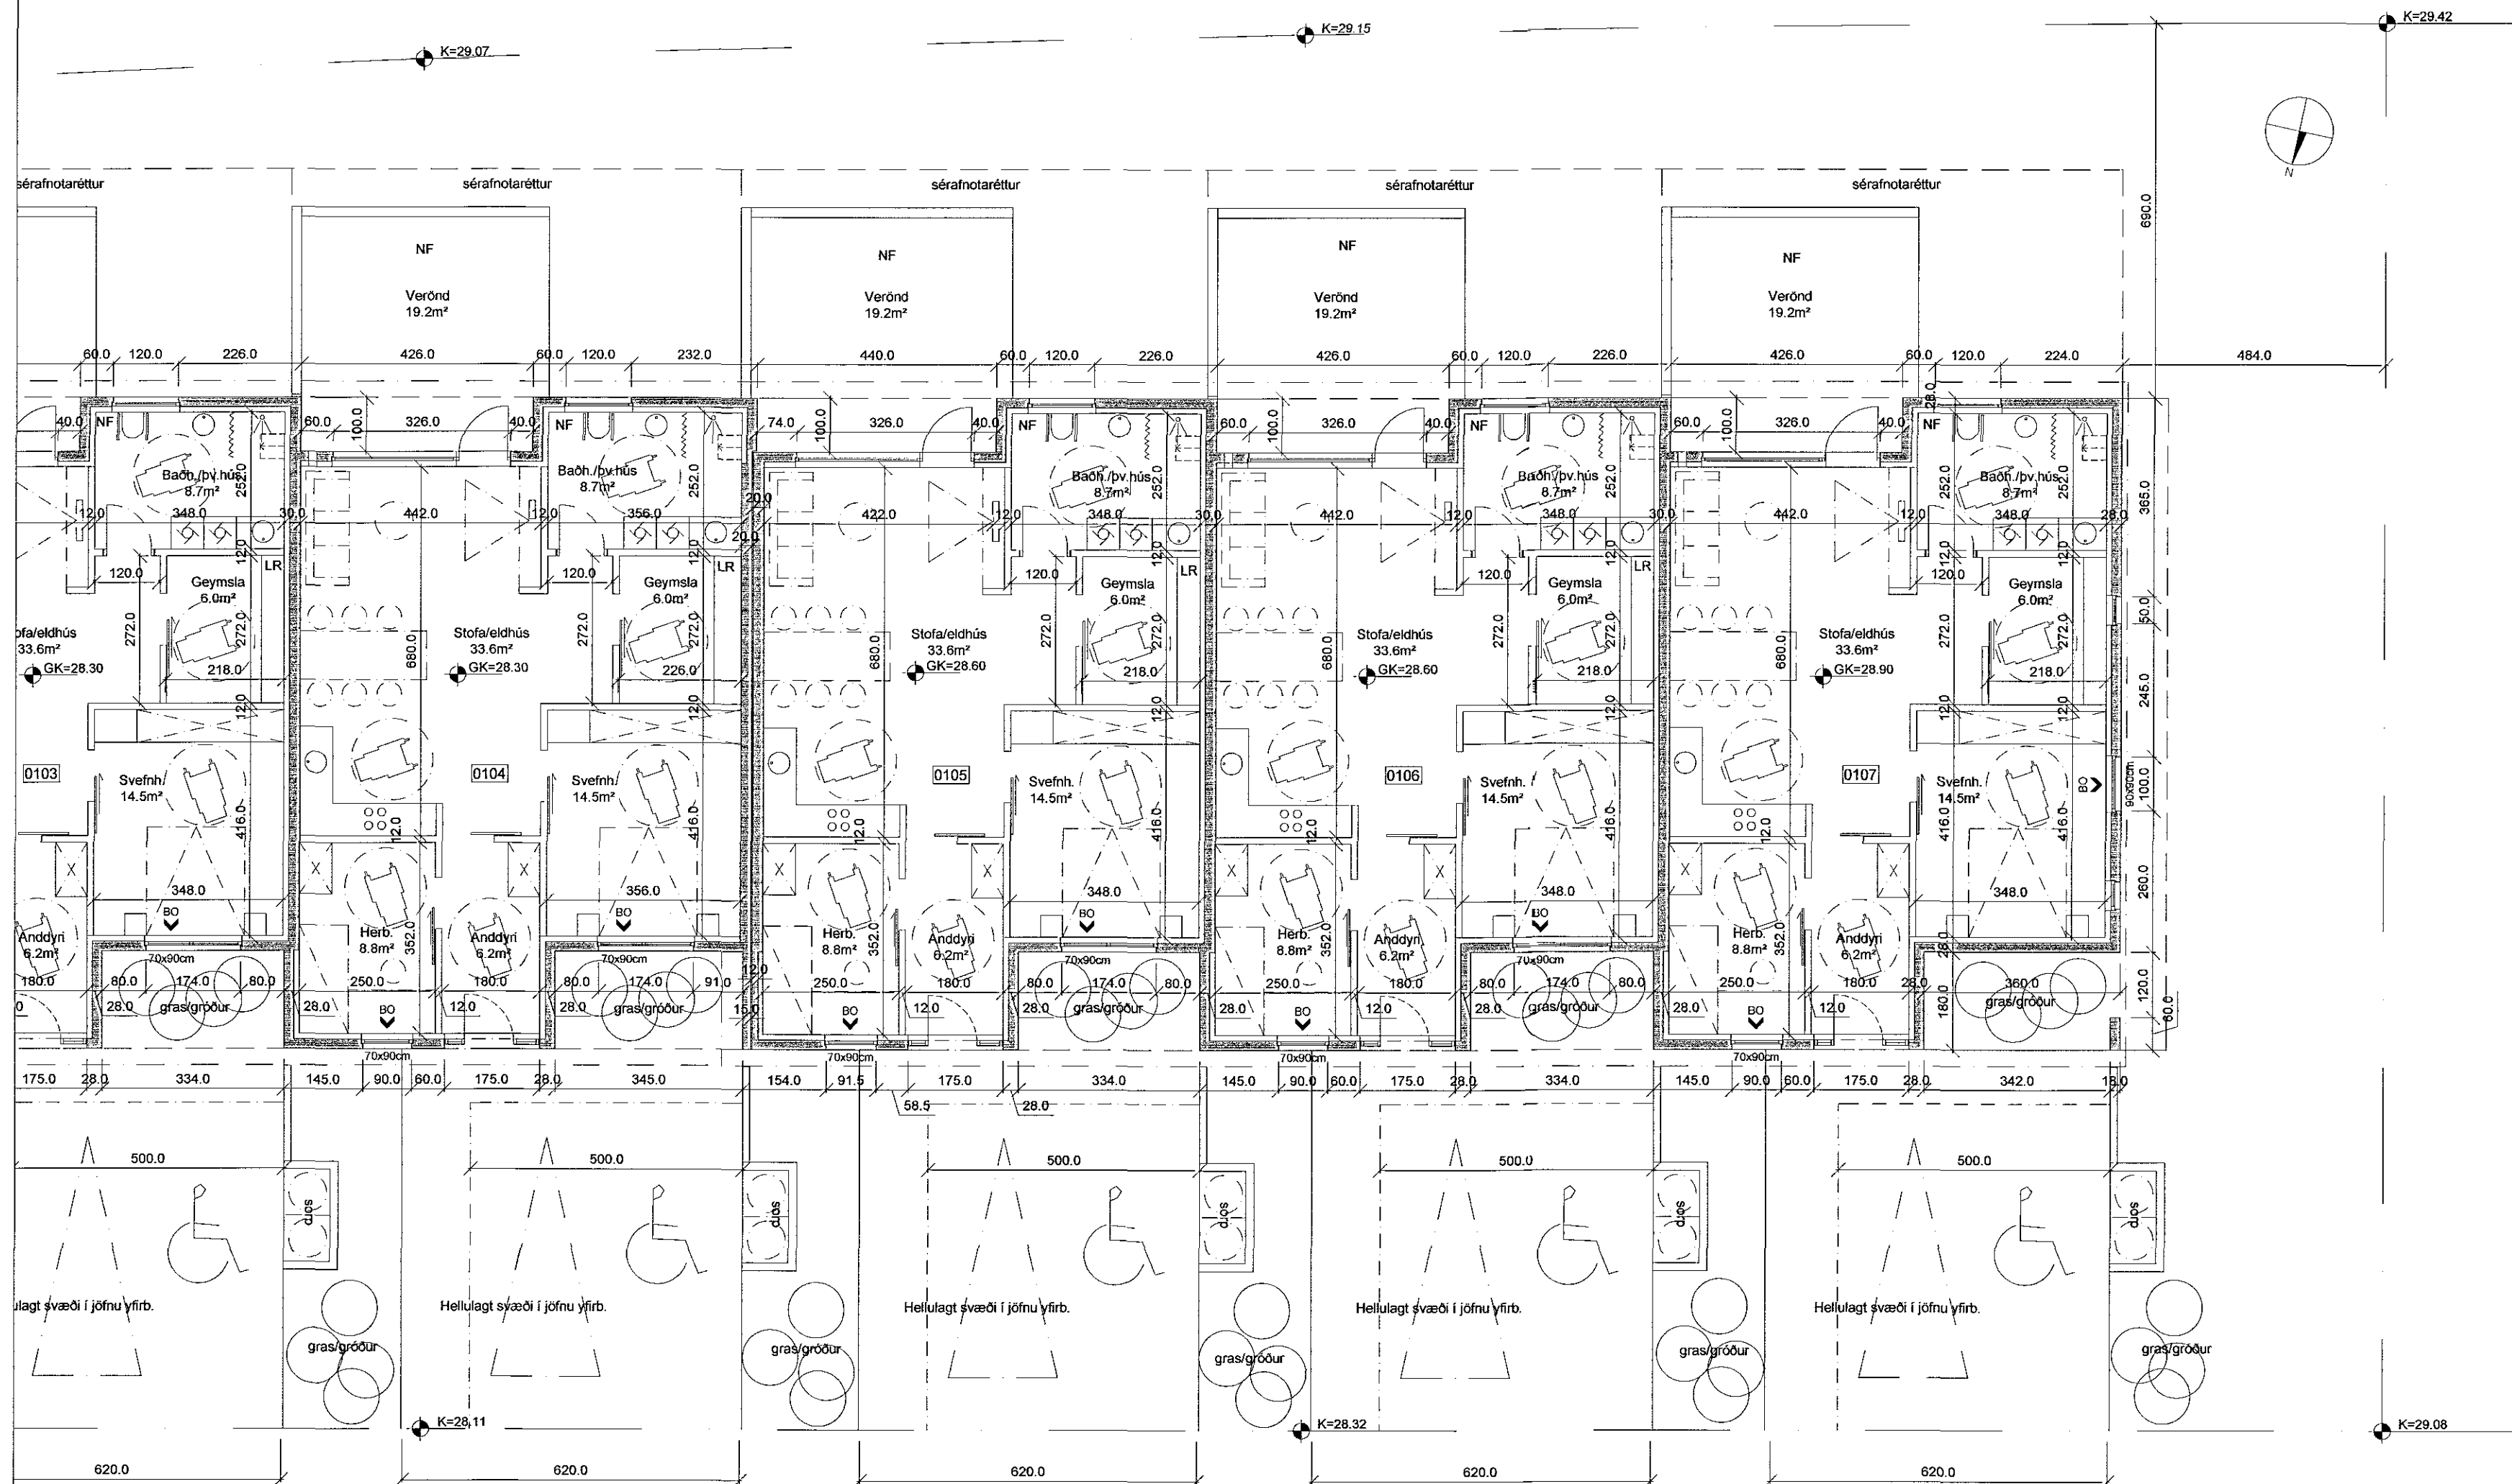

GRUNNMYND 2 AF 2, 1:100

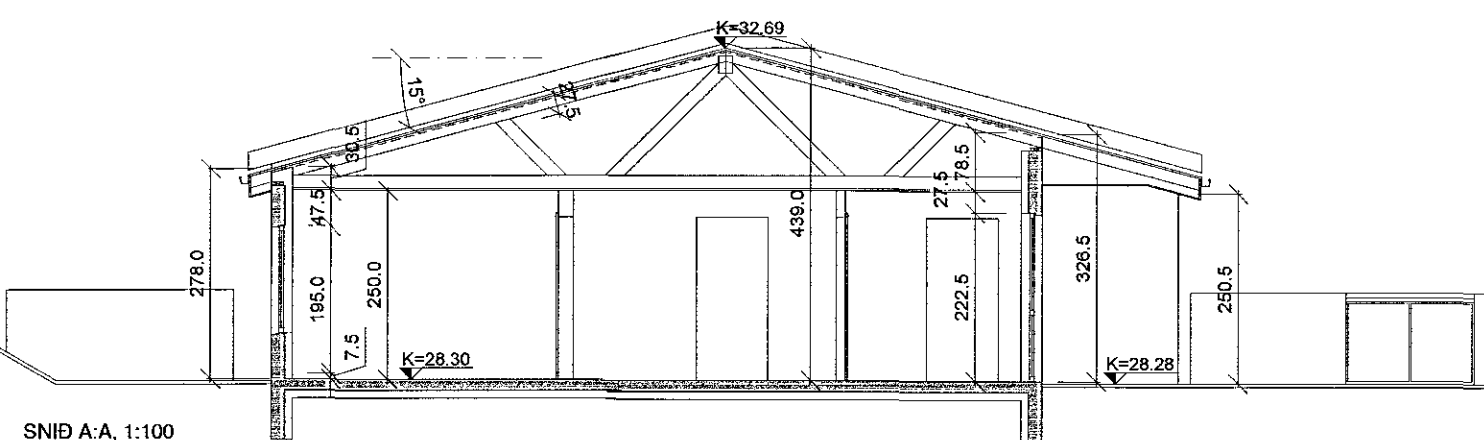


SNID A:A, 1:100

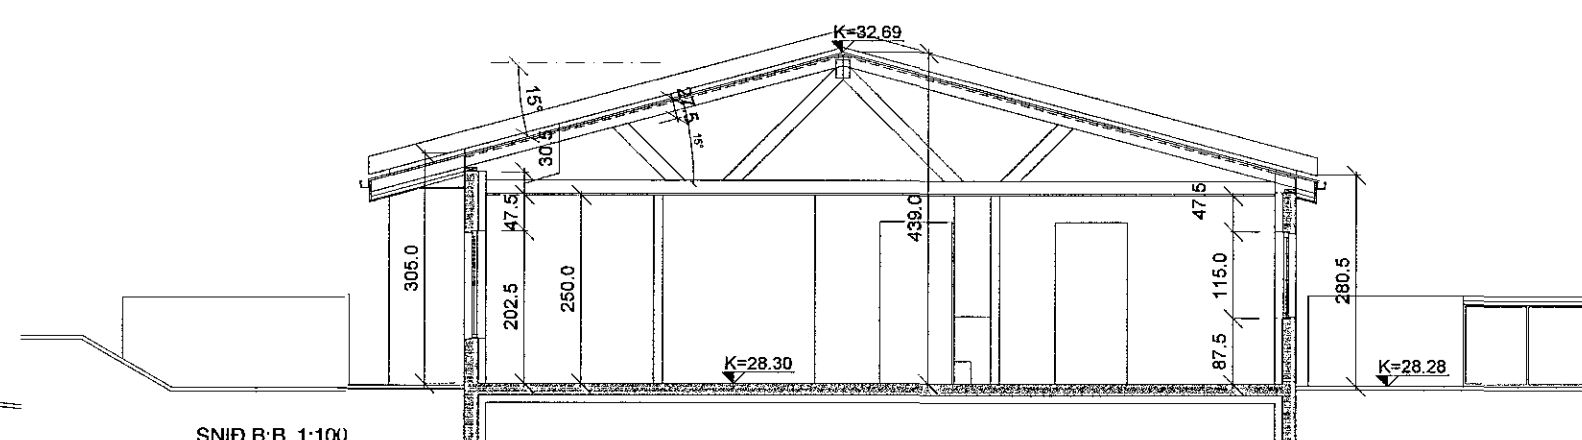

SNID B:B, 1:100

C:	
B:	
A:	Tvöföldur veggur milli íbúða 0104-0105, hæðarskiðun íbúðar 0105 23.06.14
BREYTINGAR:	DAGS:
HNOÐRAVELLIR 52-58, HAFNARFIRÐI	
ADALUPPDRATTUR	VERK:
	KYRDI:
	DAGS:
GRUNNMYND, 2 AF 2	TEIKN:
SNID	SKRÁ:

Logi Már Einarsson arkitekt fal kt. 210864 - 2969

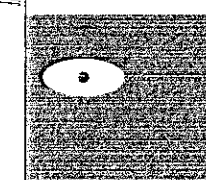

**KOLLGÁTA**  
Kaupvangsstraeti 29 600 Akureyri  
Sími/Fax: 464 7880 - 464 7889  
Netfang: kollgata@kollgata.is