


GRUNNMYND 1:50

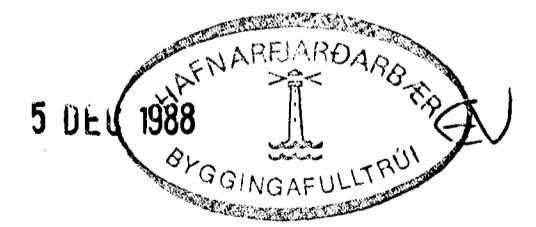

BR. NR.	DAGS	EDLI BREVINGAR	SIGN.
1	NOV 08	BREYTING A' DFNUM, FJÖLGUN FALLPIPA	A. Z.
BÆJARHRAUN 20 HAFNARFIRÐI			DAGS
HITA- VATNS OG FRÆNNISLAGNIR.			OKT 08
MELIKV. 1:50			HAUNAD
SIGURÐUR ÞORLEIFSSON TEKNIFRÆÐINGUR F.T.T.F.			TEIKNAD
SKRANGÖTU 11 HAFNARFIRÐI SÍMI 54151			VERK NR.
			8709
			BLADNR.
			2-07A