


YATNS- OG FRÆRENNISLAGNIR . 1:50

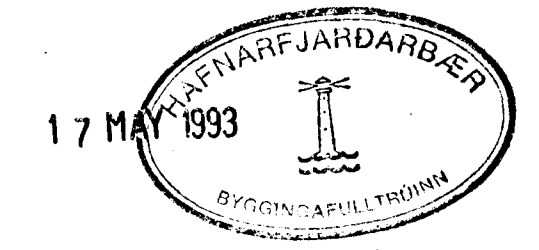

DI	04.05.93	LEGU LAGNA BRESTI	4. V.
BR. NR.	DAGS	EDLI BREVINGAR	SIGN.
BÆJARHRAUN 22 HAFNAKFIÐ			DAGS FEB 93
YATNS- OG FRÆRENNISLAGNIR . RÚMMYND			FAKKAD 4. V.
MELIKV. 1:50			VERK NR 9001
SIGURÐUR ÞORLEIFSSON TEKNIFRÆÐINGUR F.T.E.M.			BLAD NR
STRANDGÖTU 11 HAFNAKFIÐ SÍMI 54151/54255			2-07