


RISHÆÐ. GRUNNMÝND. 1:50

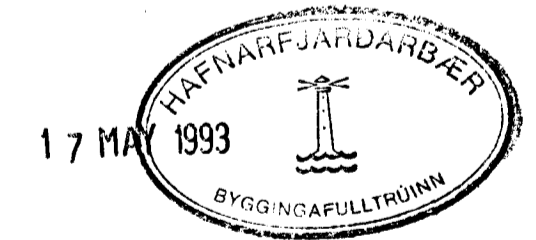

DI	04.05.93	LEGU LAGNA BREYTT	42
BR.NK.	DAGS	EDLI ISREYTINGAR	SIÐN
BÆJARHRAUN 22 HAFNARFIRÐI			DAGS FEB 93
HITA - ÖB VATNSLAGNIR. 3.HÆÐ			WASAL 42
MELIKV. 1:50			TEKNIK 42
SIGURÐUR ÞORLEIFSSON			VERK 42
STRANDGÖTU 11 HAFNARFJÓRÐ			9001
S.M. 5415 210			7 115