


AFSTÖÐUMYND
1:500

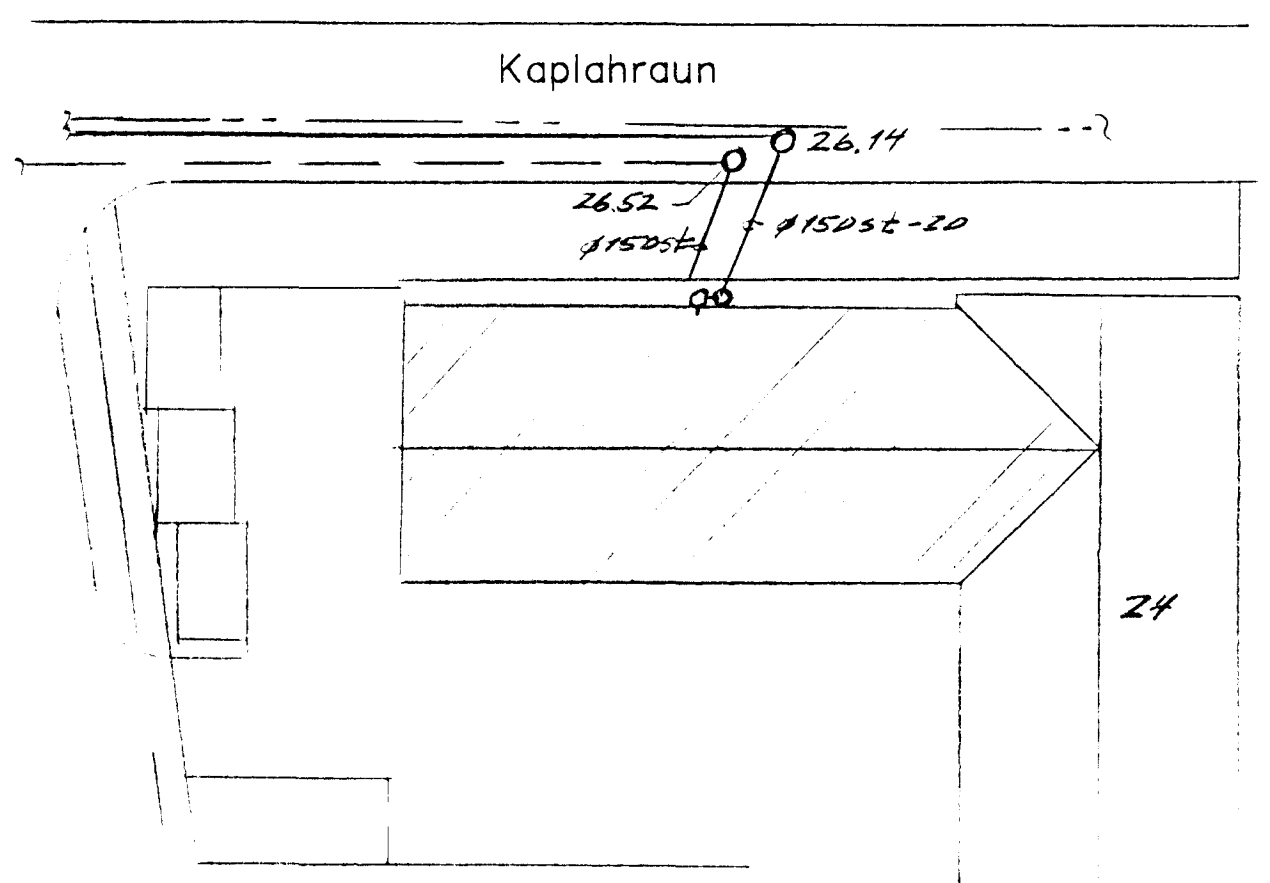

15 MAI 1995

SKYRINGAR:

- VS Vatnssalerni
- HL Handlaug
- GNF Gólfniðurfall /med vatnslás
- S Stútur

		GÓA HF	
		BÆJARHRAUNI 24	
		HAFNARFIRDI	
		GRUNNMYND	
		LAGNIR	
BR.	DAGS.	BREYTING	
TÆKNIÞJÓNUSTAN SF		HANNAÐ O.A.P.	KVARDI 1:100 1:500
LÁGMÚLA 5 - 108 REYKJAVÍK - Sími 5813844 - FAX 5814740		TEIKNAD O.A.P.	DAGS. 5.'95
<i>Sigríður H. Björnsdóttir</i>		YFIRFARIÐ	NR. 41. BL. 11. AF. 11.