



Sambýkkt á fundi bygginga-
nefndar þ. 24. 8. 1994
BYGGINGAFULLTRÚINN
F. HAFNARFIRÐI
Christján Þórn

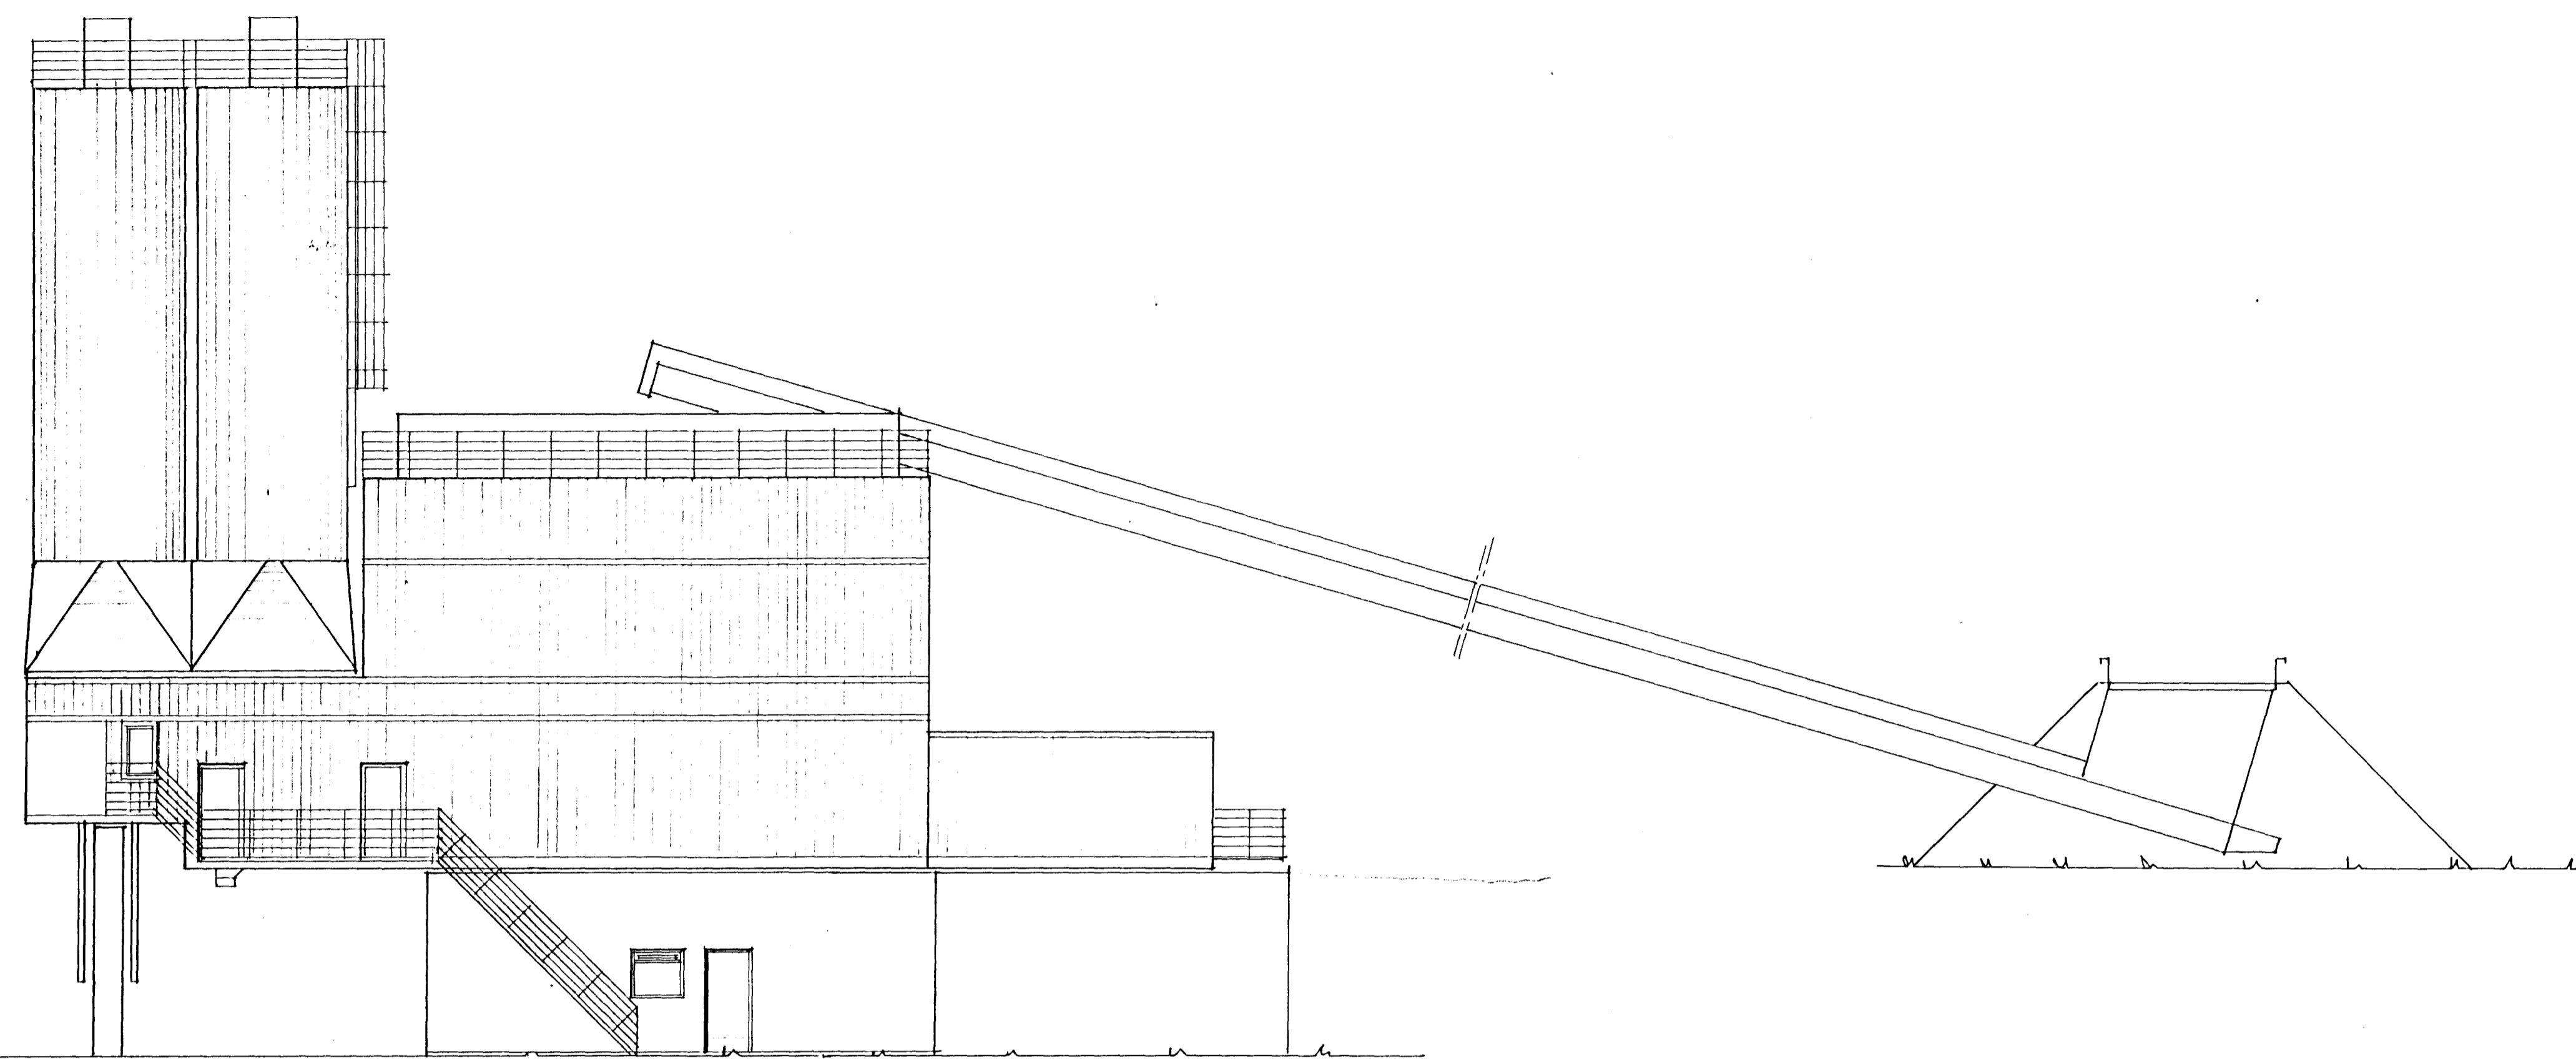


	steypustöð	ransóknarstofa	samtals
Flatarmál	90,1m ²	40,5m ²	130,6m ²
Rúmmál	737,0m ³	202,5m ³	939,5m ³


Útlit norður 1:100

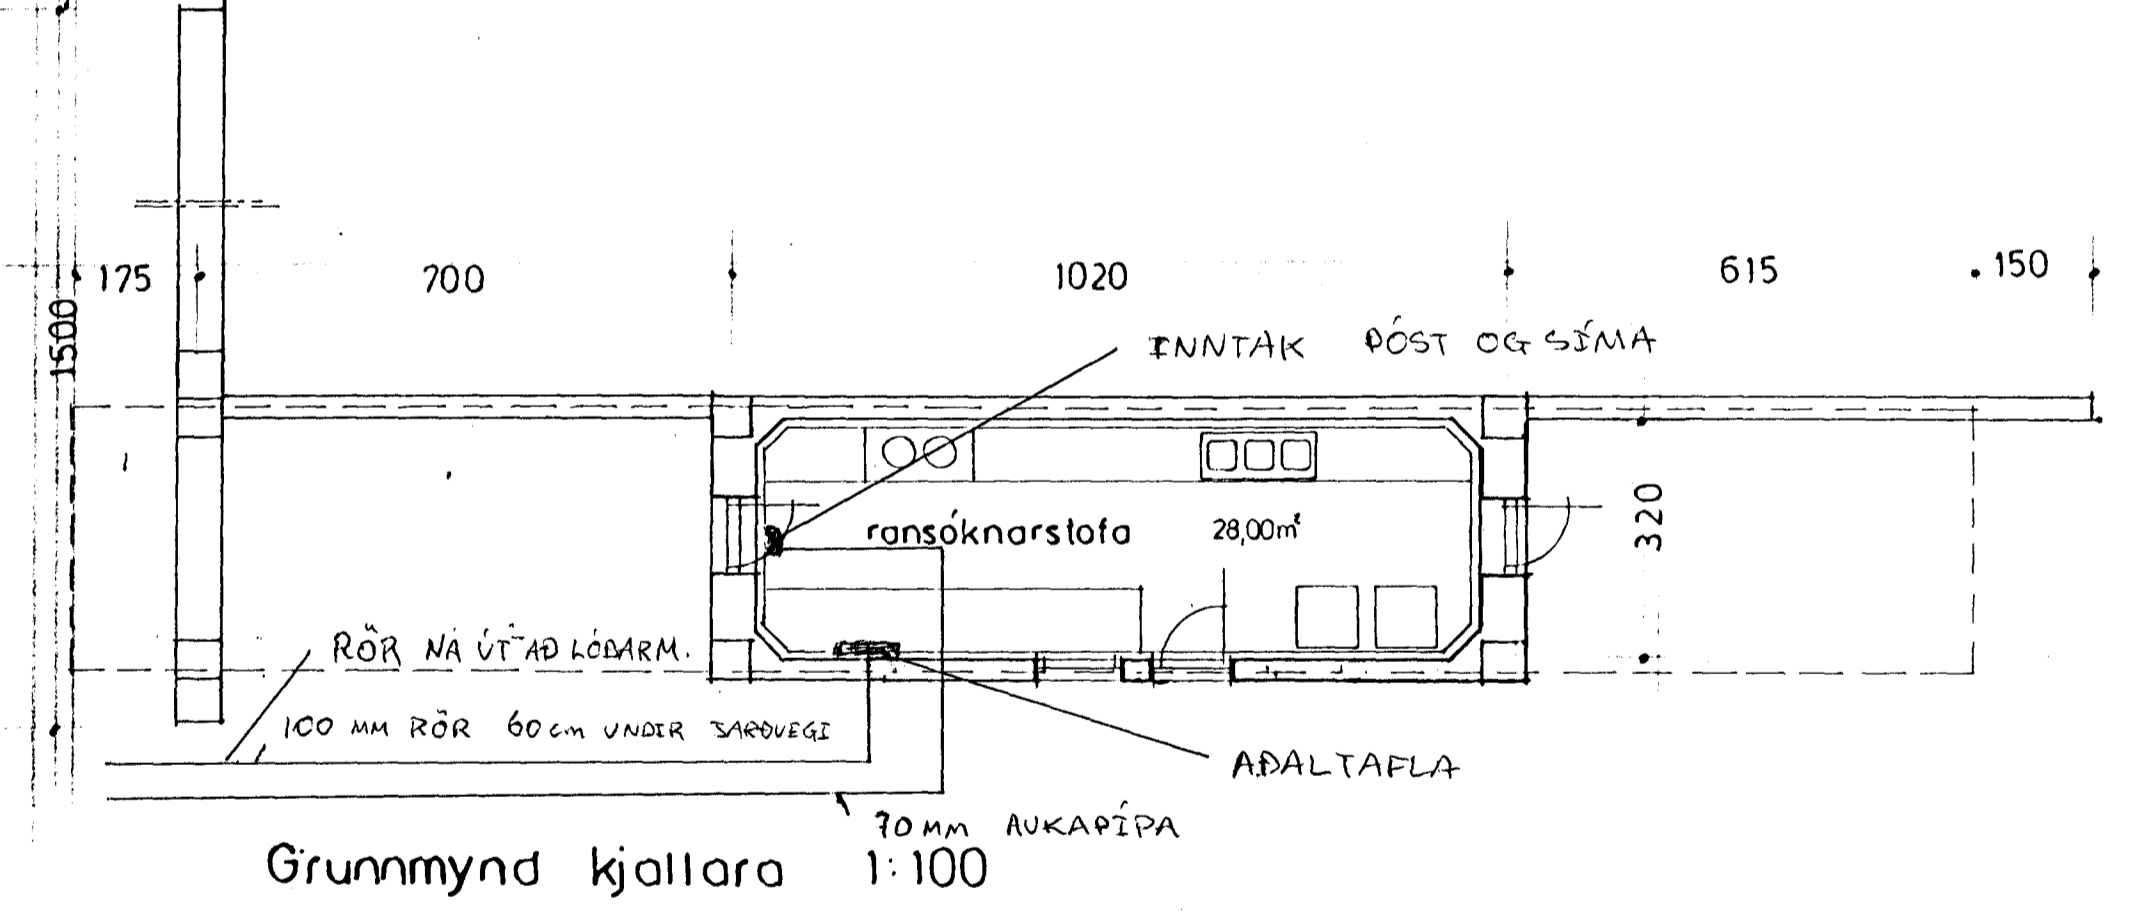

Grunnmynd kjallara 1:100

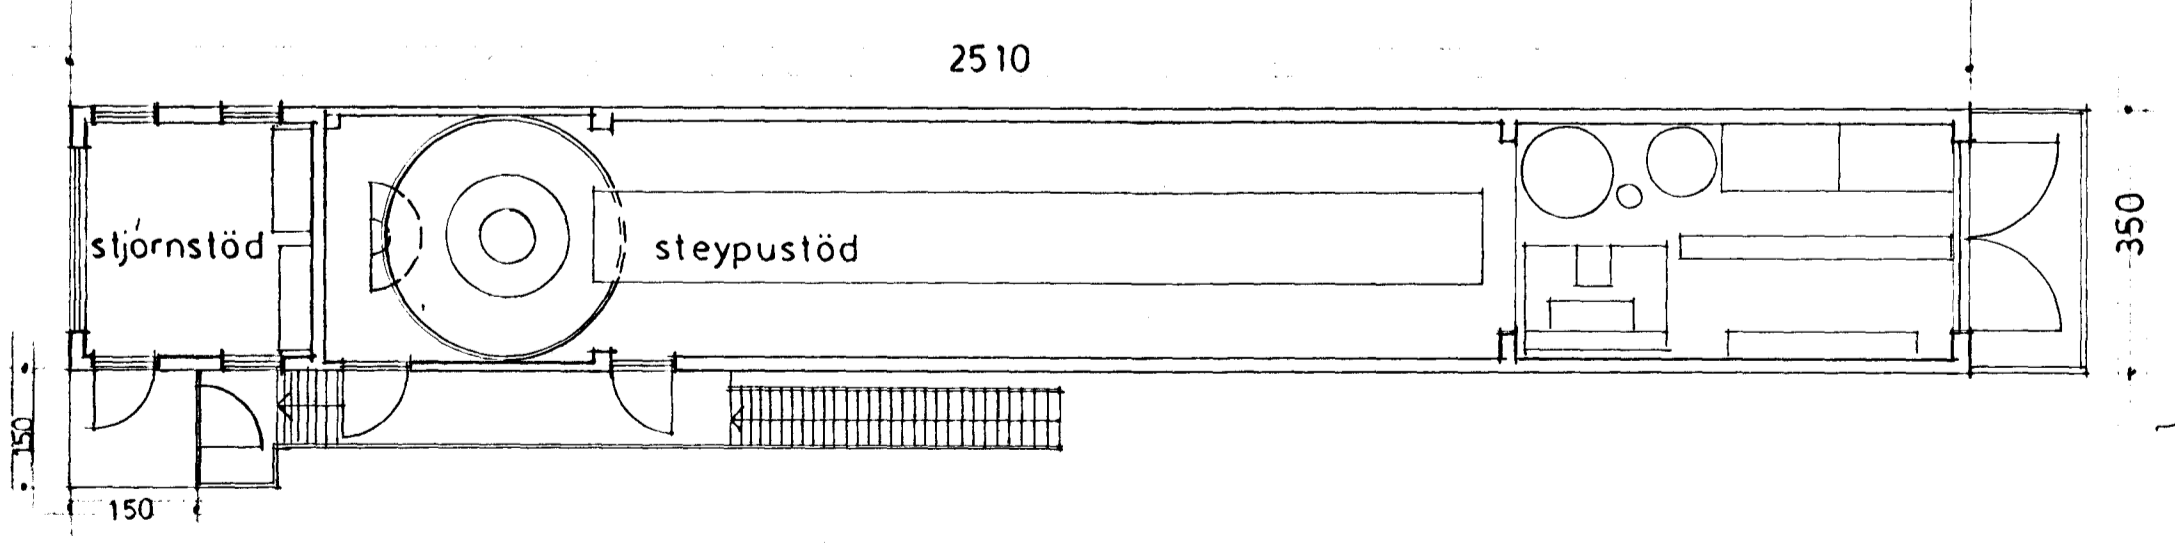


Grunnmynd 1:100

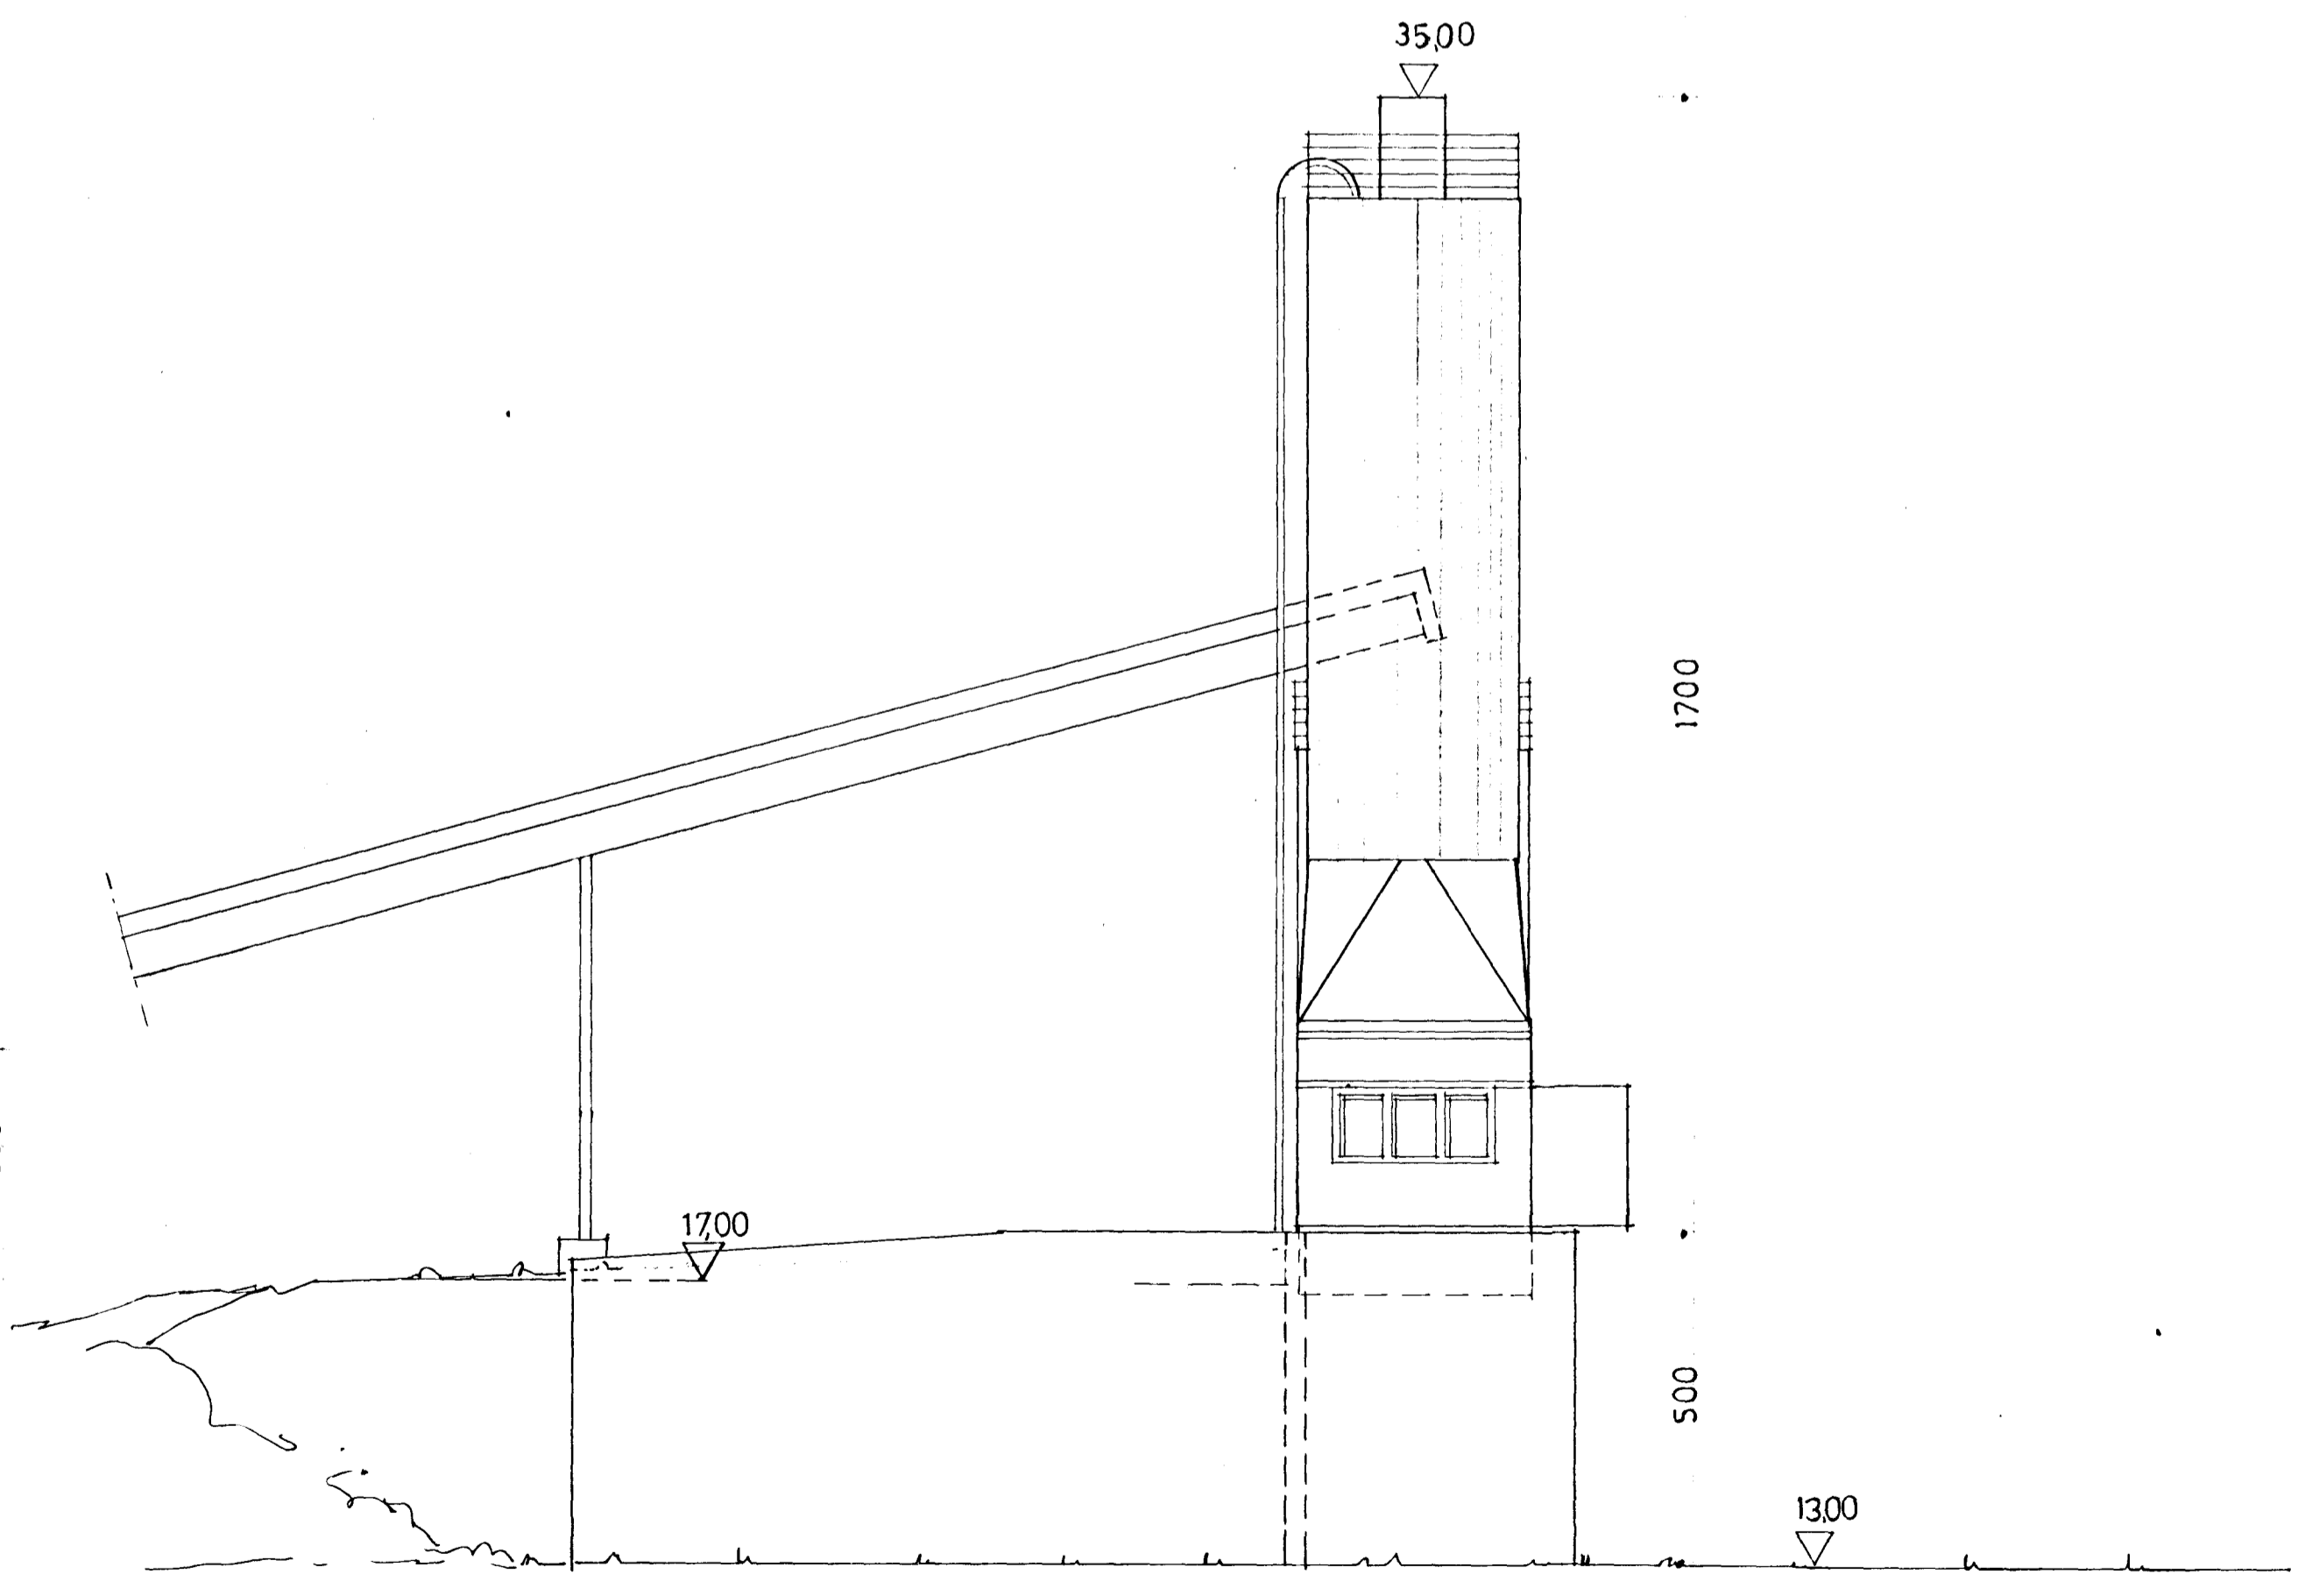

Útlit austur 1:100

BR 15.10.94
BR 02.08.94
BR 25.07.94

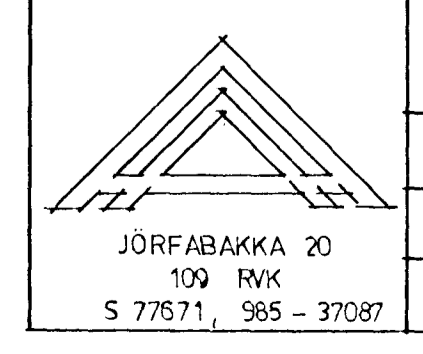

STEINSTEYPAN HF		A 2
Markhelli 7, Hafnarfirdi		
Efni:	steypustöð	
Dags:	05.07.94	Mkv: 1:100
Hannad:	Asgeir Asgeirsson	<i>Asgeir Asgeirsson</i>