


Samþykkt teikning framleiðanda:
 Star Building System teikn. nr. E6
 Sbr. skýrslur VN dags. 16.7./16.8./og 6.9.1999.

Verkfæðistofa Norðurlands ehf
 Akureyri 14.02.2000.

Eiríkur Jónsson verkfr. Adam Traustason verkfr.
 Byggingafræðingur
 Afgreitt þann

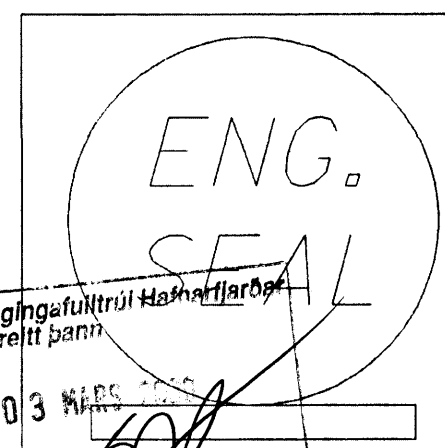

 A RobertsonCeco Company OKLAHOMA CITY, OK 73143 medimur

ATHUGAD: DAGSETNING: SINDRI-STAL HF X AUFANDI
 REYKJAVÍK, ICELAND GAMATHJONUSTAN
 HAFNARFJORDUR, ICELAND

TEIKNING EKKI KVARDA

MBMA
 teikning nr. E6