


HLIDARMYND "4"
BYGGING "B"

Samþykkt teikning framleiðanda:
Star Building System teikn. nr. E8
Sbr. skýrslur VN dags. 16.7./ 16.8./ og 6.9.1999.

Verkfæðistofa Norðurlands ehf
Akureyri 14.02.2000.

Eiríkur Jónsson Eiríkur Jónsson verkfr.
Adam Traustason Adam Traustason verkfr.

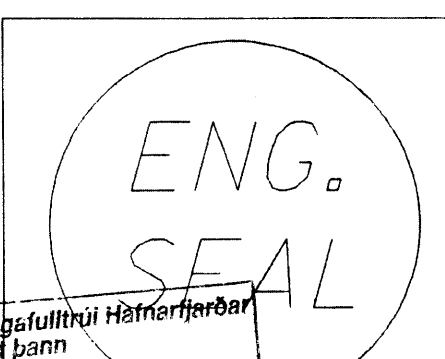

						STAR BUILDING SYSTEMS <small>A RobertsonCoco Company</small> P.O. BOX 9498 OKLAHOMA CITY, OK 73143 (405) 636-2010		99-5797	
				SINDRI-STAL HF REYKJAVIK, ICELAND		KAUFANDI GAMATHJONUSTAN HAFNARFJORDUR, ICELAND			
				ATHUGAD DAGSETNING: TEIKNING EKKI KVARDA		03 MADE IN ICELAND Sigurbjartur Halldorsson		TEIKNING NR. E8	