




Samþykkt teikning framleiðanda:
 Star Building System teikn. nr. E9
 Sbr. skýrslur VN dags. 16.7./16.8./ og 6.9.1999.
 Verkfræðistofa Norðurlands ehf
 Akureyri 14.02.2000.
 Eiríkur Jónsson verkfr.
 Adam Traustafson verkfr.
 03 MAR 2000

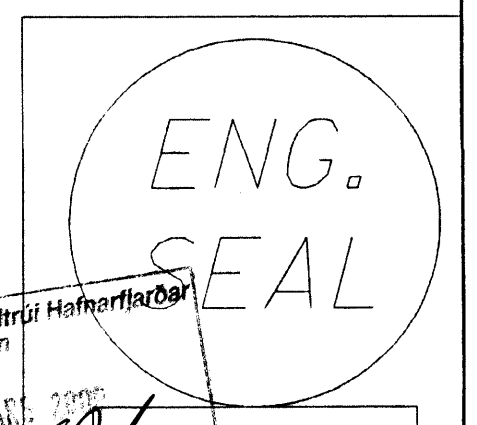

		 STAR BUILDING SYSTEMS <small>A RobertsonCeco Company</small>		VERK NR: 99-5797
		SINDRI-STAL HF REYKJAVIK, ICELAND	Kaupandi GAMATHJONUSTAN HAFNARFJORDUR, ICELAND	 TEIKNING NR: E9
ATHUGAD	DAGSETNING	P.O. Box 10000, Oklahoma City, OK 73143 (405) 636-2010		
TEIKNING EKKI KVARDA				