



GRUNNMYND 4. HÆÐAR

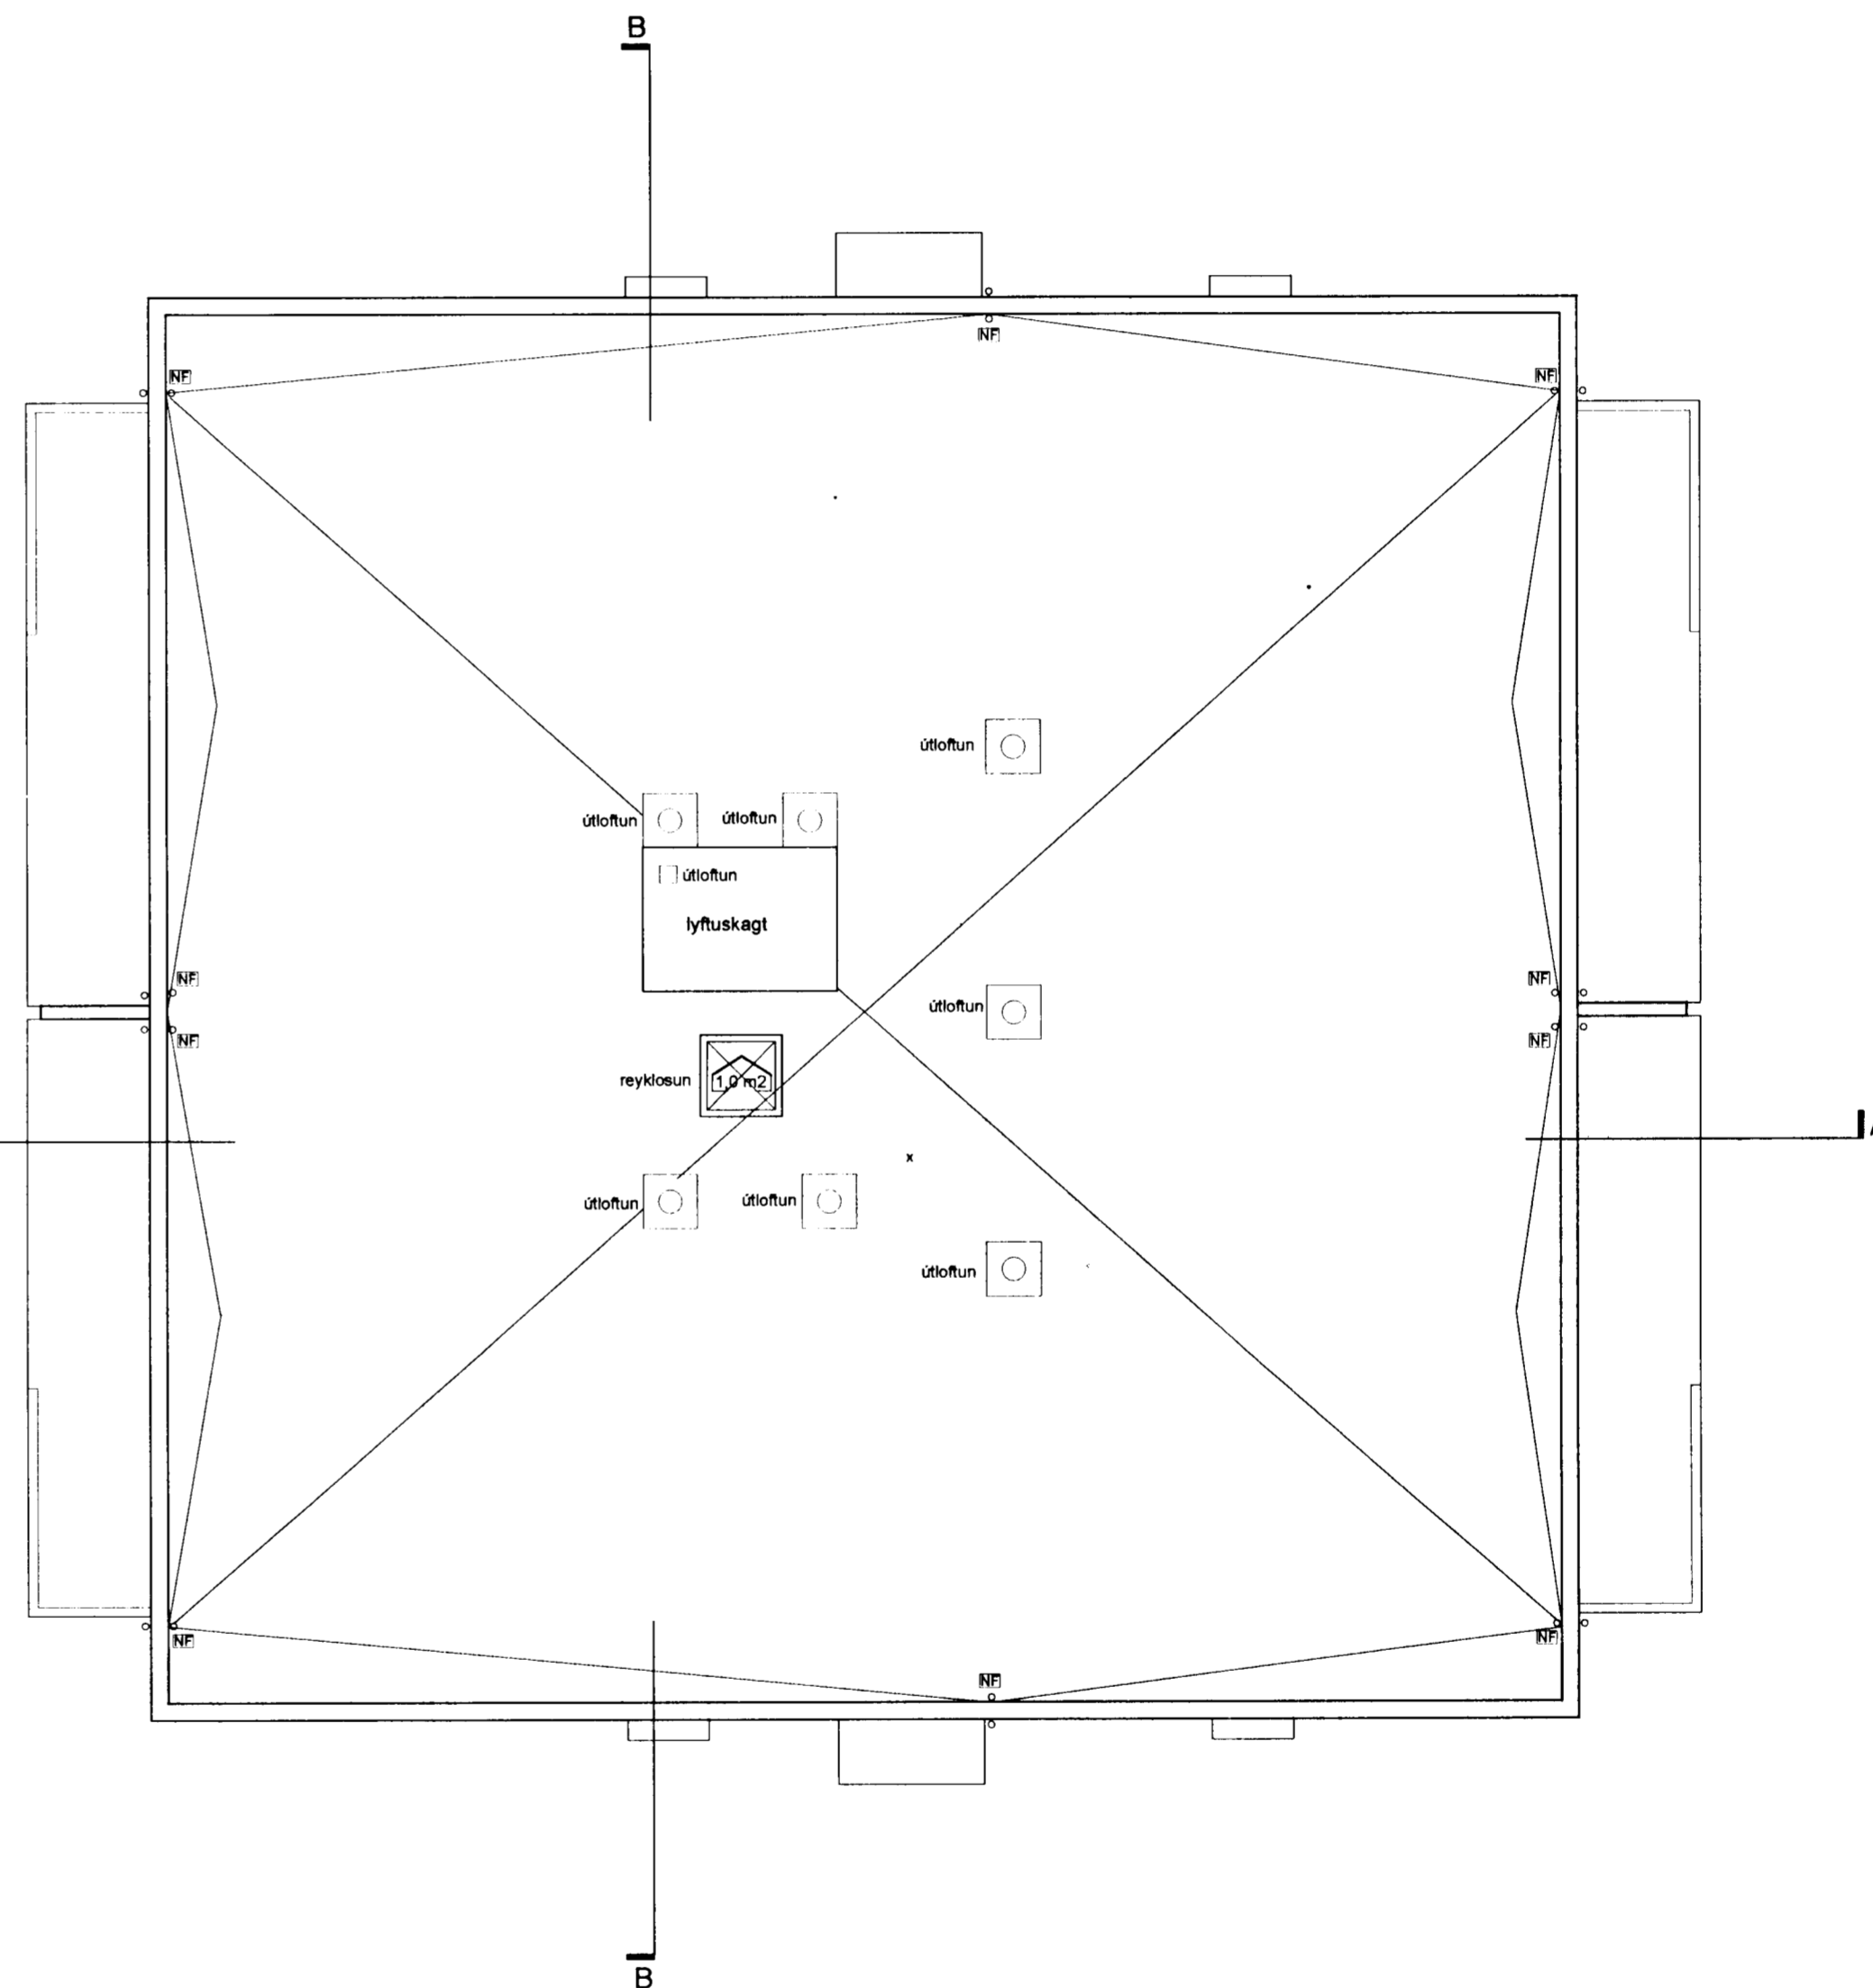

GRUNNMYND ÞAKS

BREYTINGAR

nr.	dags	lýsing
A	25.4.05	breyttar brunamerkingar

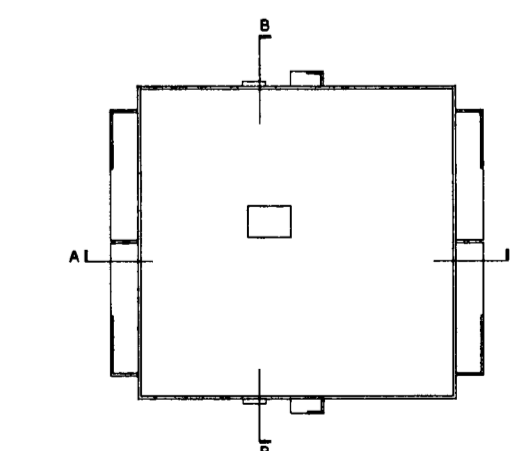

29/4/05

BERJAVELLIR 1 HAFNARFIRÐI

ADALUPPDRATTUR	VERK:
	O4-020
GRUNNMYND	KVAÐI: 1:100
4 HÆÐAR OG ÞAKS	D.A.G.S.: 22.02.05
	TEIKN: ÖSIG
	TEIKN NR.: 103

funk's
Tæknistofa Dinghottstræti 27 101 Reykjavík
Sími: 552 6440 fax: 552 7661 email: funk@funk.is
Anna Kr. Hjartardóttir arkitekt fal. kt. 150956-5989
Afr Már Lúðvíksson arkitekt fal. kt. 060958-6459
Ómar Sigurbjörgsson inn.ark. th. kt. 260958-4969