


SNID E-E: GÖLFFLATAN MĀ HVILA BEINT
Ä SÖLUUNDIRESTÖDUNNI (FÖTIN 80x80).
MĀ ÞĀ SLEPPA 2.5 CM STALLIN NEÐST
Ä SÖLUNNNI. BROTTUA LIÐAN T SNID O-O
Ä ÞĀ VIED.

14 SEP 1989

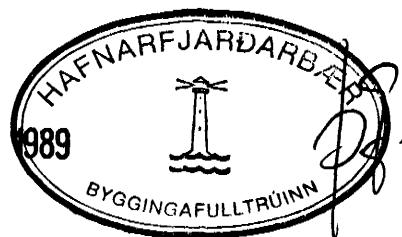

BIRKIBERG NR. 40
HAFNARFJARDI Í OKTOBER 1988
ARNAÐHEÐUNN 47, 651412

UNDIRESTÖDUR
SÉRMUNDIR
Jóhann Magnússon RXI

2.