



SNID V1 - V1 1 : 50

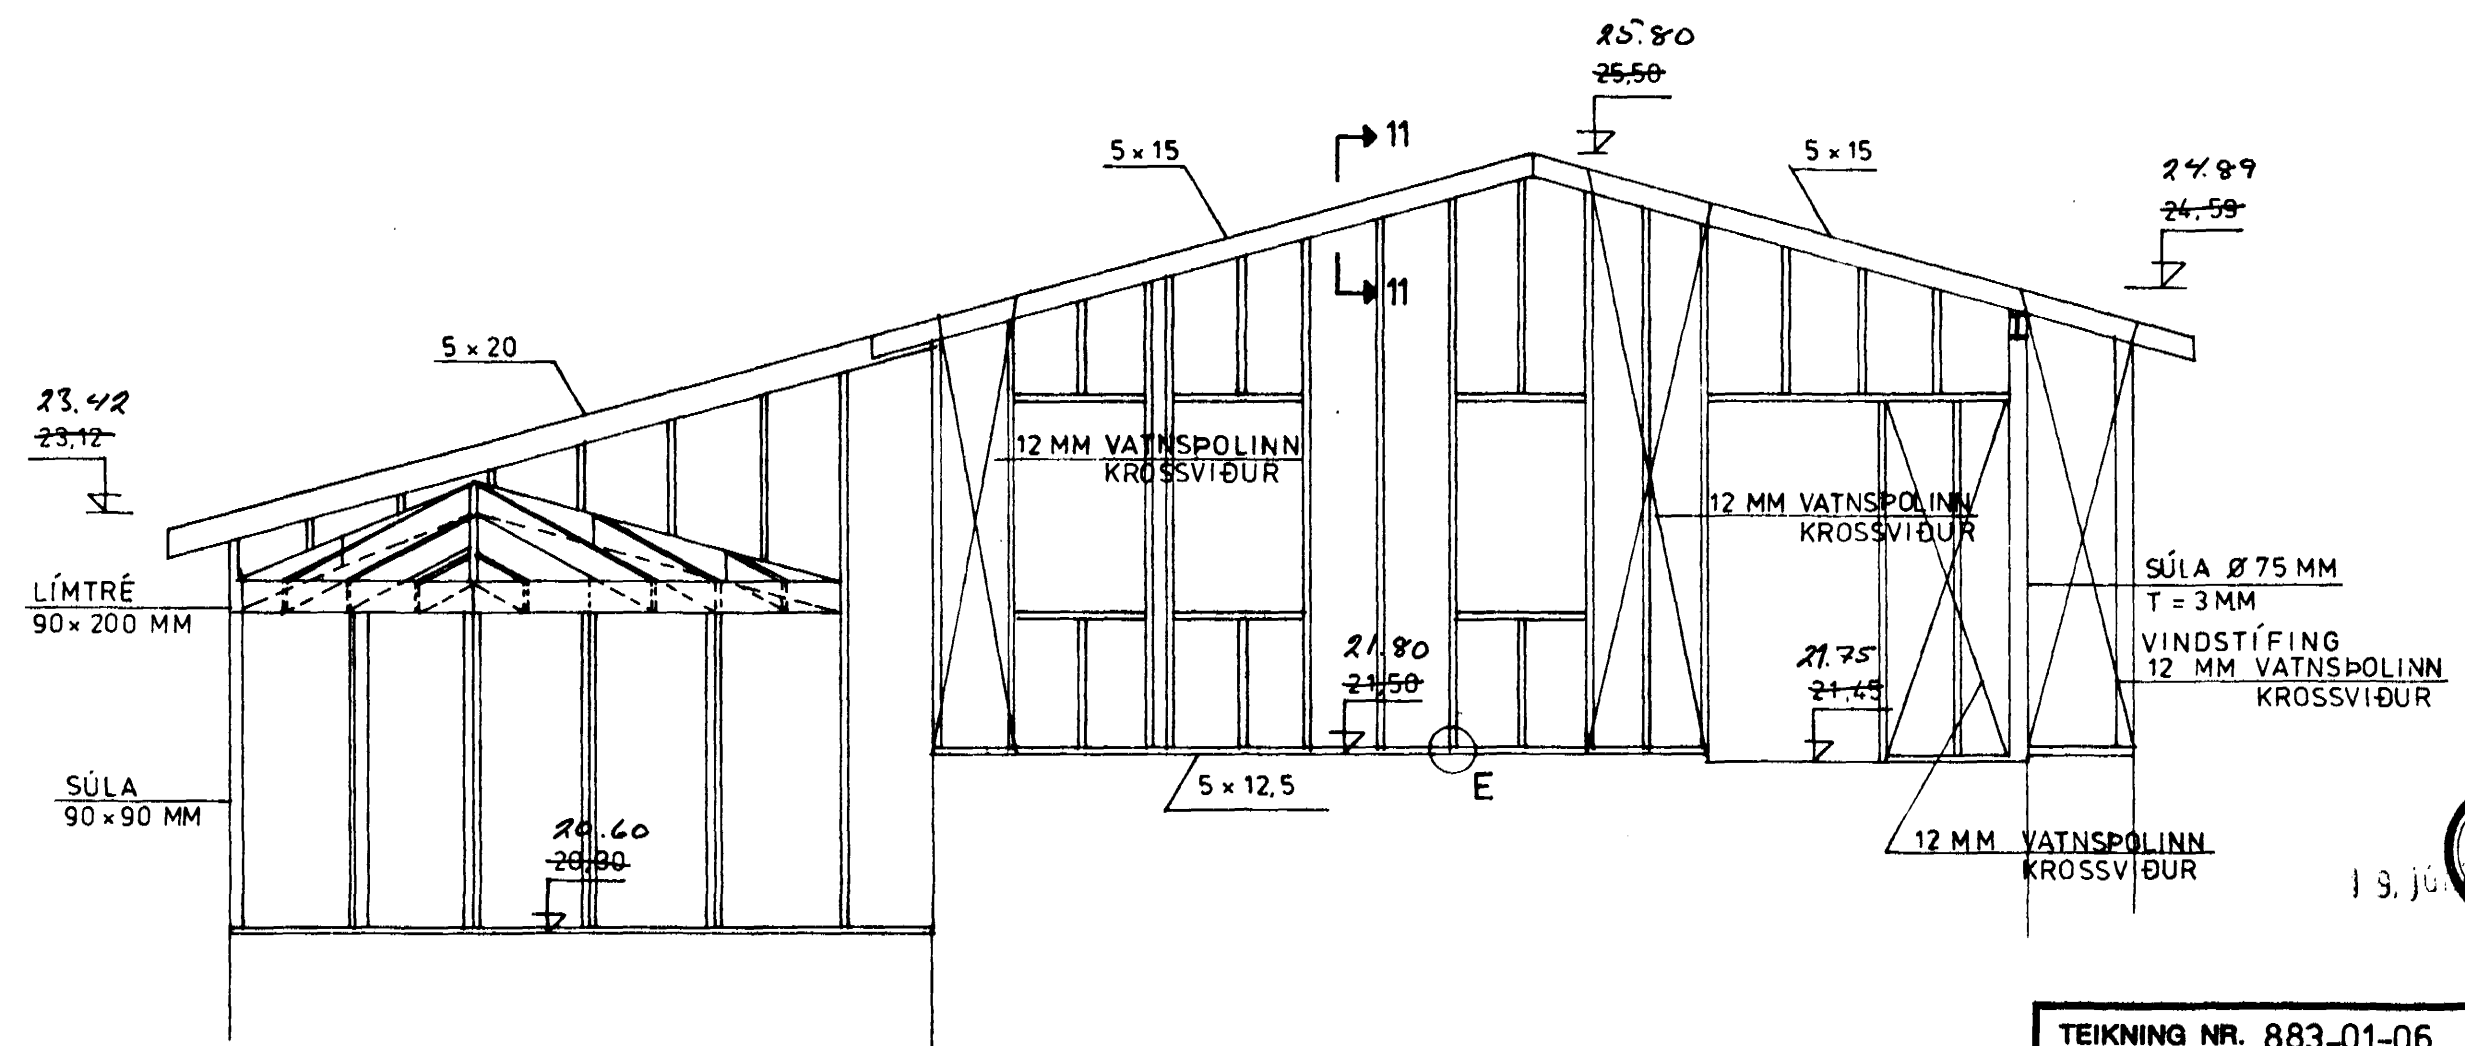

SNID V2 - V2 1 : 50

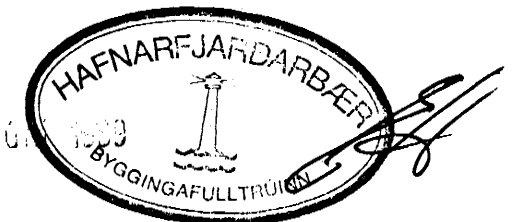

TEIKNING NR. 883-01-06	DAGS	NAFN	YFIRF
BIRKIBERG 4	Mælt:		
HAFNARFIRÐI	Hannað:	MÁI'89 K.K.	IKK
	Telmað:	MÁI'89 S.E.K.	
ÞAKVIRKI OG VEGGIR			Mallkv
SNID			1 : 50
KRISTJÁN KNÚTSSON TÆKNIFR. F.T.É.I.			Samb
LYNGBERGI 27, HAFNARFIRÐI, S. 651647			