




SNID 7-7 1:20

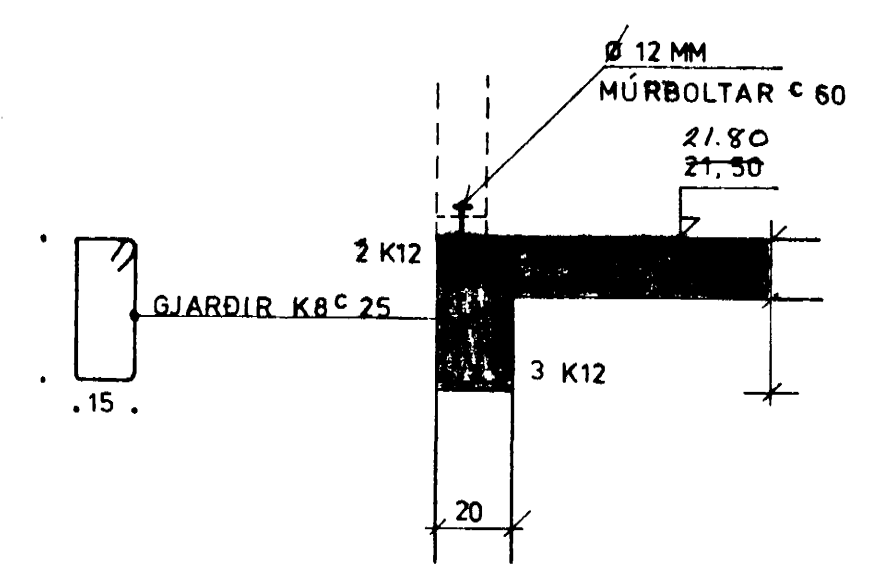


SNID 8-8 1:20

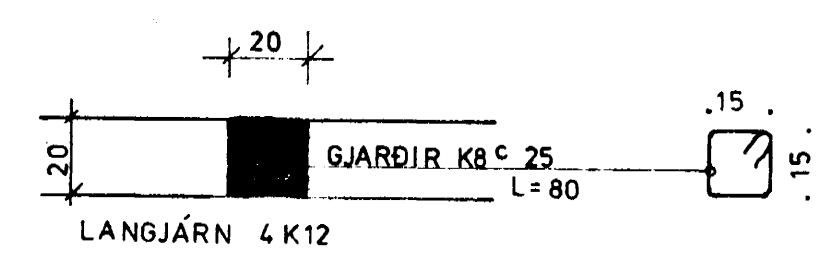

SÚLA S1 1:20

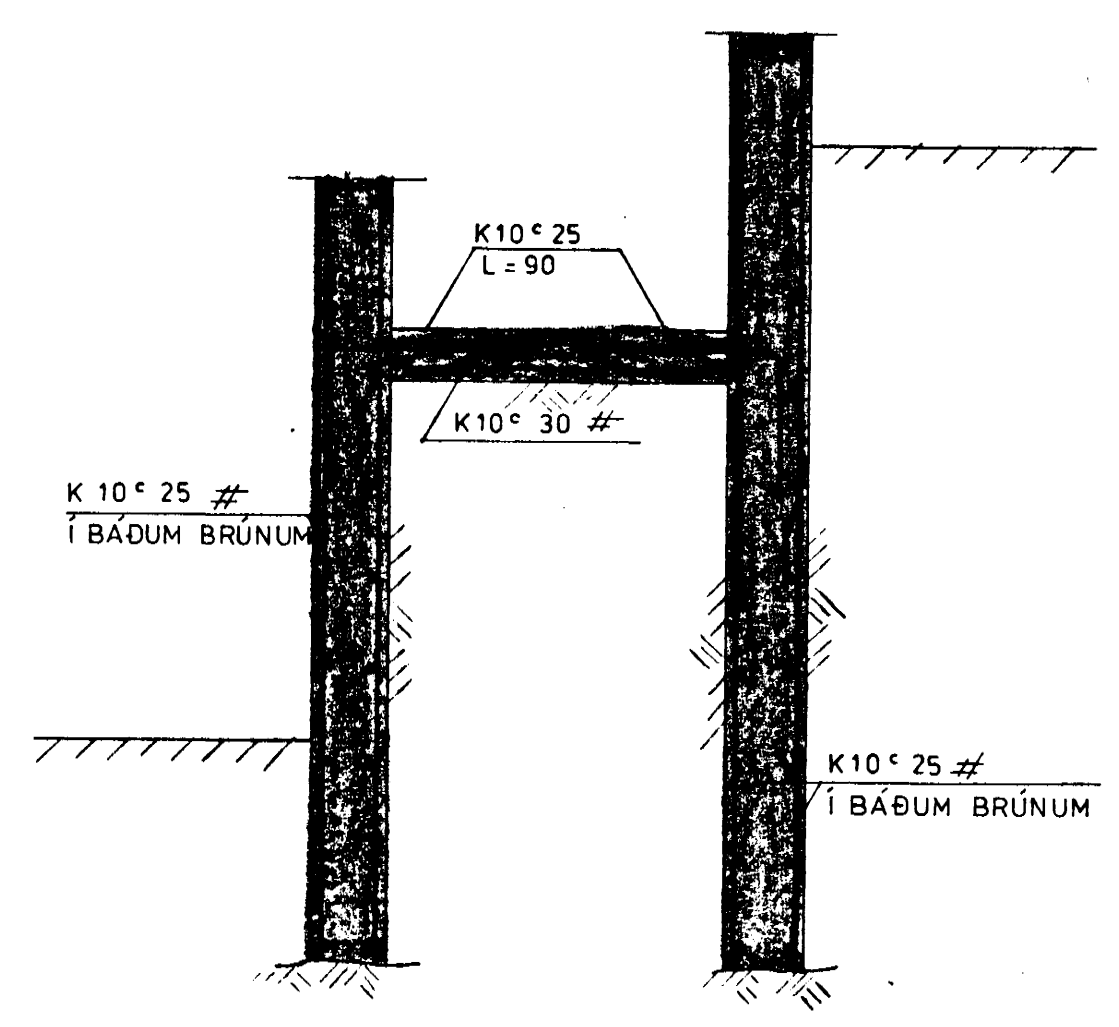


① SNID Í TRÖPPUR 1:20

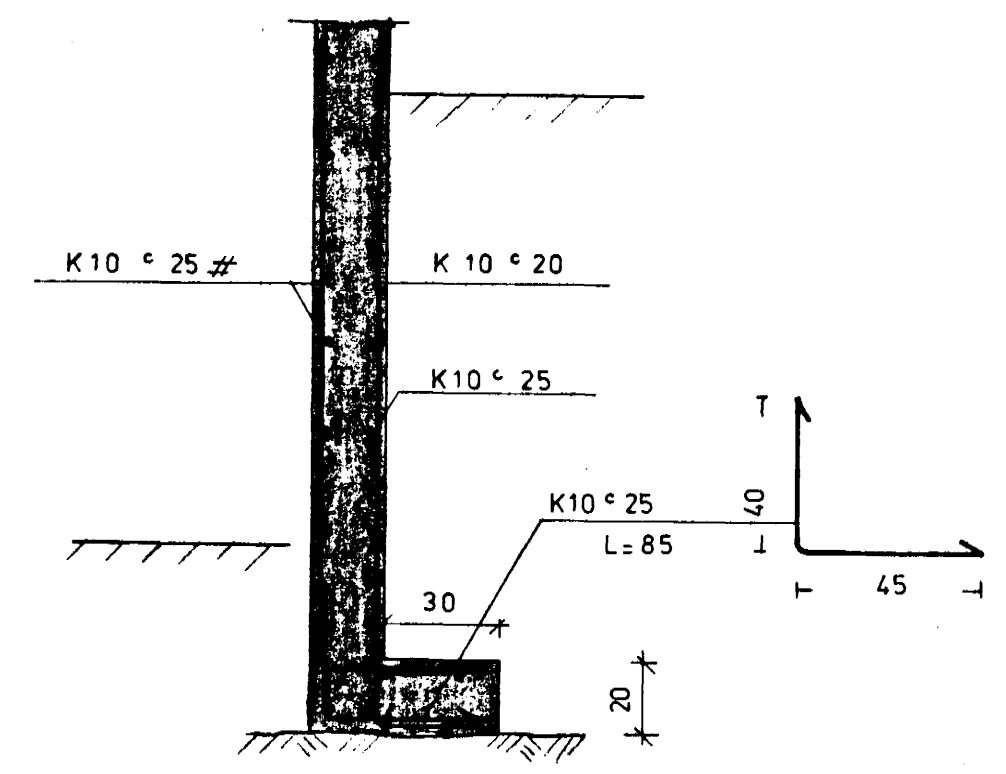

① SNID Í STÖÐVEGG 1:20

① BR. MAÍ '89 : SNID Í ÚTITRÖPPUR OG STÖÐVEGG

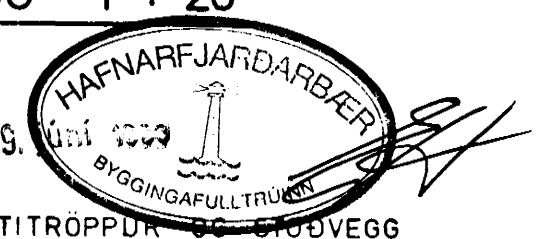

| | | | |
|--|-----------------|-----------|------------|
| TEIKNING NR. 883-01-04 | DAGS | NAFN | YFIRF |
| BIRKIBERG 4 | Mitt: | | |
| HAFNARFIRÐI | Hannað: OKT. 88 | K.K. | |
| | Teknað: OKT. 88 | K.K./SEK. | |
| VEGGIR KJALLARA : SNID OG SÚLUR | | | Malky 1:20 |
| KRISTJÁN KNÚTSSON TÆKNFR. F.T.F.Í. LYGBERGI 27, HAFNARFIRÐI, S. 651647 | | | Samb |