




SNID 7-7 1:20

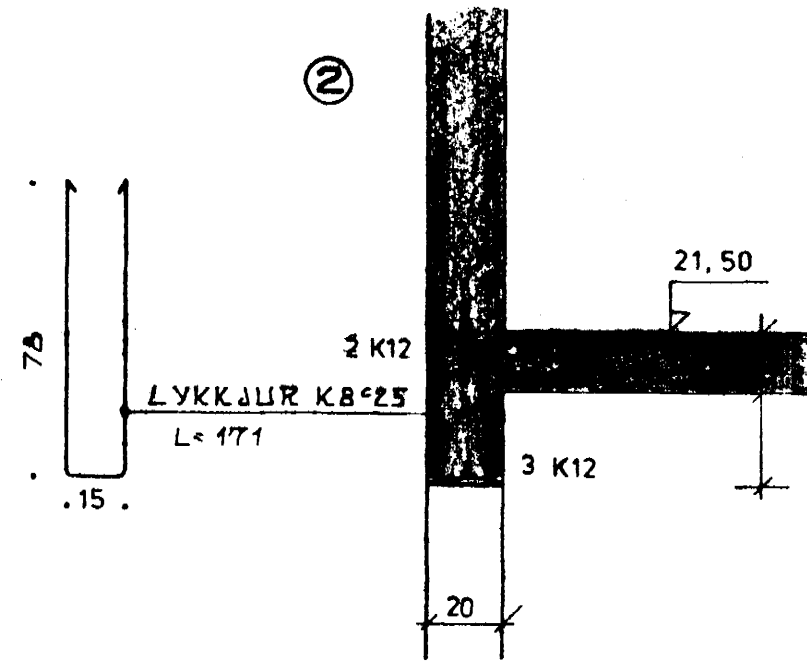


SNID 8-8 1:20

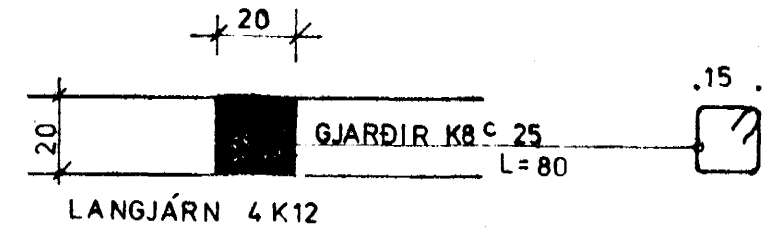

SÚLA S1 1:20

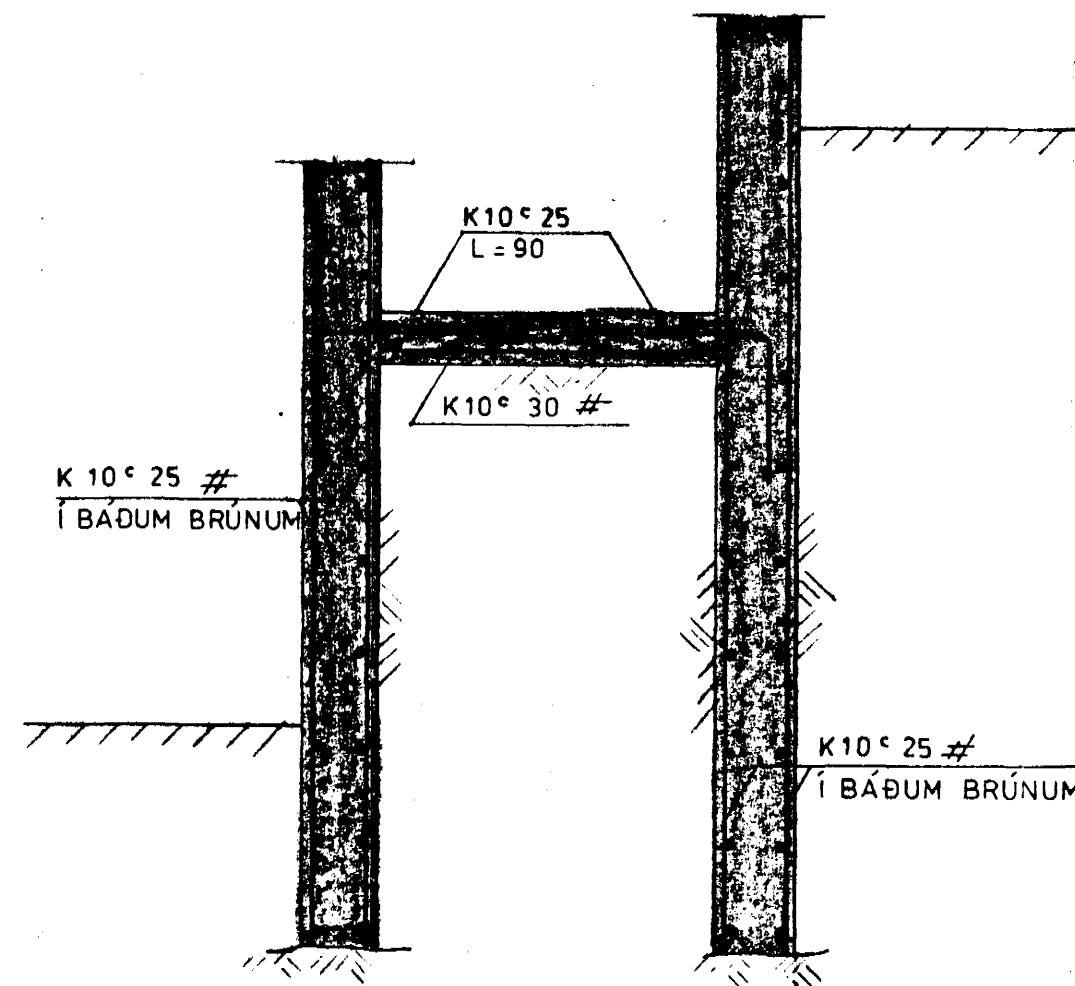


① SNID Í TRÖPPUR 1:20

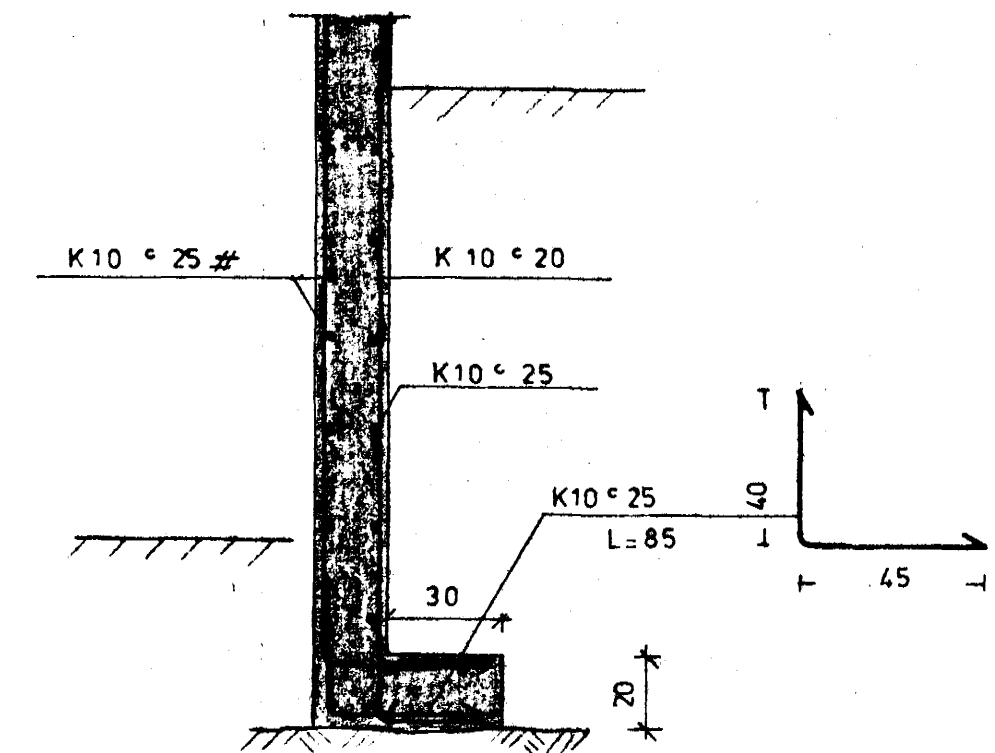

① SNID Í STÖÐVEGG 1:20

② BR. JÚLÍ '90: STEYPTIR VEGGIR 3 AUG 1990

① BR. MAÍ '89: SNID Í ÚTITRÖPPUR OG STÖÐVEGG

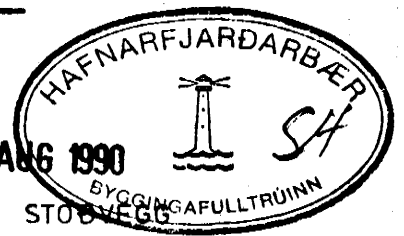

TEIKNING NR. 883-01-04	DAGS	NAFN	YFIRF
BIRKIBERG 4 HAFNARFIRÐI	Mælt:		
	Hannað:	OKT. 88	K.K.
	Telmað:	OKT. 88	K.K./SEK.
VEGGIR KJALLARA: SNID OG SÚLUR			Mæltky 1:20
KRISTJÁN KNÚTSSON TÆKNFR. F.T.F.Í. LYNGBERGI 27, HAFNARFIRÐI, S. 651647			Samb