




SNID 1-1 1:20

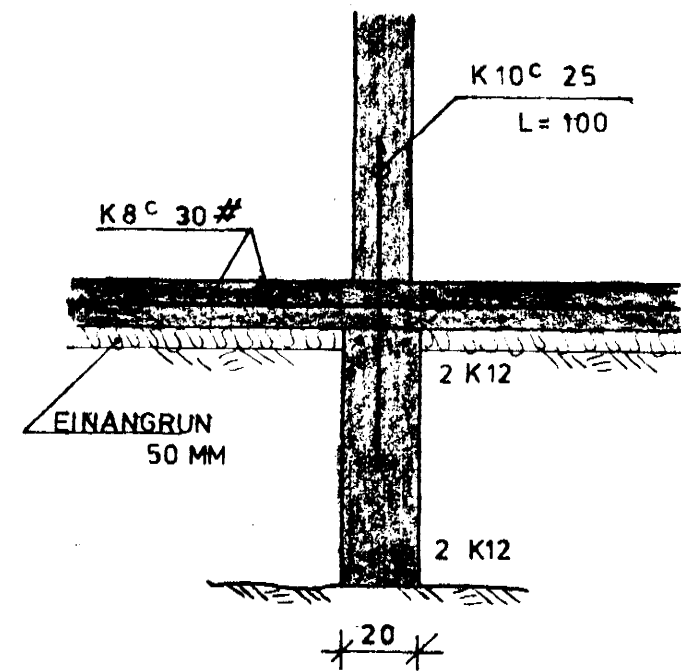


SNID 2-2 1:20

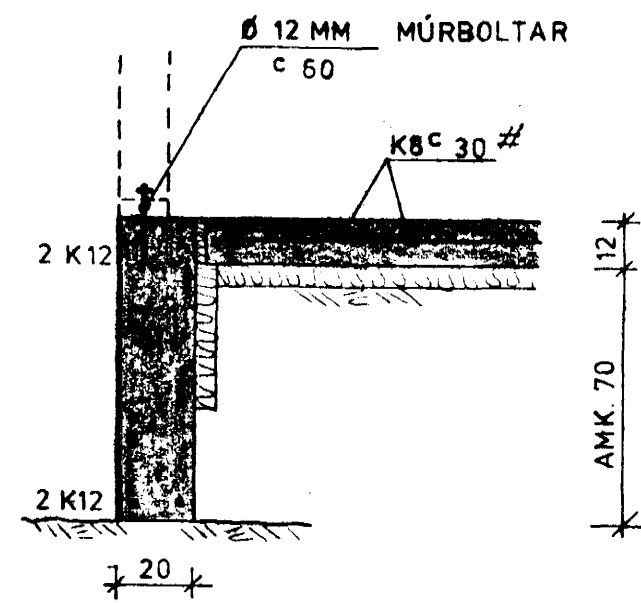


SNID 3-3 1:20

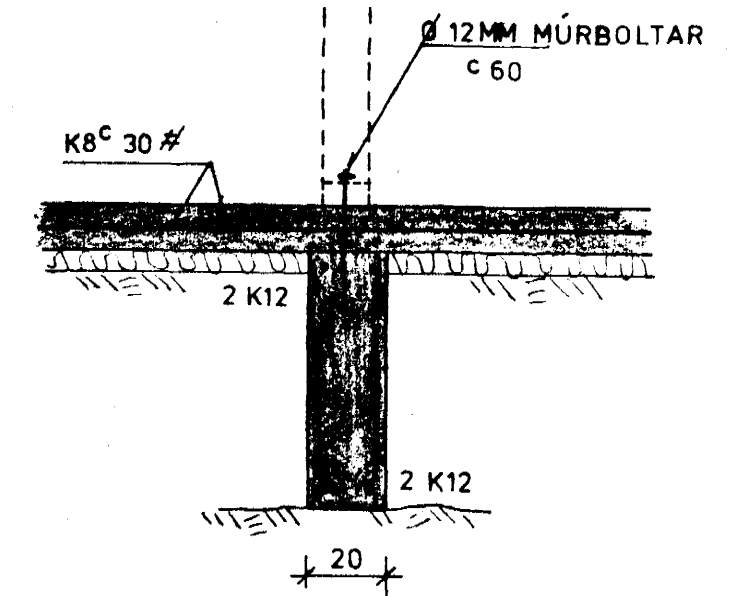


SNID 4-4 1:20

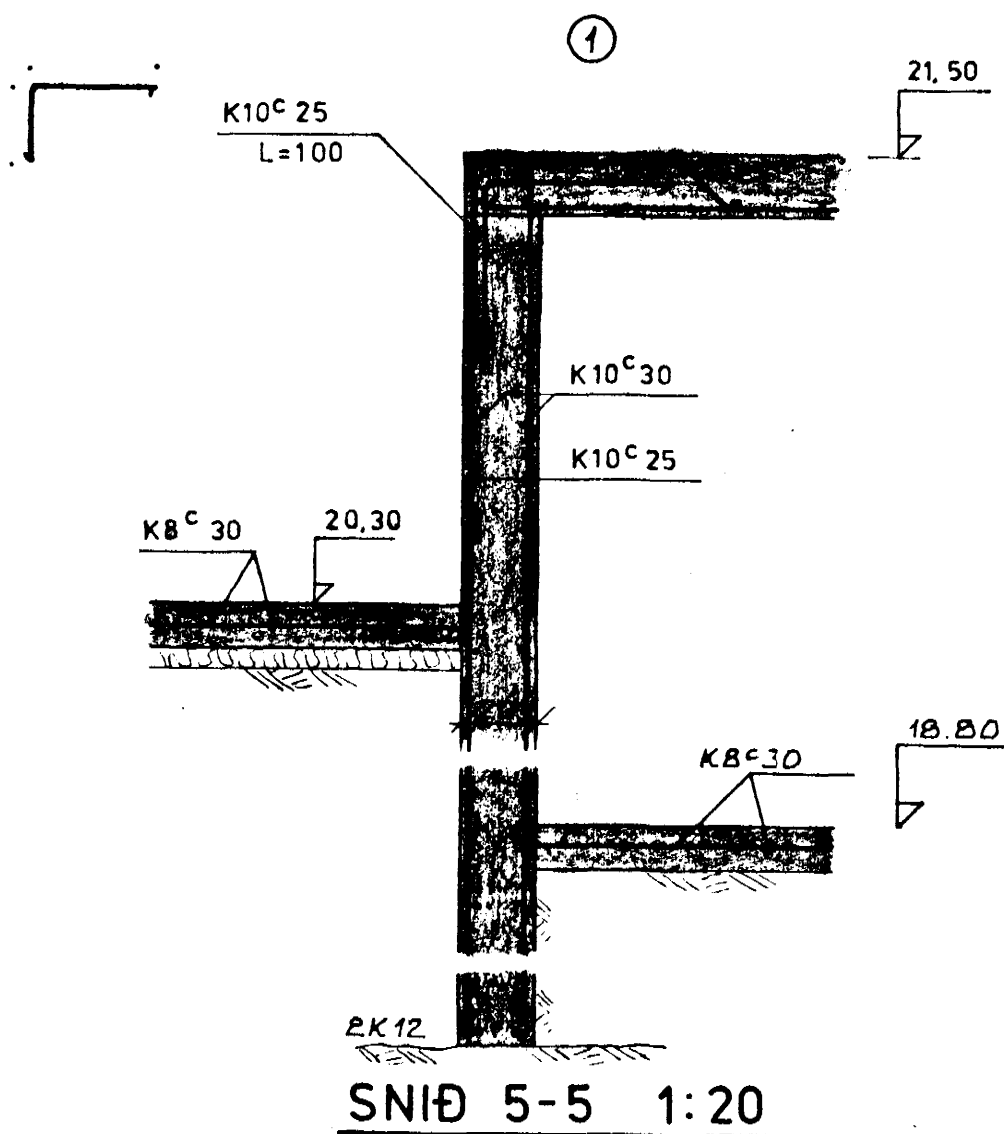

SNID 5-5 1:20

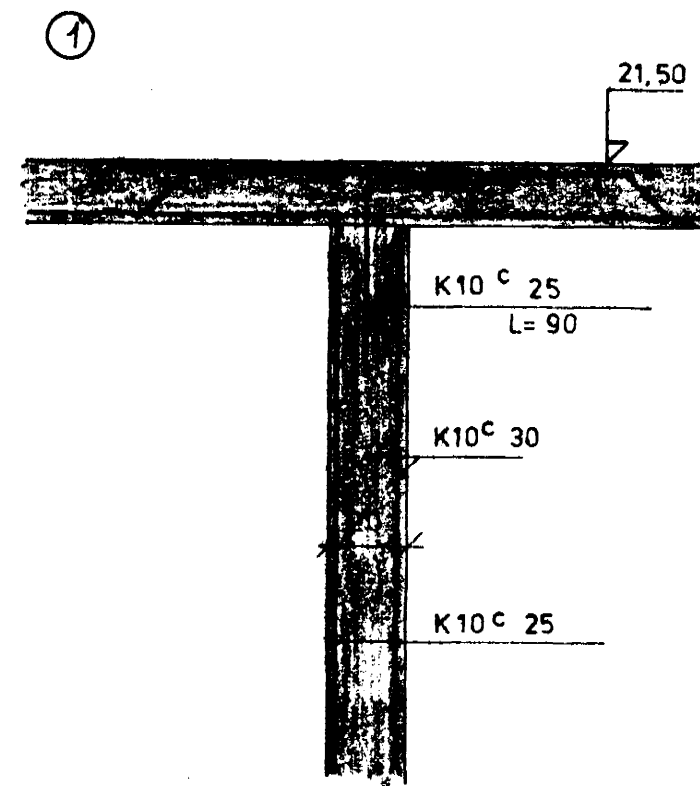

SNID 6-6 1:20

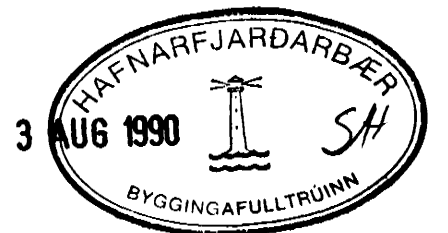

① BR. JÚLÍ '90: PLATA YFIR GEYMSLU.

TEKNING NR. 883-01-03	DAGS	NAFN	YFIRF
BIRKIBERG 4	Mælt:		
HAFNARFIRÐI	Hannað:	OKT '88	K.K.
	Teknað:	OKT '88	K.K./SE.K.
UNDIRSTÖÐUR: SNID			Mælitkv 1:20
KRISTJAN KNÜTSSON TÆKNIFR. F.T.F.Í. LYNGBERGI 27, HAFNARFIRÐI, S. 651647			Samb