



SNID B-B. 1:10.

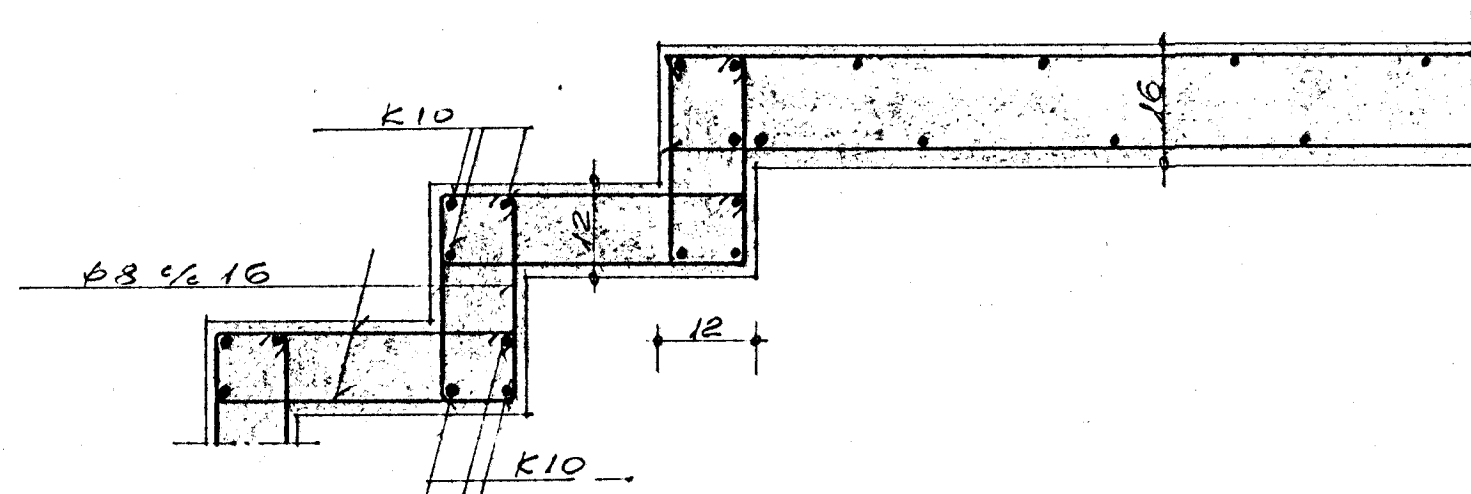


*Þreytt.
22/3 70
Þragi Sig.*



SNID D-D. 1:10.

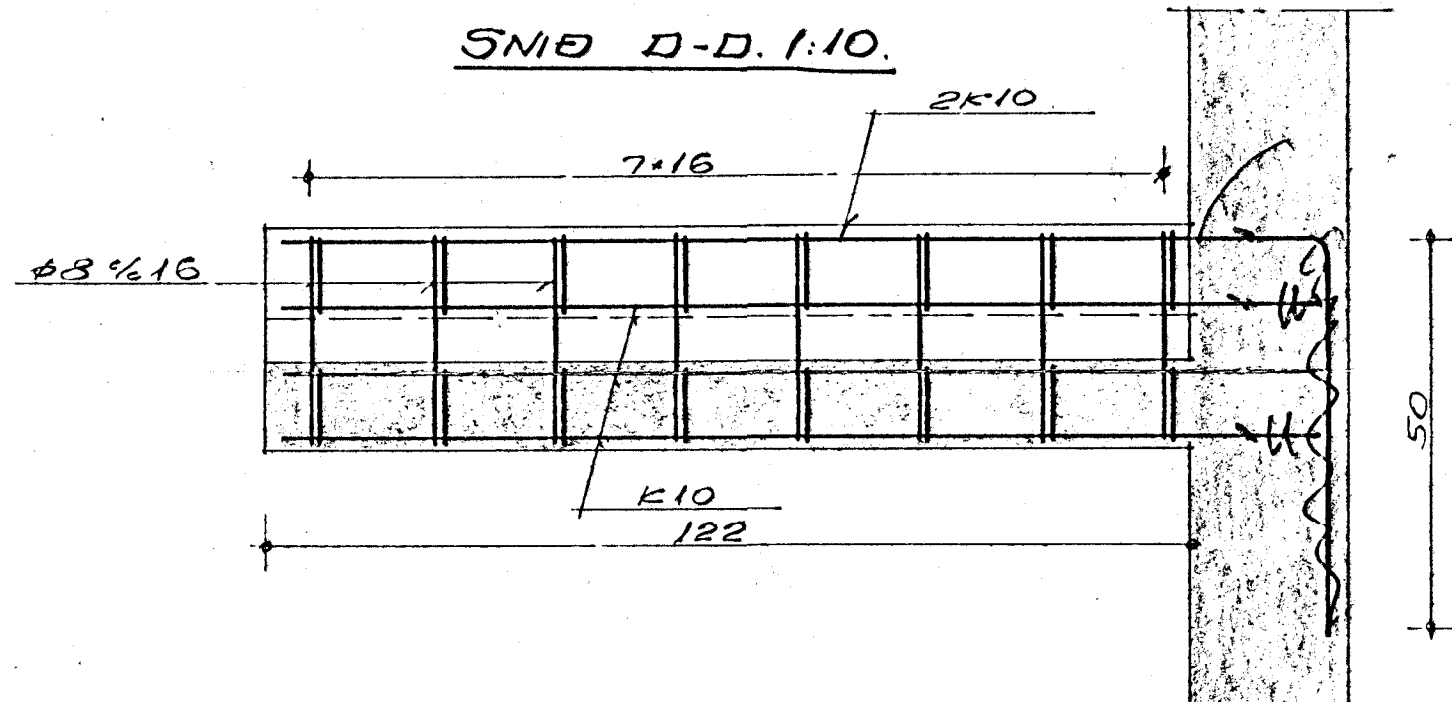

SNID C-C. 1:10.

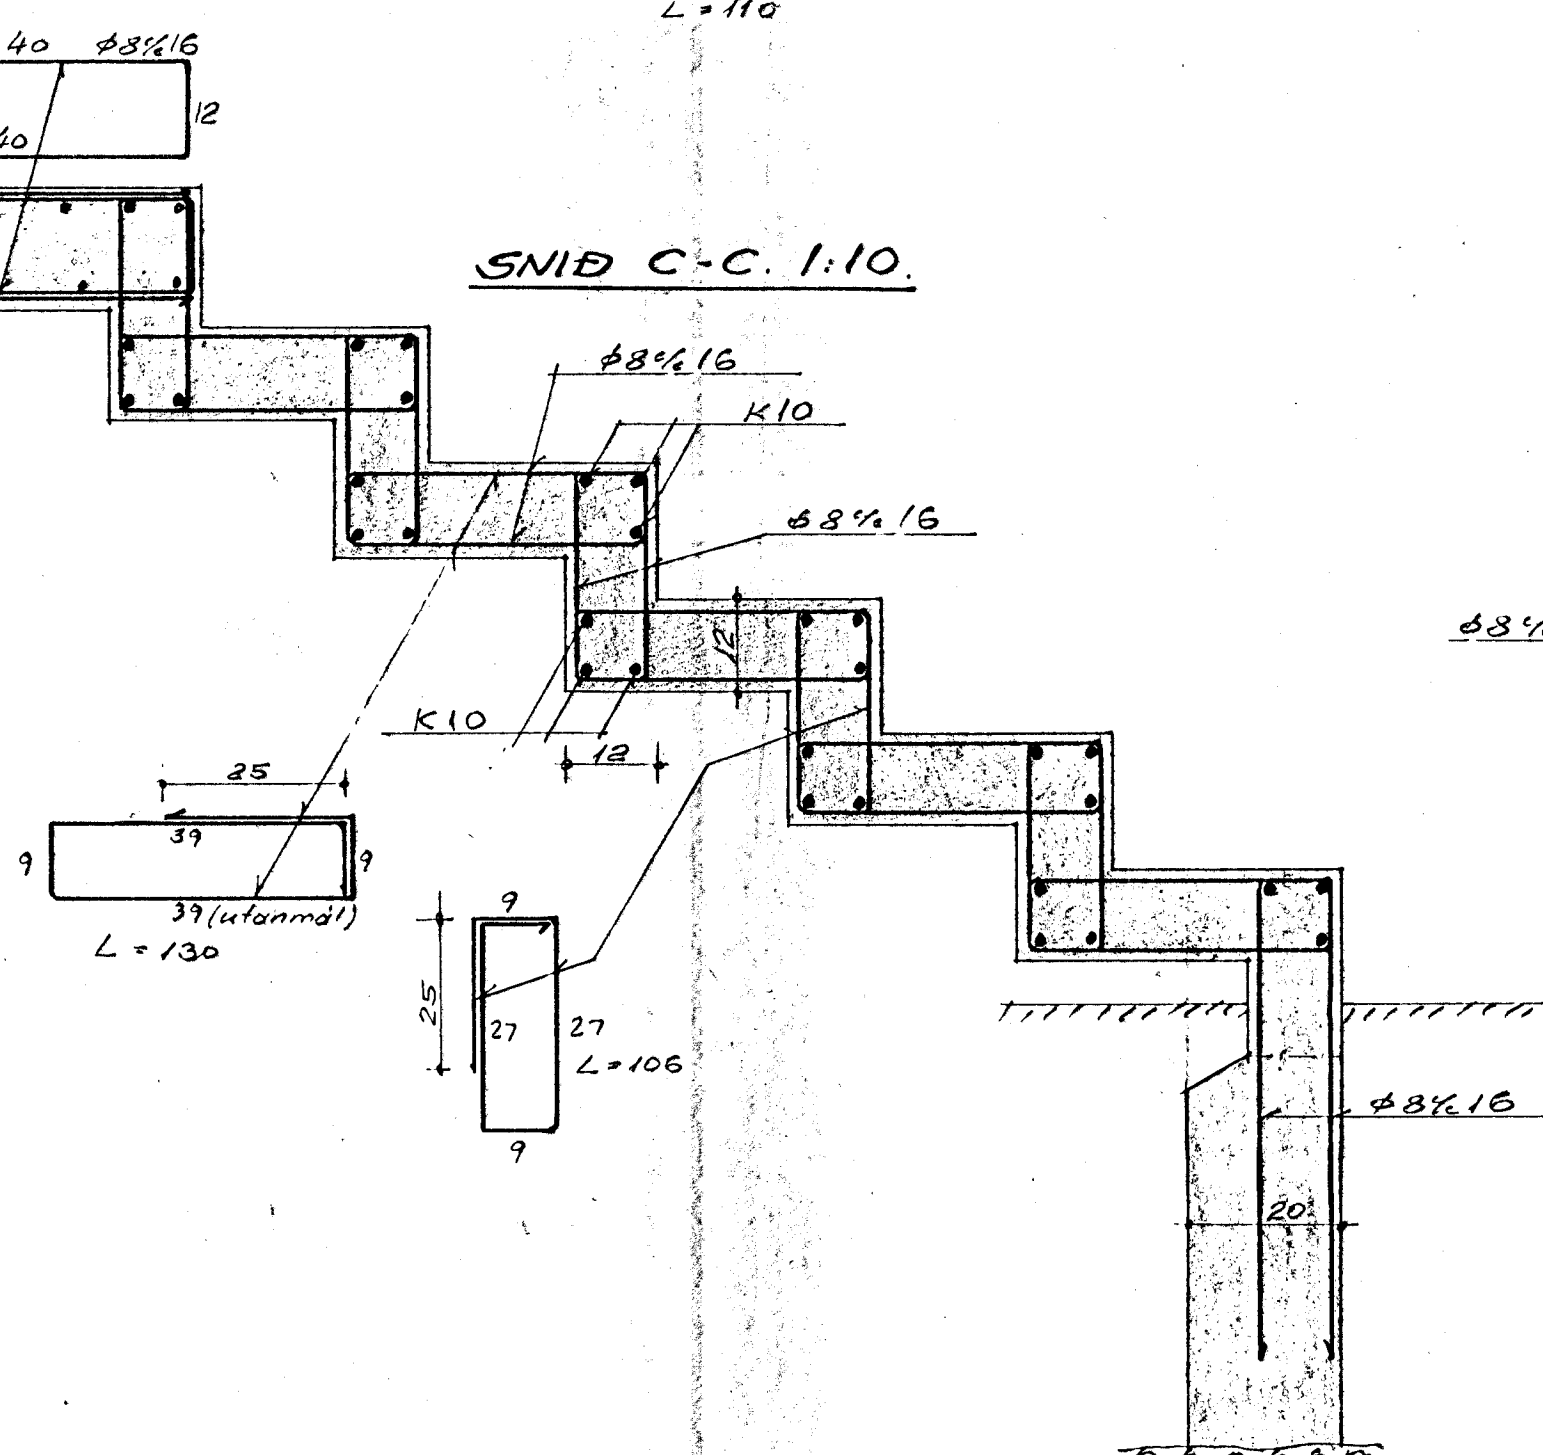

SNID E-E. 1:10.

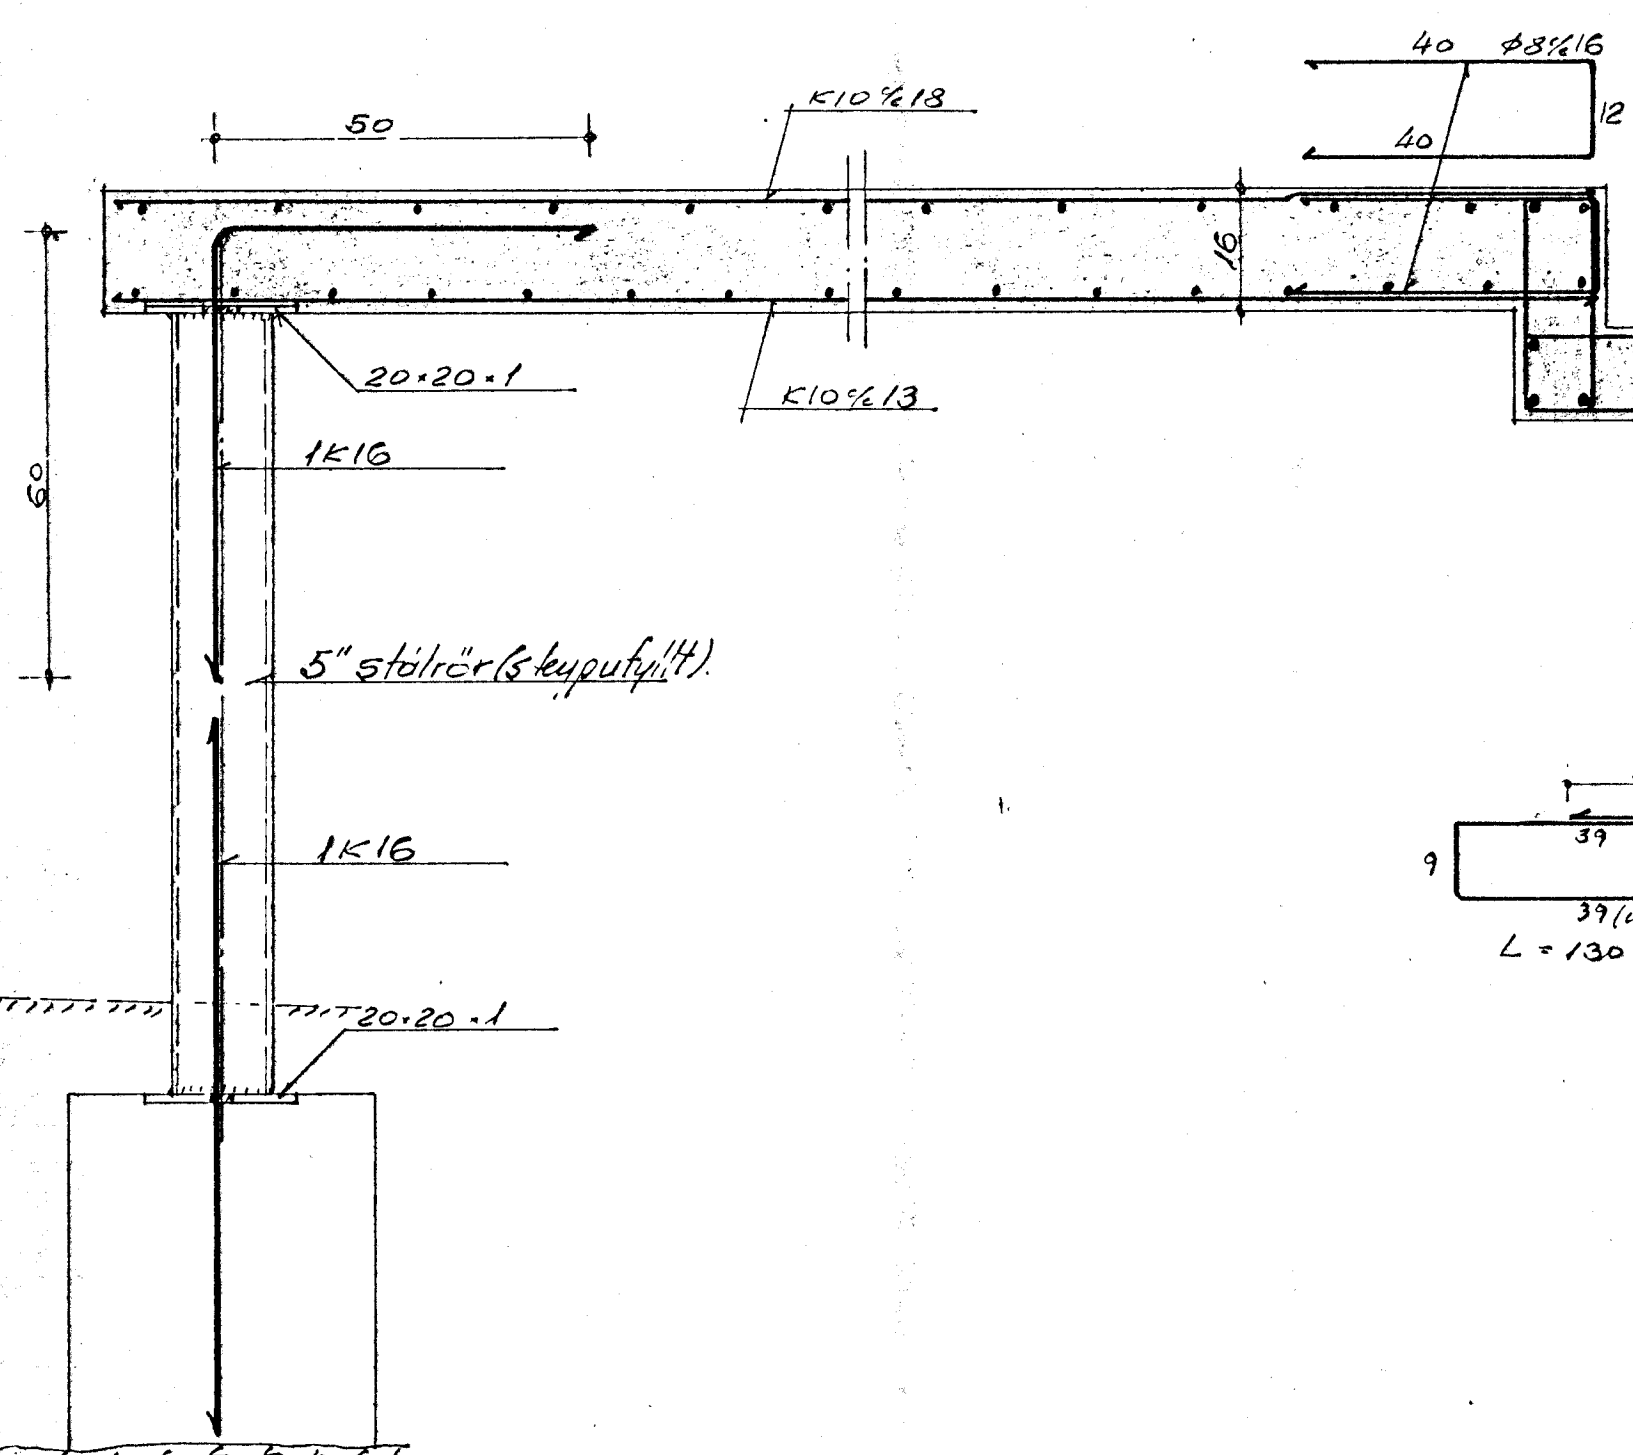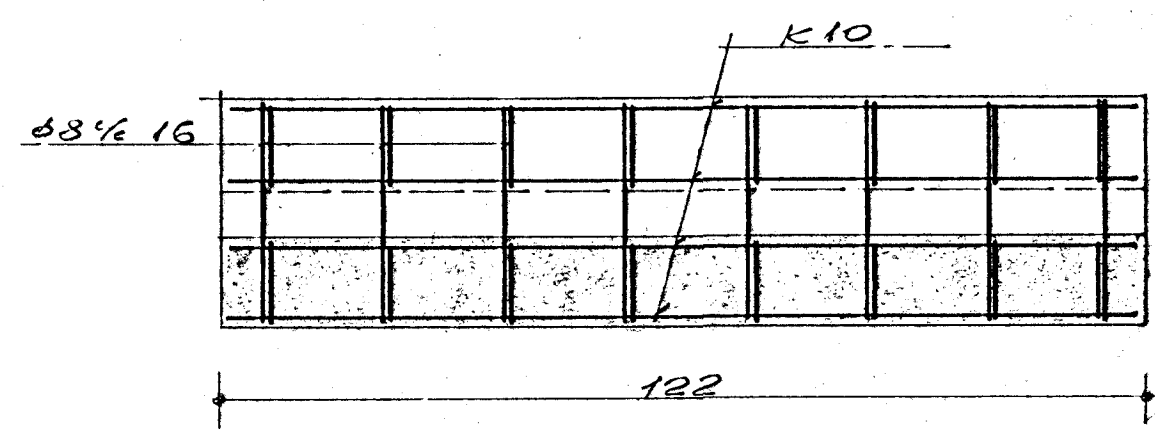

BLÖMVGANGUR NR. 4.		
1. HÆÐ. STIGI JÄRNALÖGN.		
BRAGI SIGURÐARSSON VERKFR. SAFAMÝRÍ 38. RÚK.		
M. 1:10	Ut. Þragi	
D. 22/3 69	Uppdr. Þragi	NR. 7003