



Sjá áttugasemnd á
 bl. nr. 503 0-1 13/6/77
 F.M.

TÖPPUNARSTADIR						
SK. ST.	TÆKI	Földi	K		H	
			15	20	15	20
HL	HANDLUGAR	3	3	3	3	3
B	BABER	1	1	1	1	1
EV	ERDHVASKAR	1	1	1	1	1
ST.	STEYPIBÆD	1	1	1	1	1
BV	ÞVOTTUR	2	1	1	1	1
UK	ÚTIRRANAR	1	1	1		
'A	AFYLLINGAR	1	1	1		
	ALLS	10	9	9	7	7
VS.	JALERNI	2	2	2		
	TÖPPUNAREININGAR		11		7	

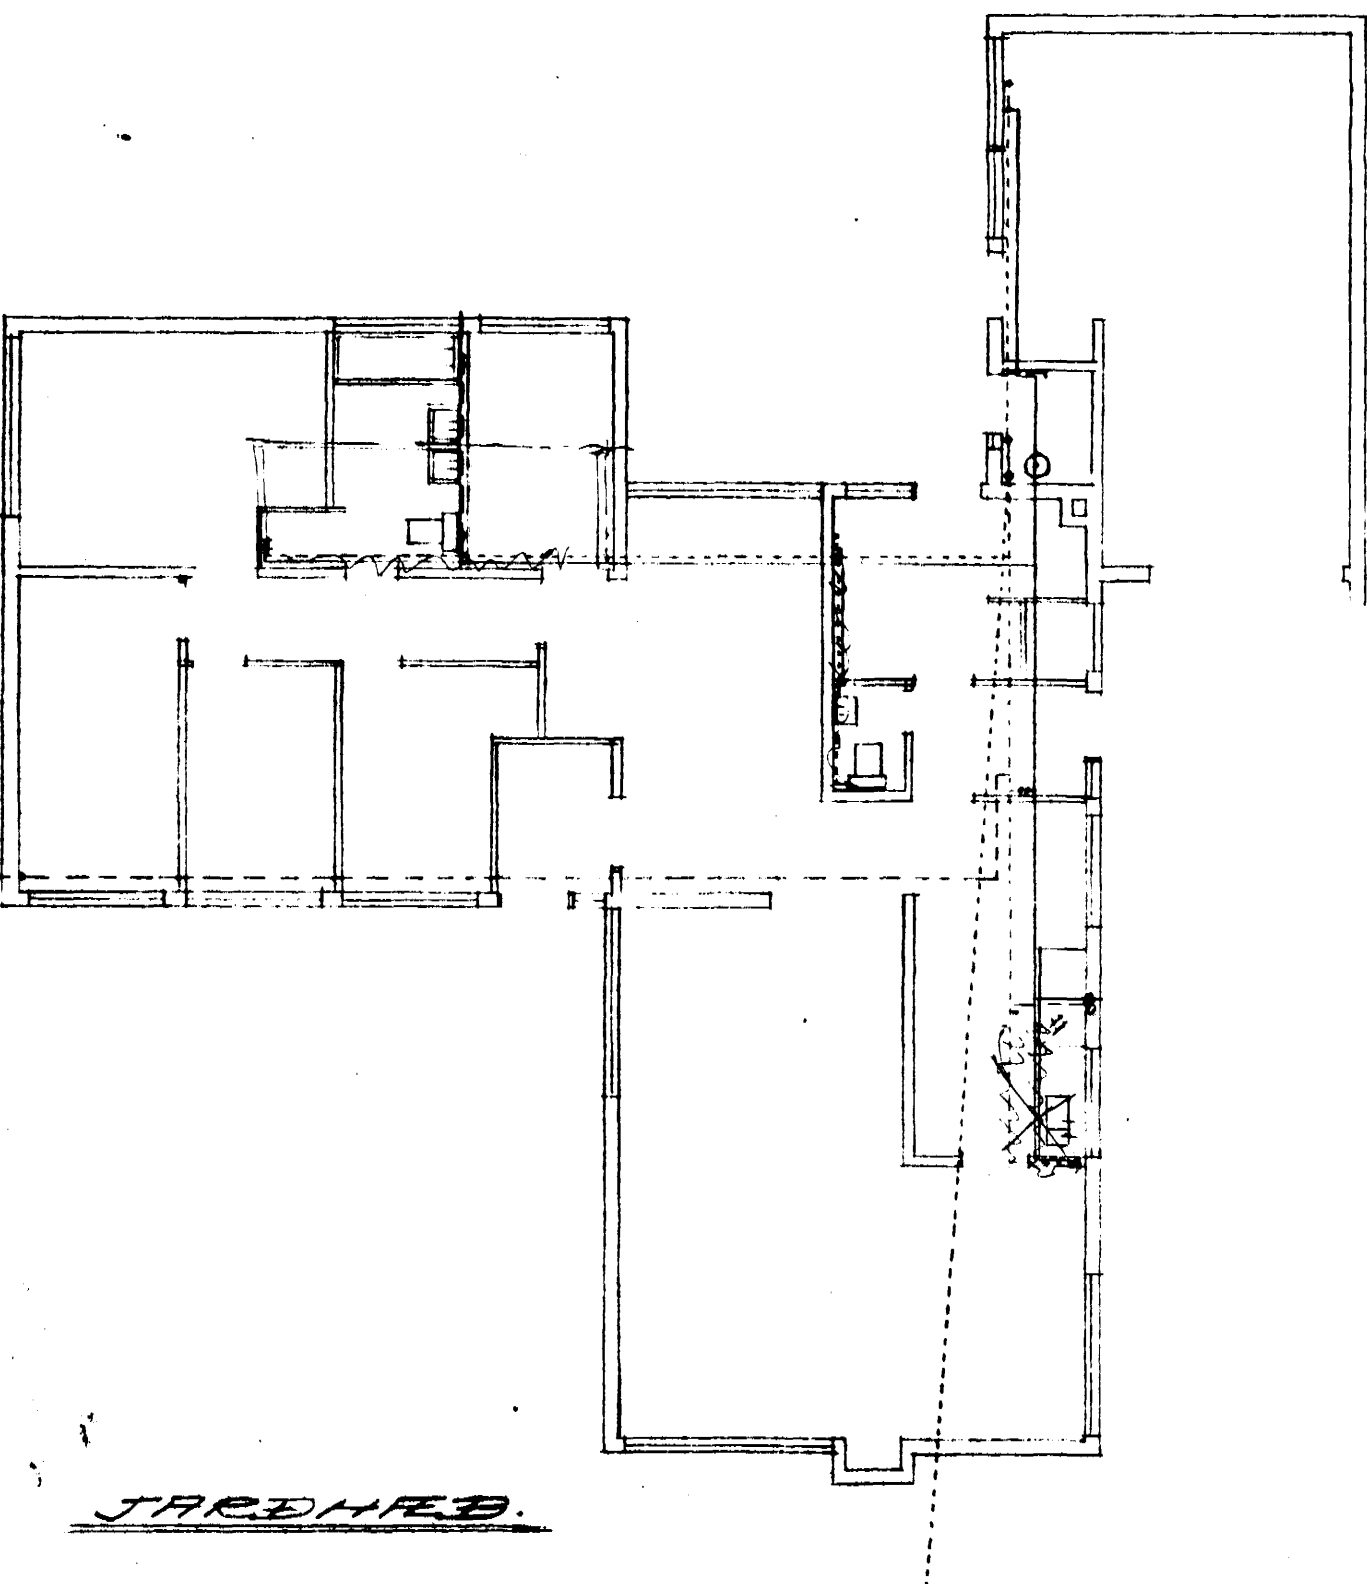

JARÐHÆB.

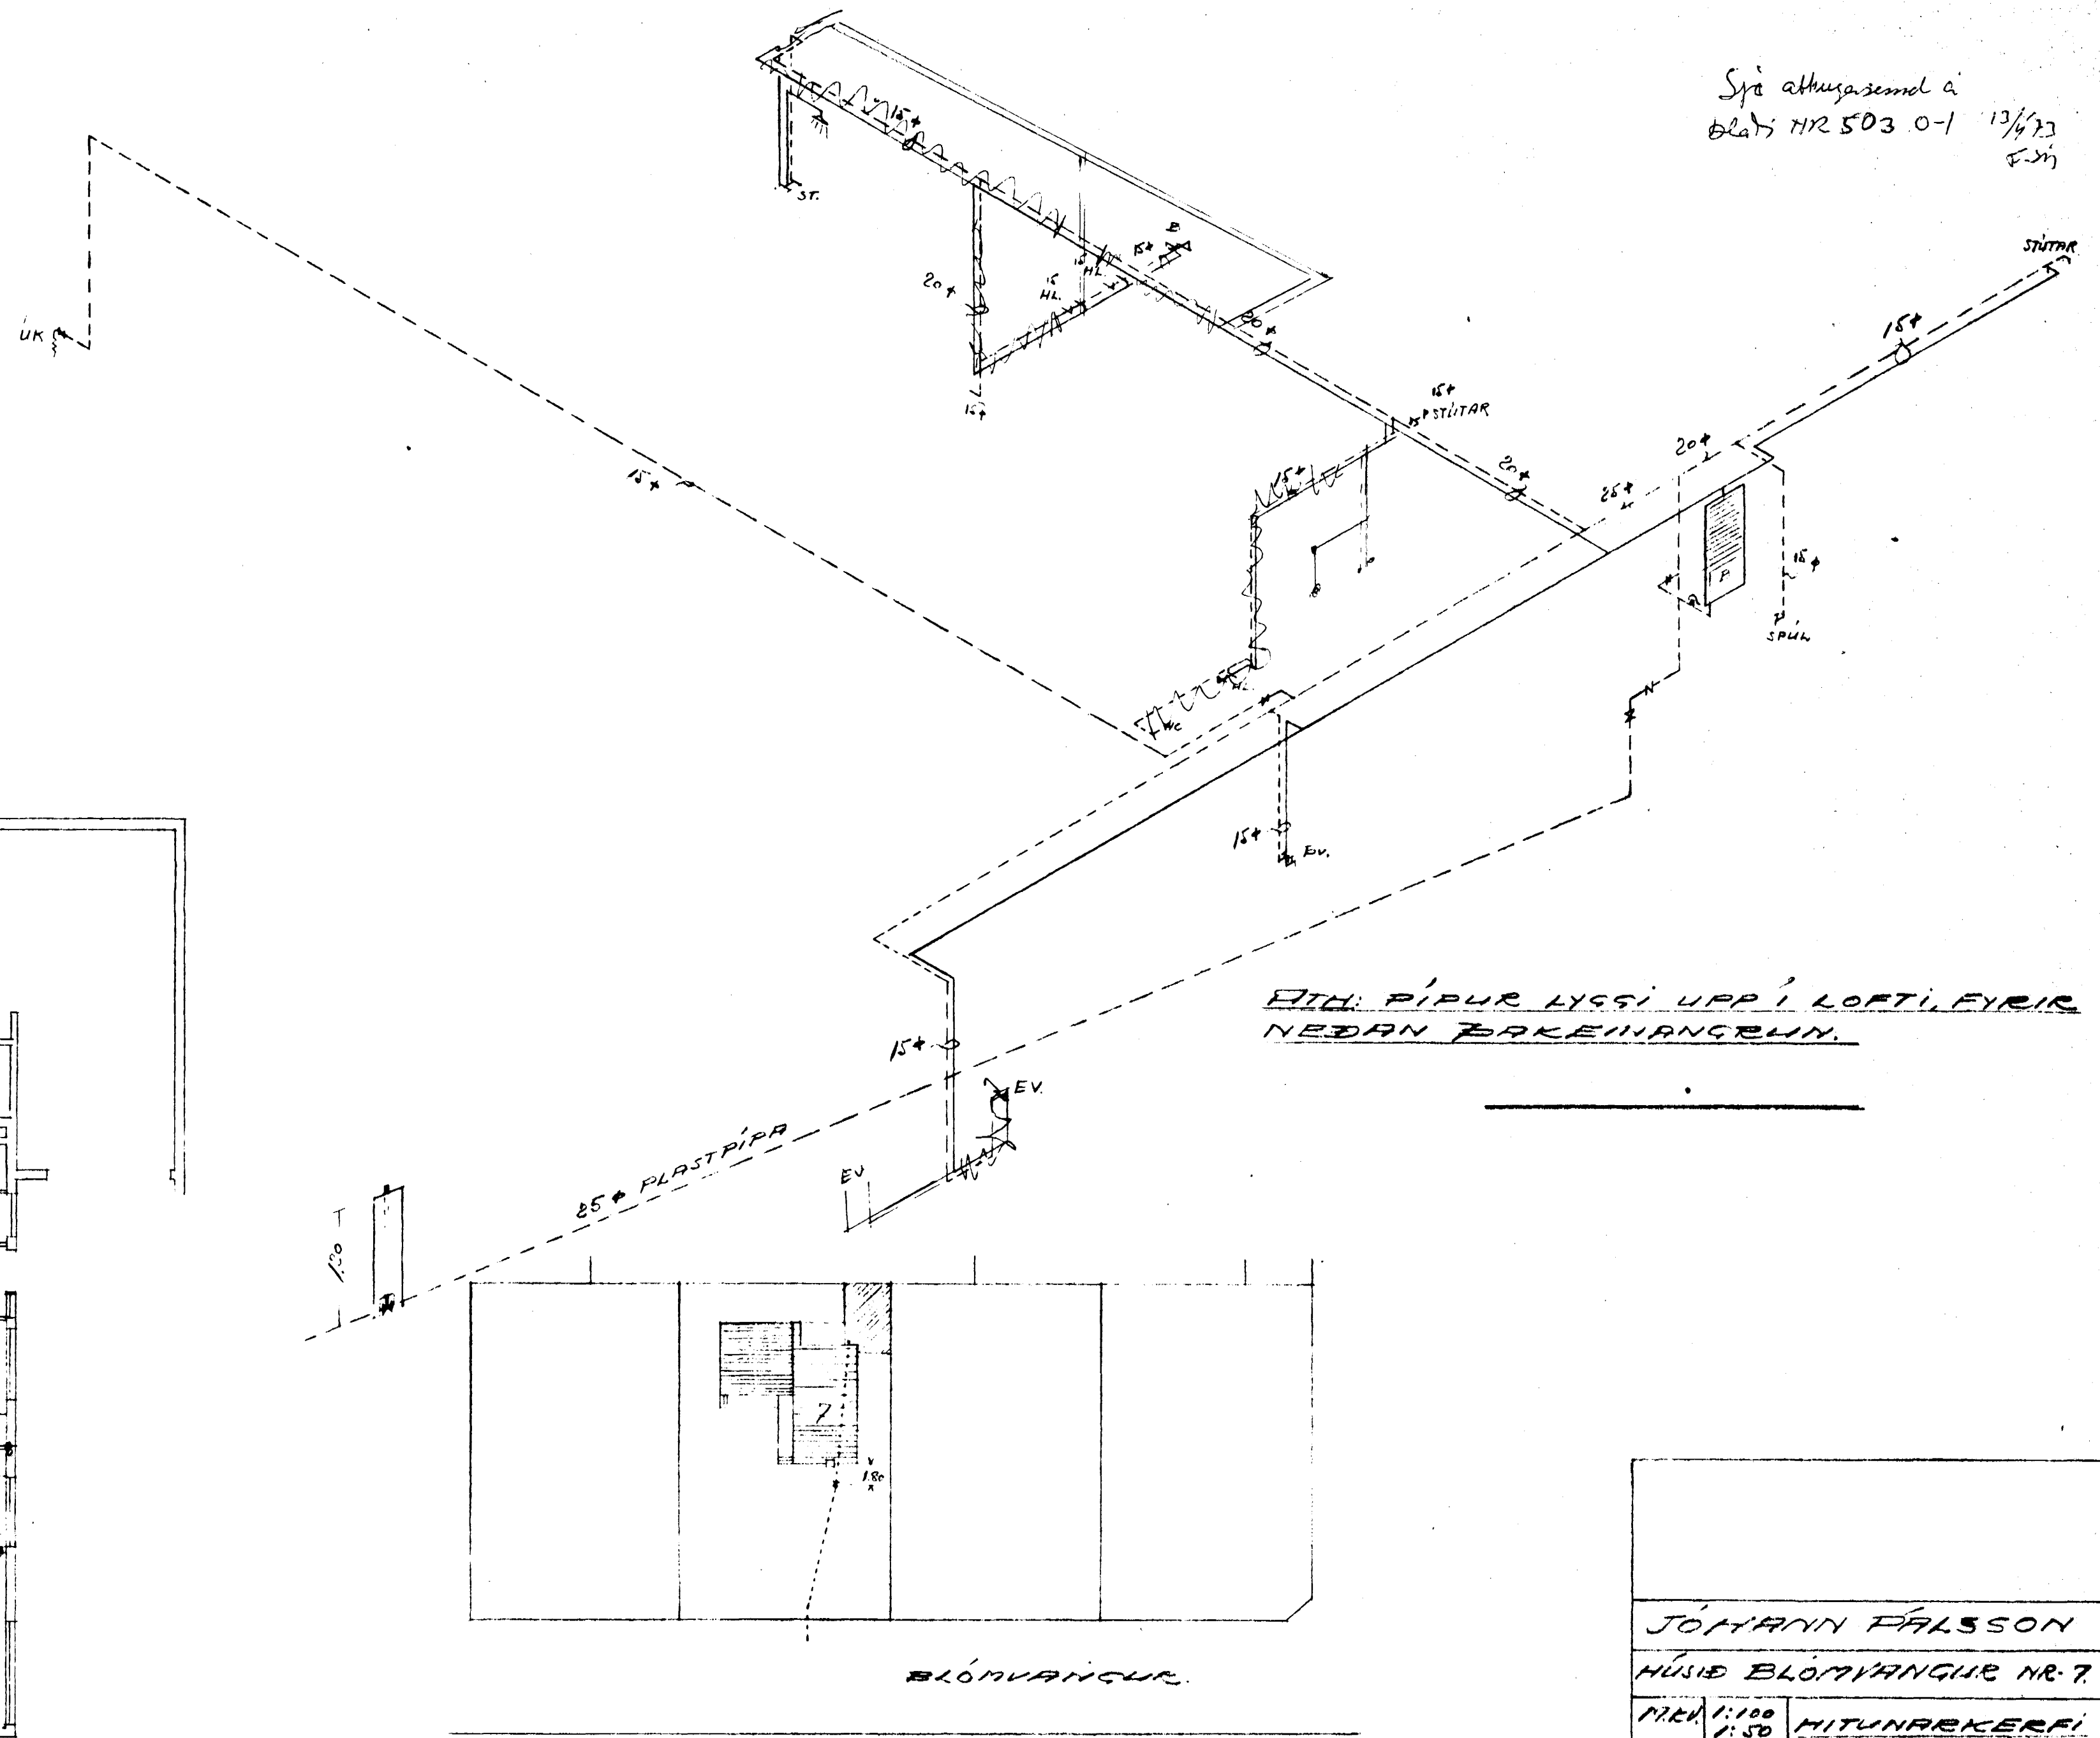

ATH: PÍPUR LYSSI UPP Í LOFTI, FYRIR
 NEDAN ÞAKKINGRUNN.

BLÖMVAINGUR.

FÆSTÖÐUMYND MKU. = 1:500.

JÓHANN PÁLSSON		
HÚSÍÐ BLÖMVAINGUR NR. 7.		
M.K.V.	1:100 1:50	HITUNARKEFNI
DAGS.	10.6.77	
NR. 497	0-1	Jóhann Pálsson