






Hús Bjarna Agústssonar, við Brattakinn nr. 11
eftir stækkun, og Bilskúr.

4/9 1956


1:00

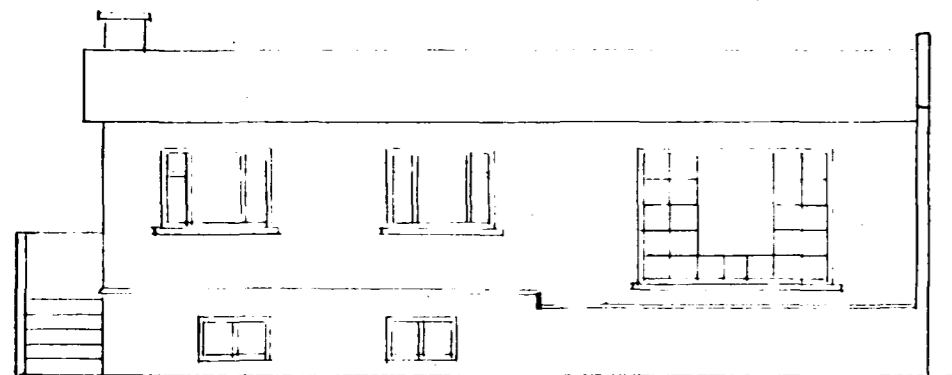

Götuhlid breytt

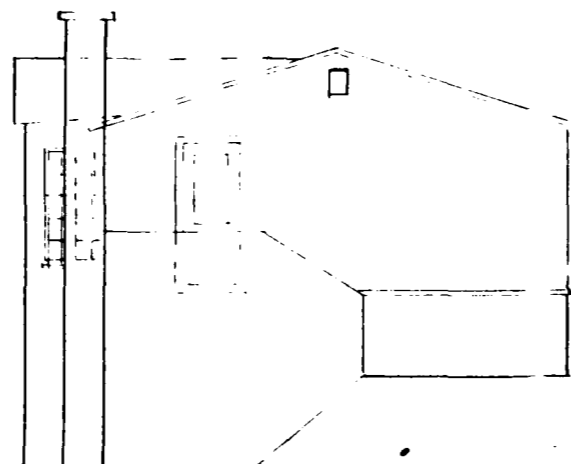

Vestur

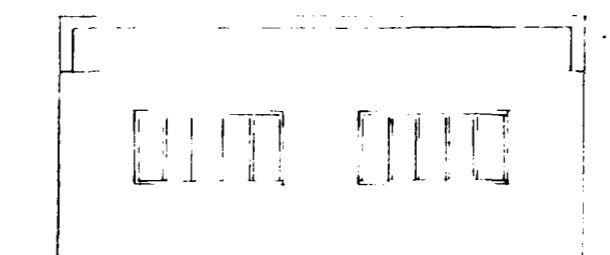


Bilskúr

-100- 200 100- 200 100-

- 700

Austur

1:200

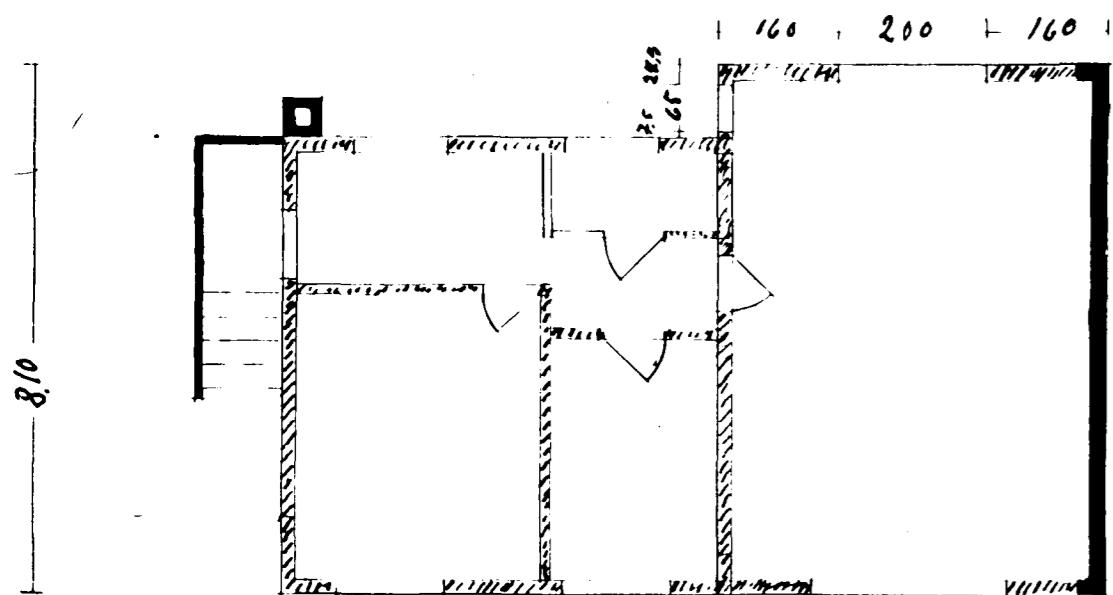


160 200 160


8,0

+80+ 145- 155 + 145+ 190 + 260 + 131+

11,05

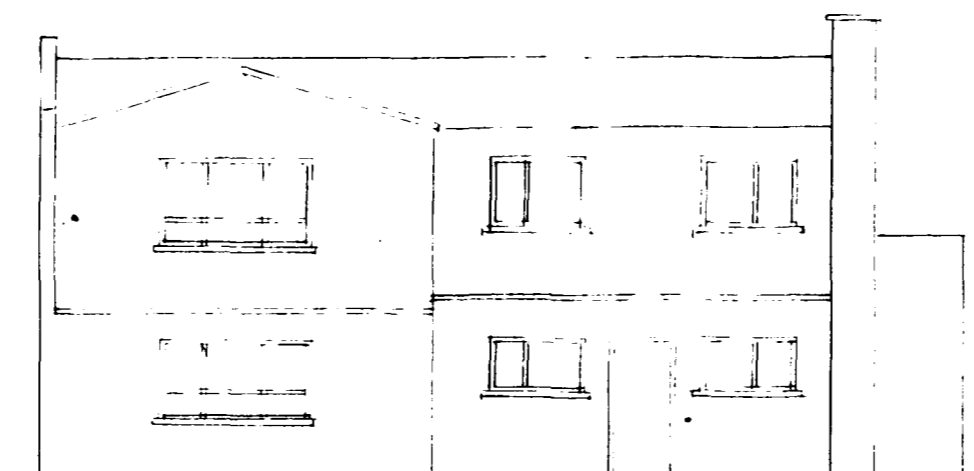


Bakhlid

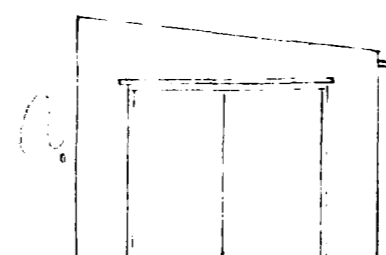

1675 265 1675

- 400

Götuhlid

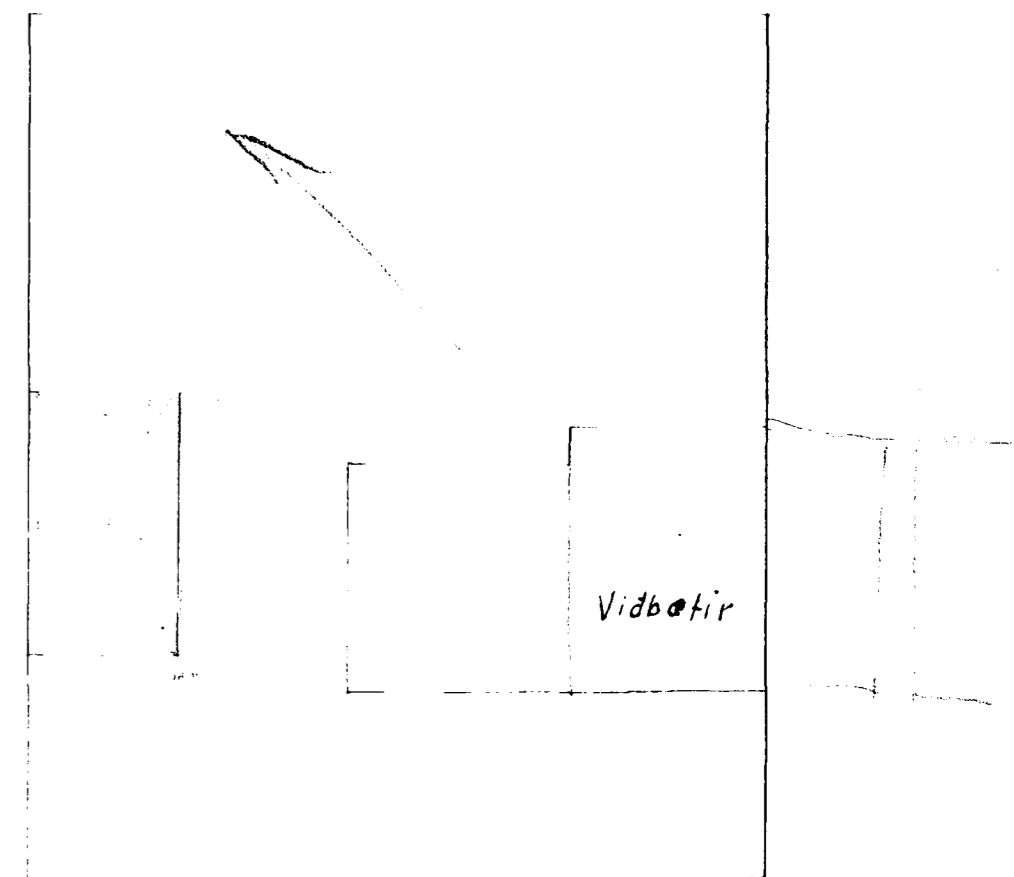

Vidbætur

Brattakinn

Hafnarfjörði í mars 1956
Einar Jónsson