



# Brattakinn 31.

Samþykkt á fundi byggingar-  
nefndar þ. 15. 6. 77  
BYGGINGARFULLTÖNNI  
Í HAFNARFIRSI  
*[Signature]*

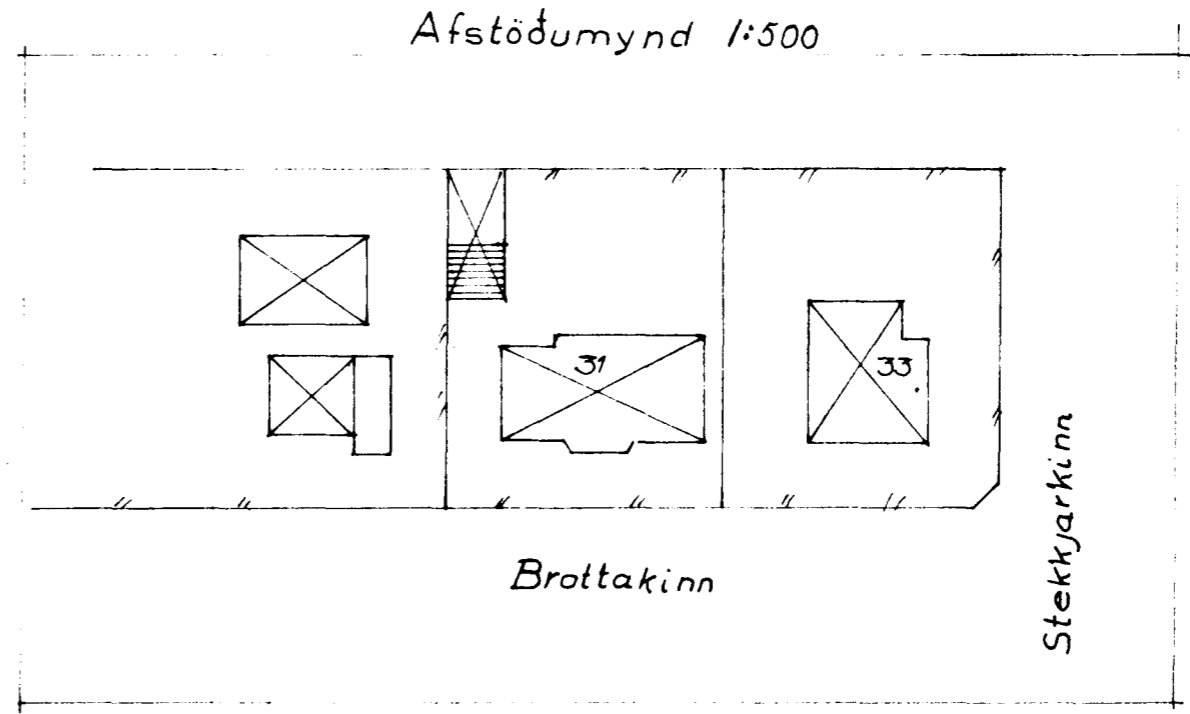



*Ástaka hefur tilg. ve. 8i staki  
meiri en 2,70 m.*

EFTIR STÆKKUN


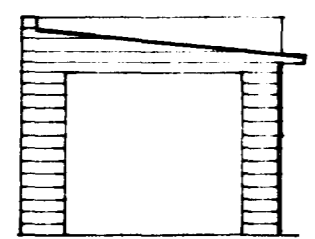


SUÐVESTUR


FIRIR STÆKKUN

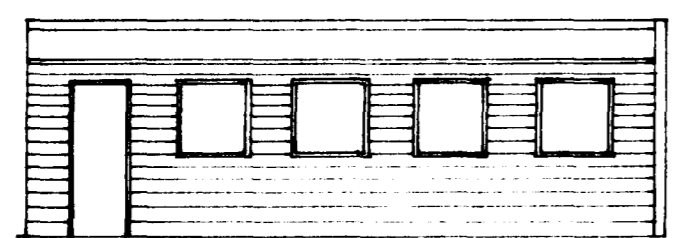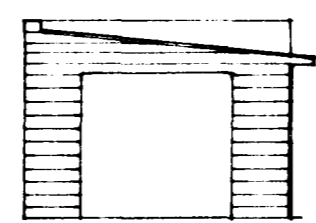



SUÐAUSTUR

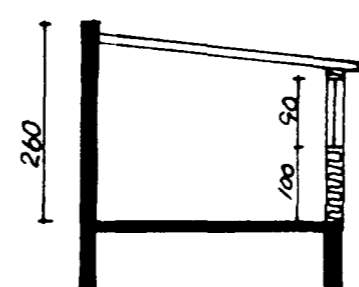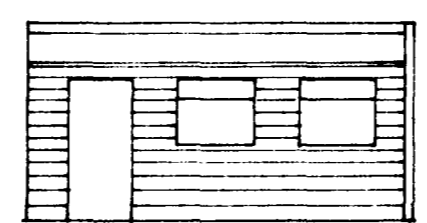

F. S.

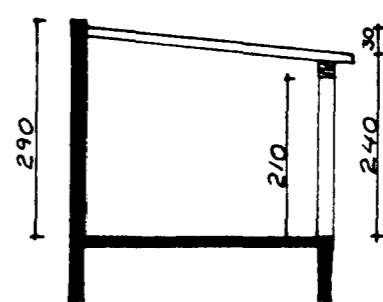

E. S.

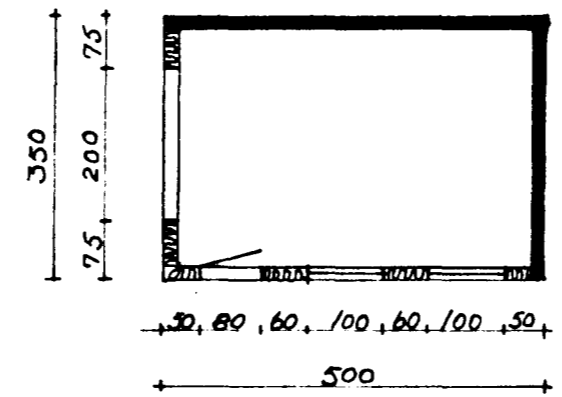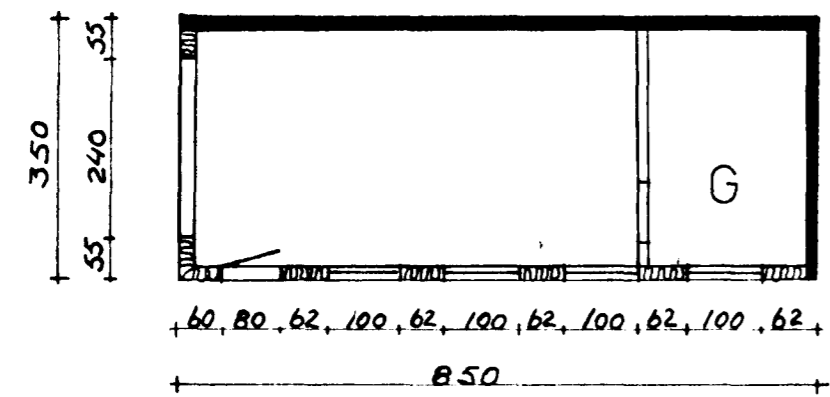

*Var 175 m<sup>2</sup>, 38,5 m<sup>3</sup>  
Var 29,8 m<sup>2</sup> x 76,0 m<sup>3</sup>*

TEIKNING NR.	DAGS	NAFN	YFIRF
BRATTAKINN 31	Mælt: Hannað: Teiknað:	<i>[Signature]</i>	<i>[Signature]</i>
STÆKKUN BILGEYMSLU			Mællkv 1:100 1:500
Einar Sigurðsson MTFI s. 52941.			Samb 55.