


AFSTADA 1:500



GRUNNMYND 1:50

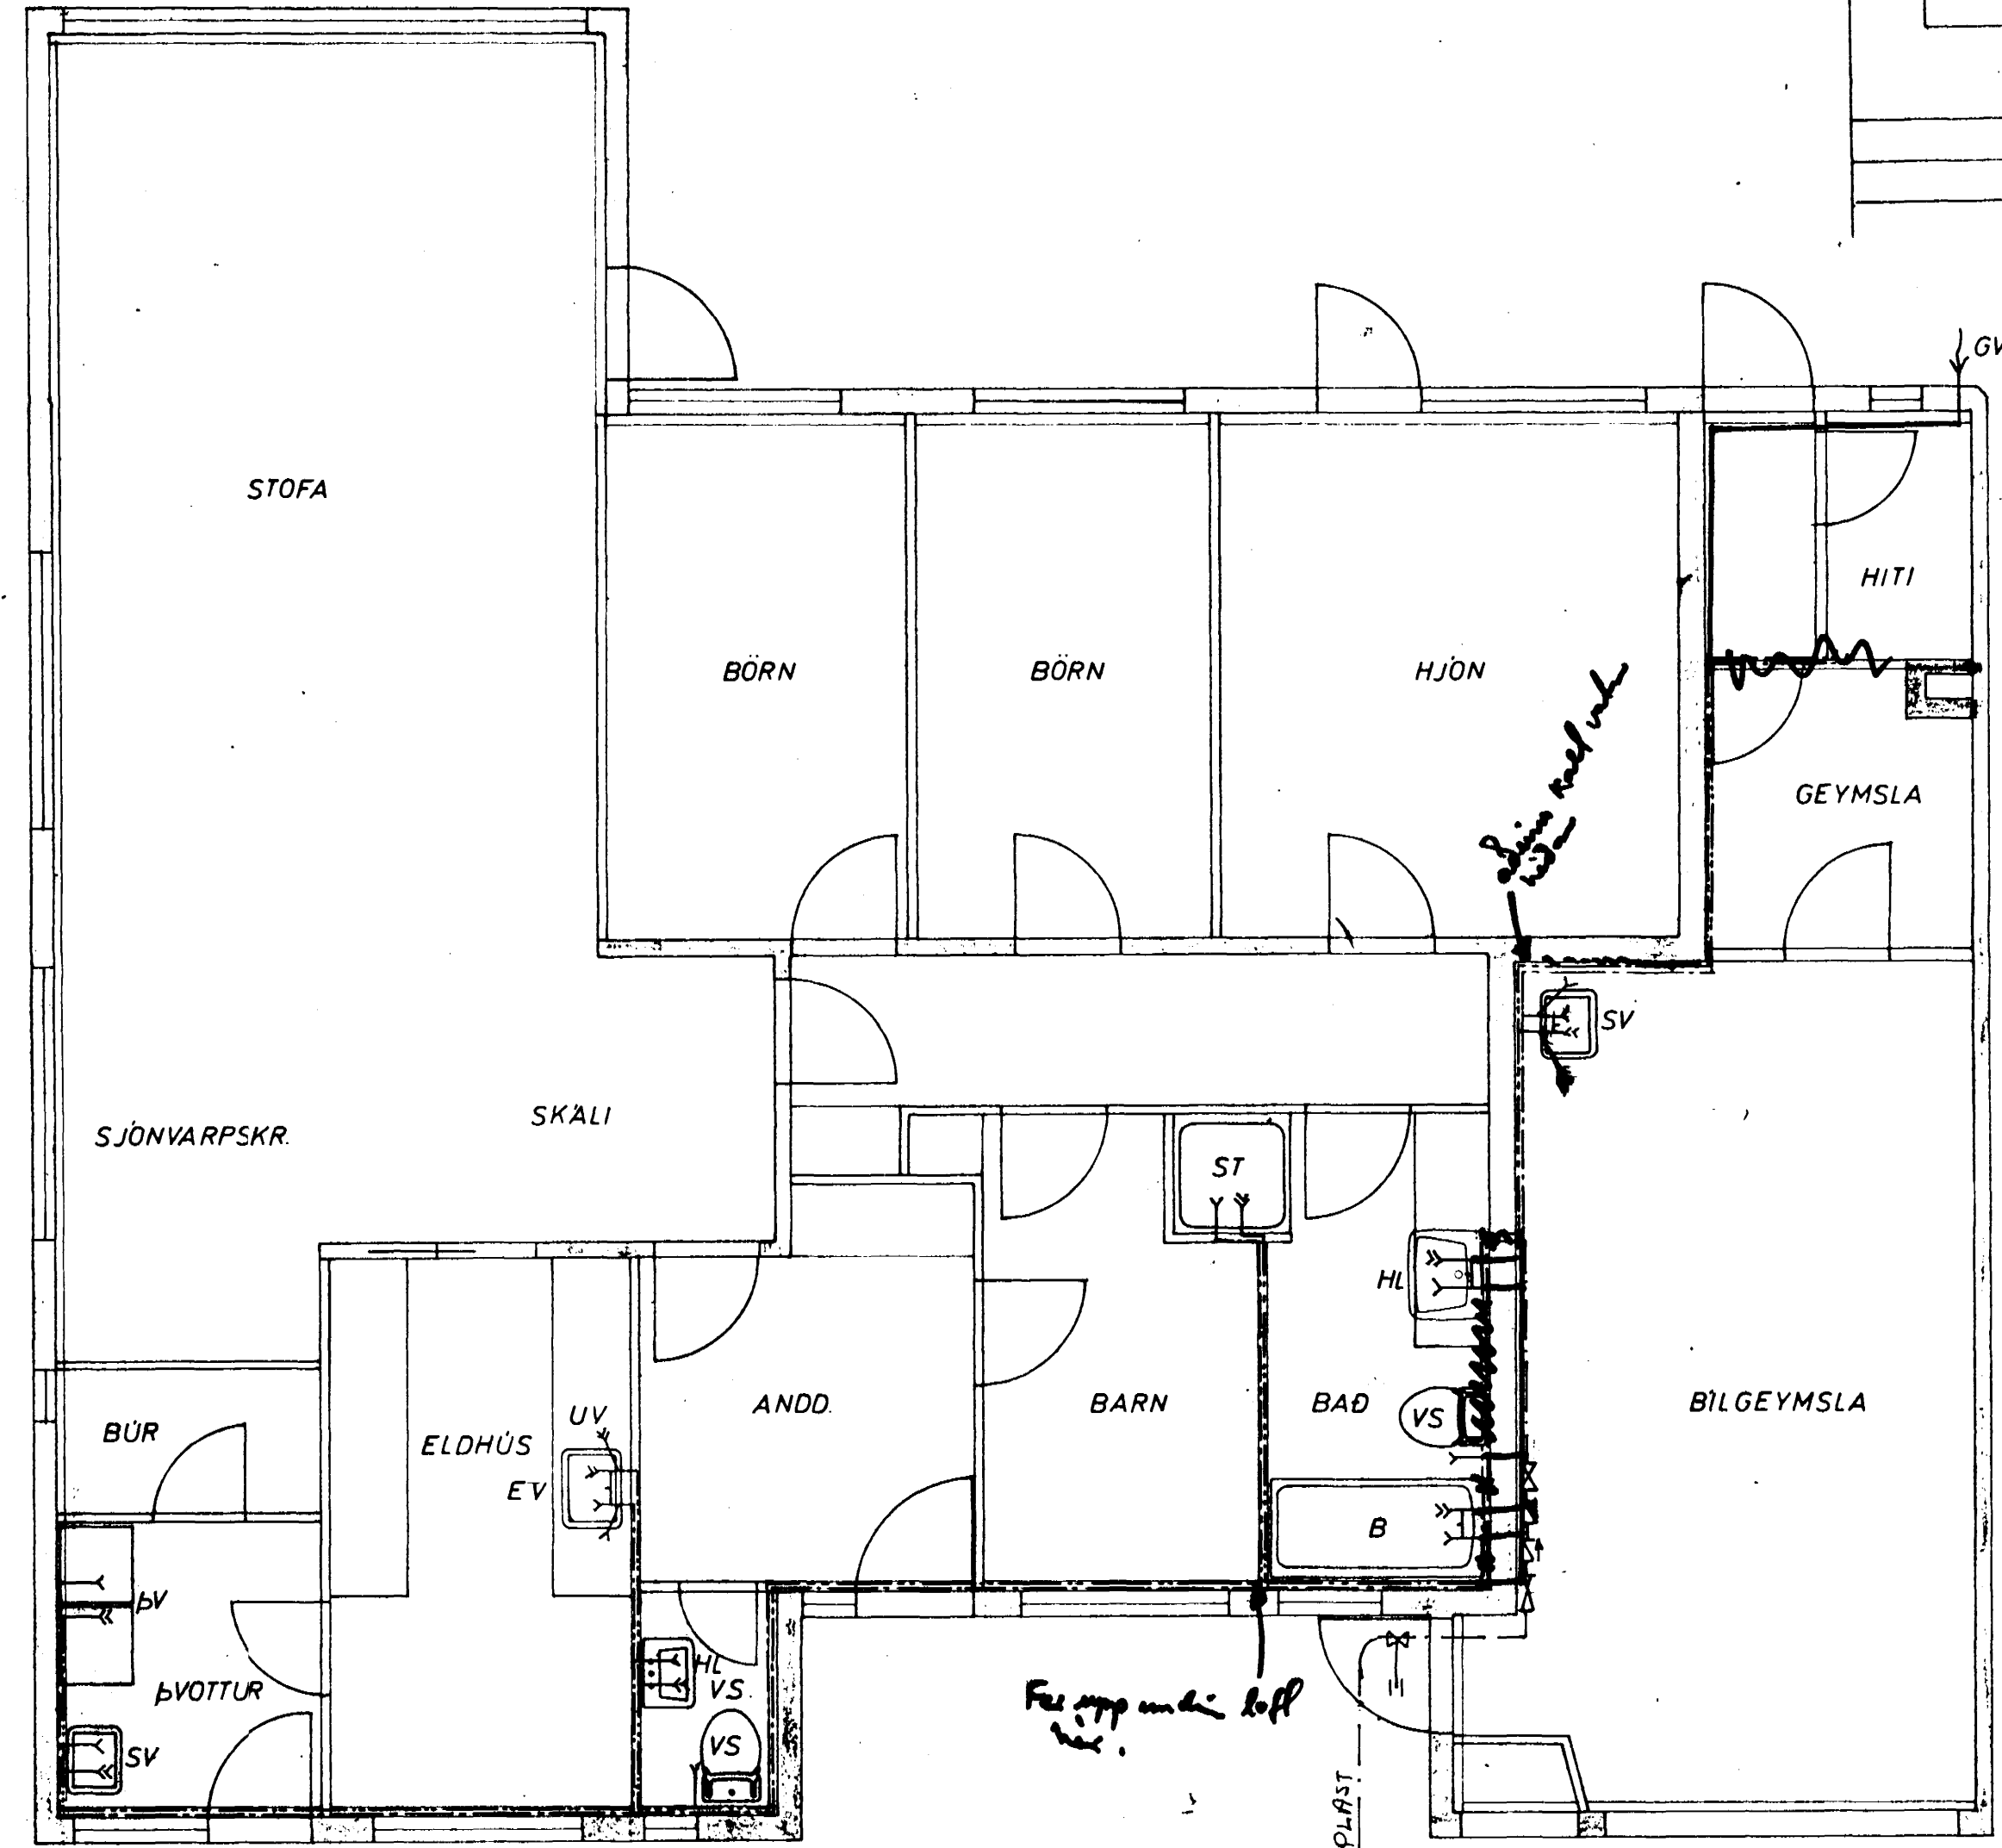

BREIÐVANGUR 15	MÆLIKVARÐI 1:50 1:500	VERK 7311	TEIKN NR 6
VATNSLÖGN GRUNNMYND	Hanna Teiknað: <i>[Signature]</i>	Yfirfarir: Samp: <i>[Signature]</i>	DAGS JÚLÍ '73
JÓHANN GUNNAR BERGPÓRSSON VERKFR MVFI KÖLDUKINN 9 - HAFNARFIRÐI - Sími 52895	BREYTT		