



AFSTADA 1:500

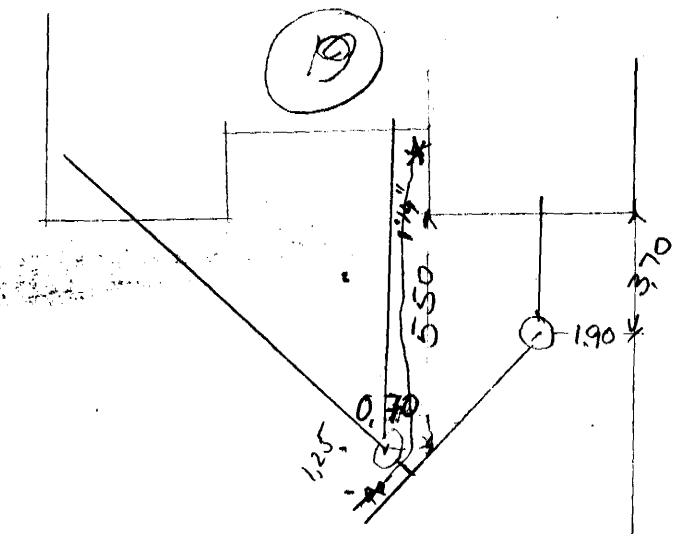

FRÆRENNSLI:
 EFNI OG FRAGANGUR LAGNA
 SKAL VERA SAMKVÆMT
 BYGGINGASAMÞYKKT HAFNARFJARDAR
 OG REGLUGERD UM HOLRÆSI
 Í REYKJAVÍK.

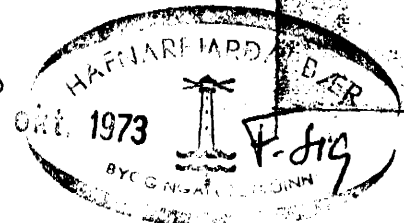

GRUNNMYND 1:50

| | | | |
|-----------------------------------------------------------------------------------|-----------------------------|-------------------------|------------------|
| BREIDVANGUR 19 | MÆLIKVARÐI 1:50 1:500 | VERK 7311 | TEIKN NR 4 |
| FRÆRENNSLISLÖGN GRUNNMYND | Hannað: JS Teiknað: JLL | Yfirfarir: Samb: GIB | DAGS JÚLÍ '73 |
| JÓHANN GUNNAR BERGPÓRSSON VERKFR M.V.F. KÖLDUKINN 9 - HAFNARFIRÐI - Sími 52885 | BREYTT | | |