


GRUNNMYND 1 : 50

Breyttur K10, K8  
 27/7-76.  
 Sæðf. undirskrift J.G.B.  
 E. Sig

SKÝRINGAR SJÁ TEIKN. NR. 12 OG SNÍÐ TEIKN. NR. 16

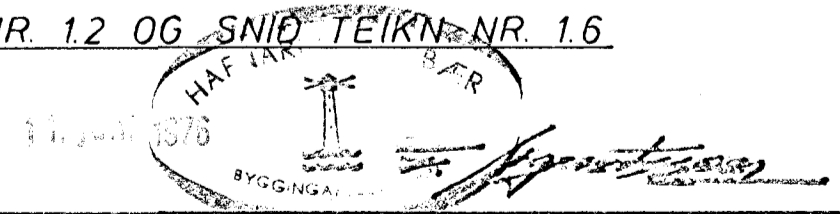

<b>BREIDVANGUR 20</b>	MÆLIKVARDI 1 : 50	VERK 7602	TEIKN NR 1.3
<b>PLATA YFIR 1,2 OG 3 HÆÐ</b>	Hannað: <i>JSB</i> Teiknað: <i>JSB</i>	Yfirfarð: <i>JSB</i> Samb: <i>JSB</i>	DAGS MÁÍ '76.
<b>JÓHANN GUNNAR BERGPÓRSSON</b> VERKFR MVFI STRANDGÖTU 11 — HAFNARFIRDI — SÍMI 53315	BREYTT		