


NR	HITATAP KCAL/T	OFN - PANEL	TENGI
001		P/740/1680	AB
002		P/740/1680	AB
003		P2/740/1680	CD
120			
220		P/590/640	CD
320			
420			
121			
221		P2/590/1280	AB
321			
421		P2/590/1360	AB
122			
422		P3/500/2160	CB
222			
322		P2/500/2160	CB
123			
223		P2/500/1360	CD
323			
423			
124			
224		P/590/1600	AB
324			
424		P2/500/1360	AB
125			
225		P/590/1440	AB
325			
425		P/590/1520	AB
126			
226		P/590/1440	AB
326			
426		P/590/1520	AB
		OFN - RUNTAL	
127			
227		C 28/2/600	AB
327			
427			

ALLIR OFNAR ERU MED 10 mm TENGINGUM.

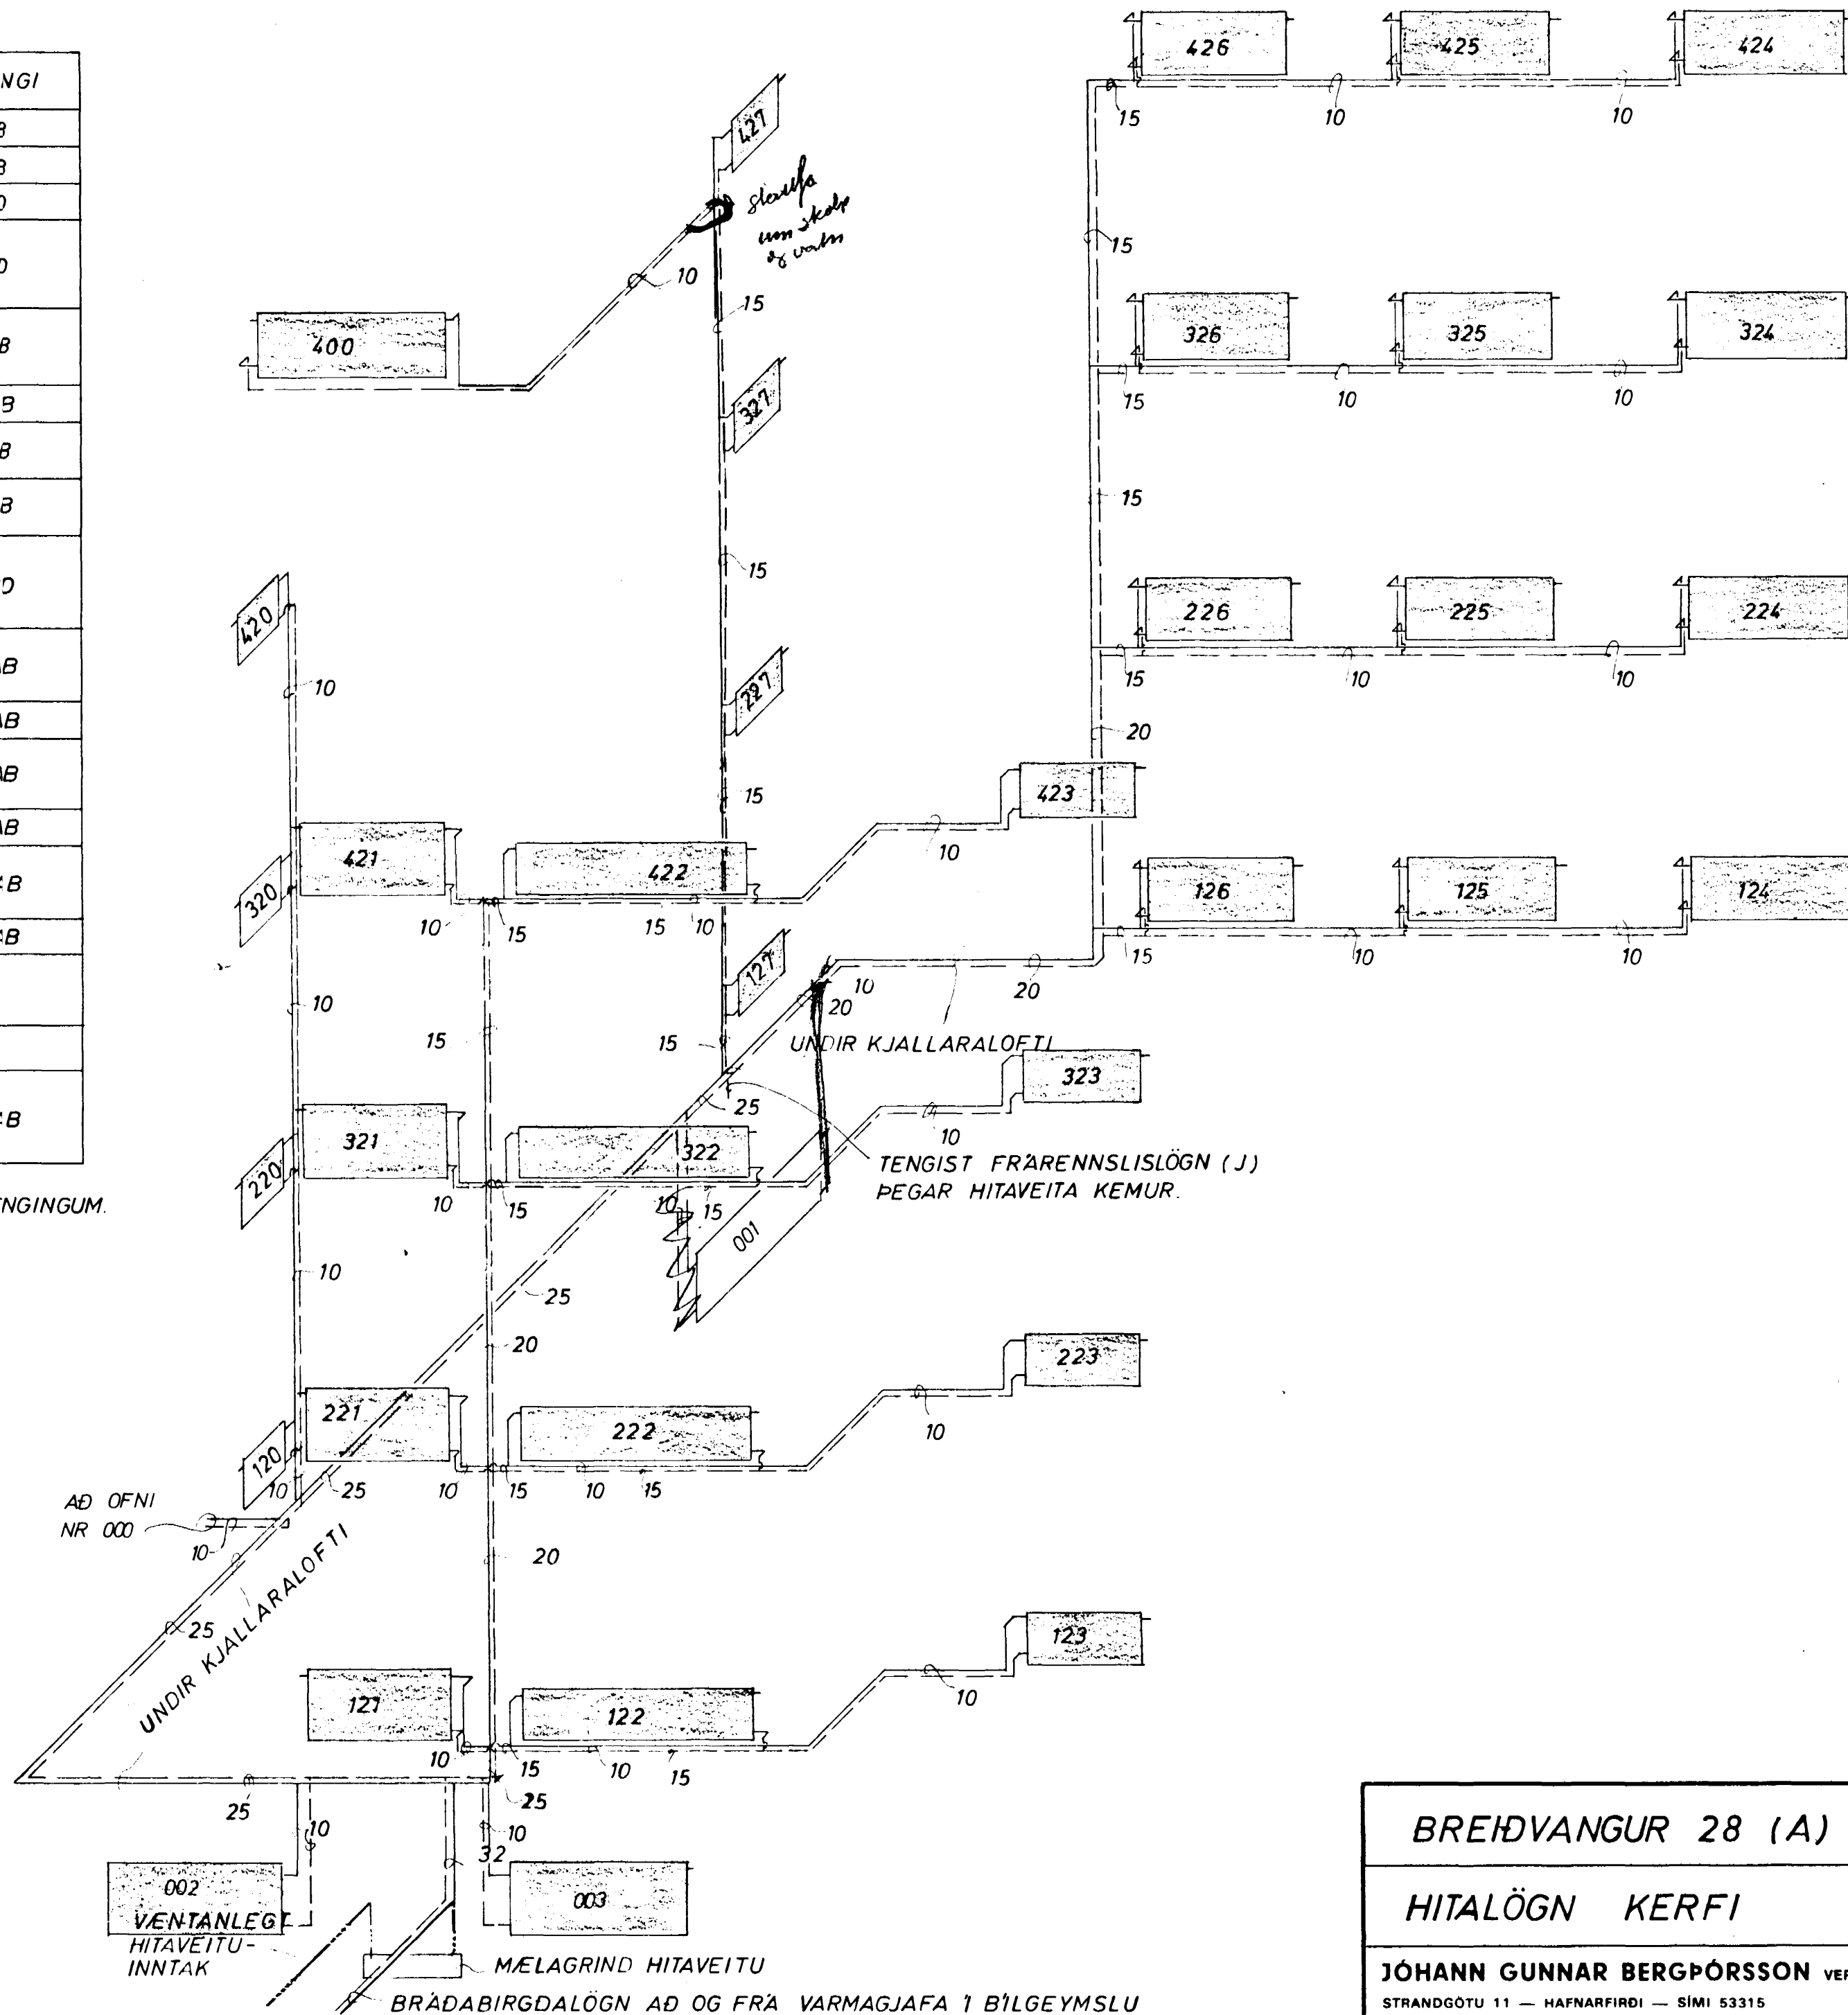

BREIÐVANGUR 28 (A)	MÆLIKVARÐI 1:50	VERK 7402	TEIKN NR 17
HITALÖGN KERFI	Hannað ✓ Telknað: ✓	Yfirfarið: JGB Samb: JGB	DAGS JÚNÍ '74
JÓHANN GUNNAR BERGPÓRSSON VERKFR MVFI STRANDGÖTU 11 - HAFNARFIRÐI - SÍMI 53315	BREYTT		