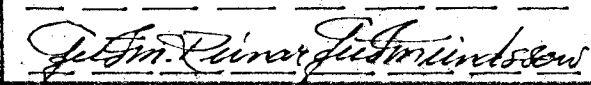


BADKER OG STEYPIBAD SKAL SERSTAK-
LEGA. JARDBUNDIÐ MEB 6° I 5/8\"/>

BREYTT 3.7. '74. & 23.8. '74

GRUNNMYND 2. HÆÐ MKV = 1:50

TEIKNISTOFA HAFNARFJARDAR-6:51834	
BREIÐVANGUR 28(A) HAFNARFIRÐI	
RAFLAGNATEIKNING	
MKV = 1:50	
DAGS: MAI 1974	
TEIKN.NR: 22-5-74	
TEIKNAR: GRG	