


Stærð Vatnslasa
 V.S. 100/100
 B 40/50
 EV 40/50
 HL 32/40
 HN 50/70 Eyfir hitau.

Breidvangur.
 1:500.

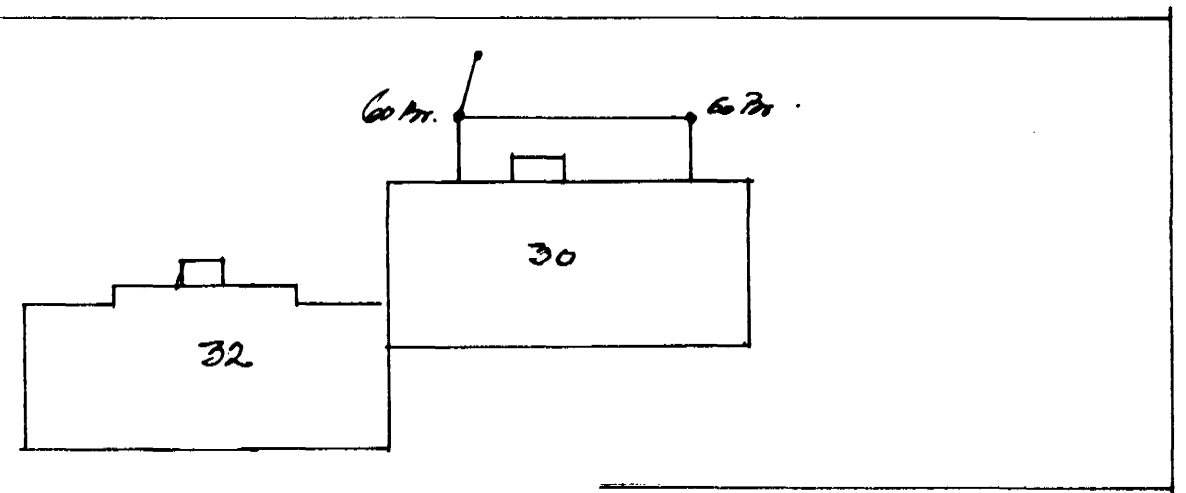

BREIDVANGUR 30 Holtesí	243	
	TEIKN	kael
Kobani E. G. Jónsson Töknfr.	kael	
	TEIKN Nr. BLb 7407	