
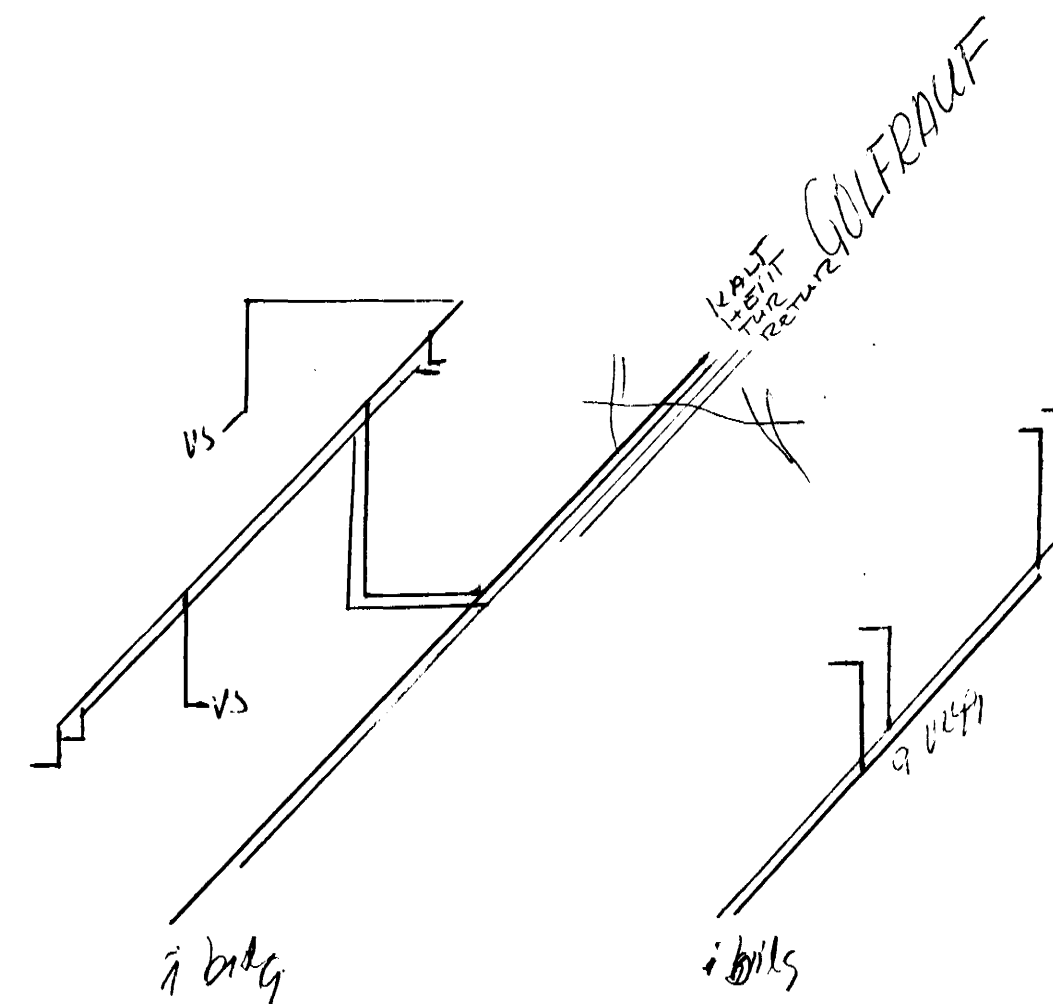



KERFI ~1:50

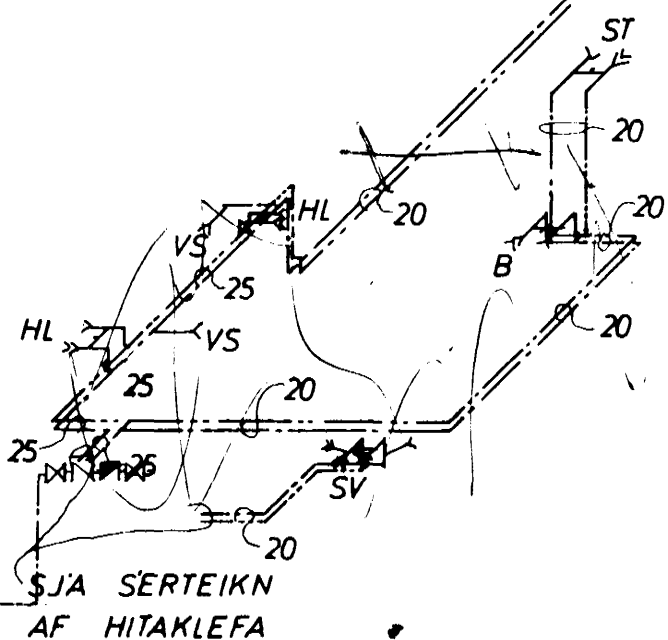

SKÝRINGAR:

- KALT VATN
- - - HEITT
- KALDAVATNSKRANI
- HEITA
- RENNILOKI
- MED SPINDLI UPPUR JÖRD
- EINSTREYMISLOKI
- VATNSMELIR
- GV GARDVATN

PIPUR SKULU ERVANGRADAR MED 20MM  
 GLERULLARMÖKUM OG VAFBAR MED PLASTÖR  
 ALLT EFN. PIPUR OG FITINGS SKAL VERA  
 GALVANISERAD.  
 KERFI SKAL PROFA MED KÖLDU VATN OG  
 6 KG/cm<sup>2</sup> ÞRYSTINGU.  
 BALLÓFIX RENNILOKAR SEU VÍÐ NÝENT LOKI  
 EINSTREYMISLOKI VÍÐ LÖTTAFLAR.  
 FRAGANGUR INNÞAKS OG LOFTÞÖÐAR  
 SKV. FÖRSK. VATNSV. B.V.

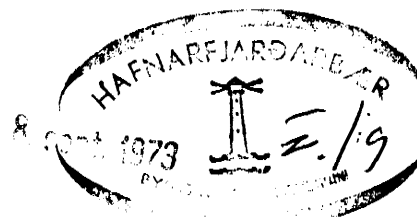

BREIDVANGUR 31	MÆLIKVARÐI ~1:50	VERK 7312	TEKNI NR 7
VATNSLÖGN KERFI	Hannað: AS Teiknað: AS	Yfirferð: Samp: JB	DAGS JULI '73
JÓHANN GUNNAR BERGPÓRSSON KÖLDUKINN 9 - HAFNARFIRÐI - Sími 52995	VERKFR MVF1	BREYTT	