




28. ág. 1973

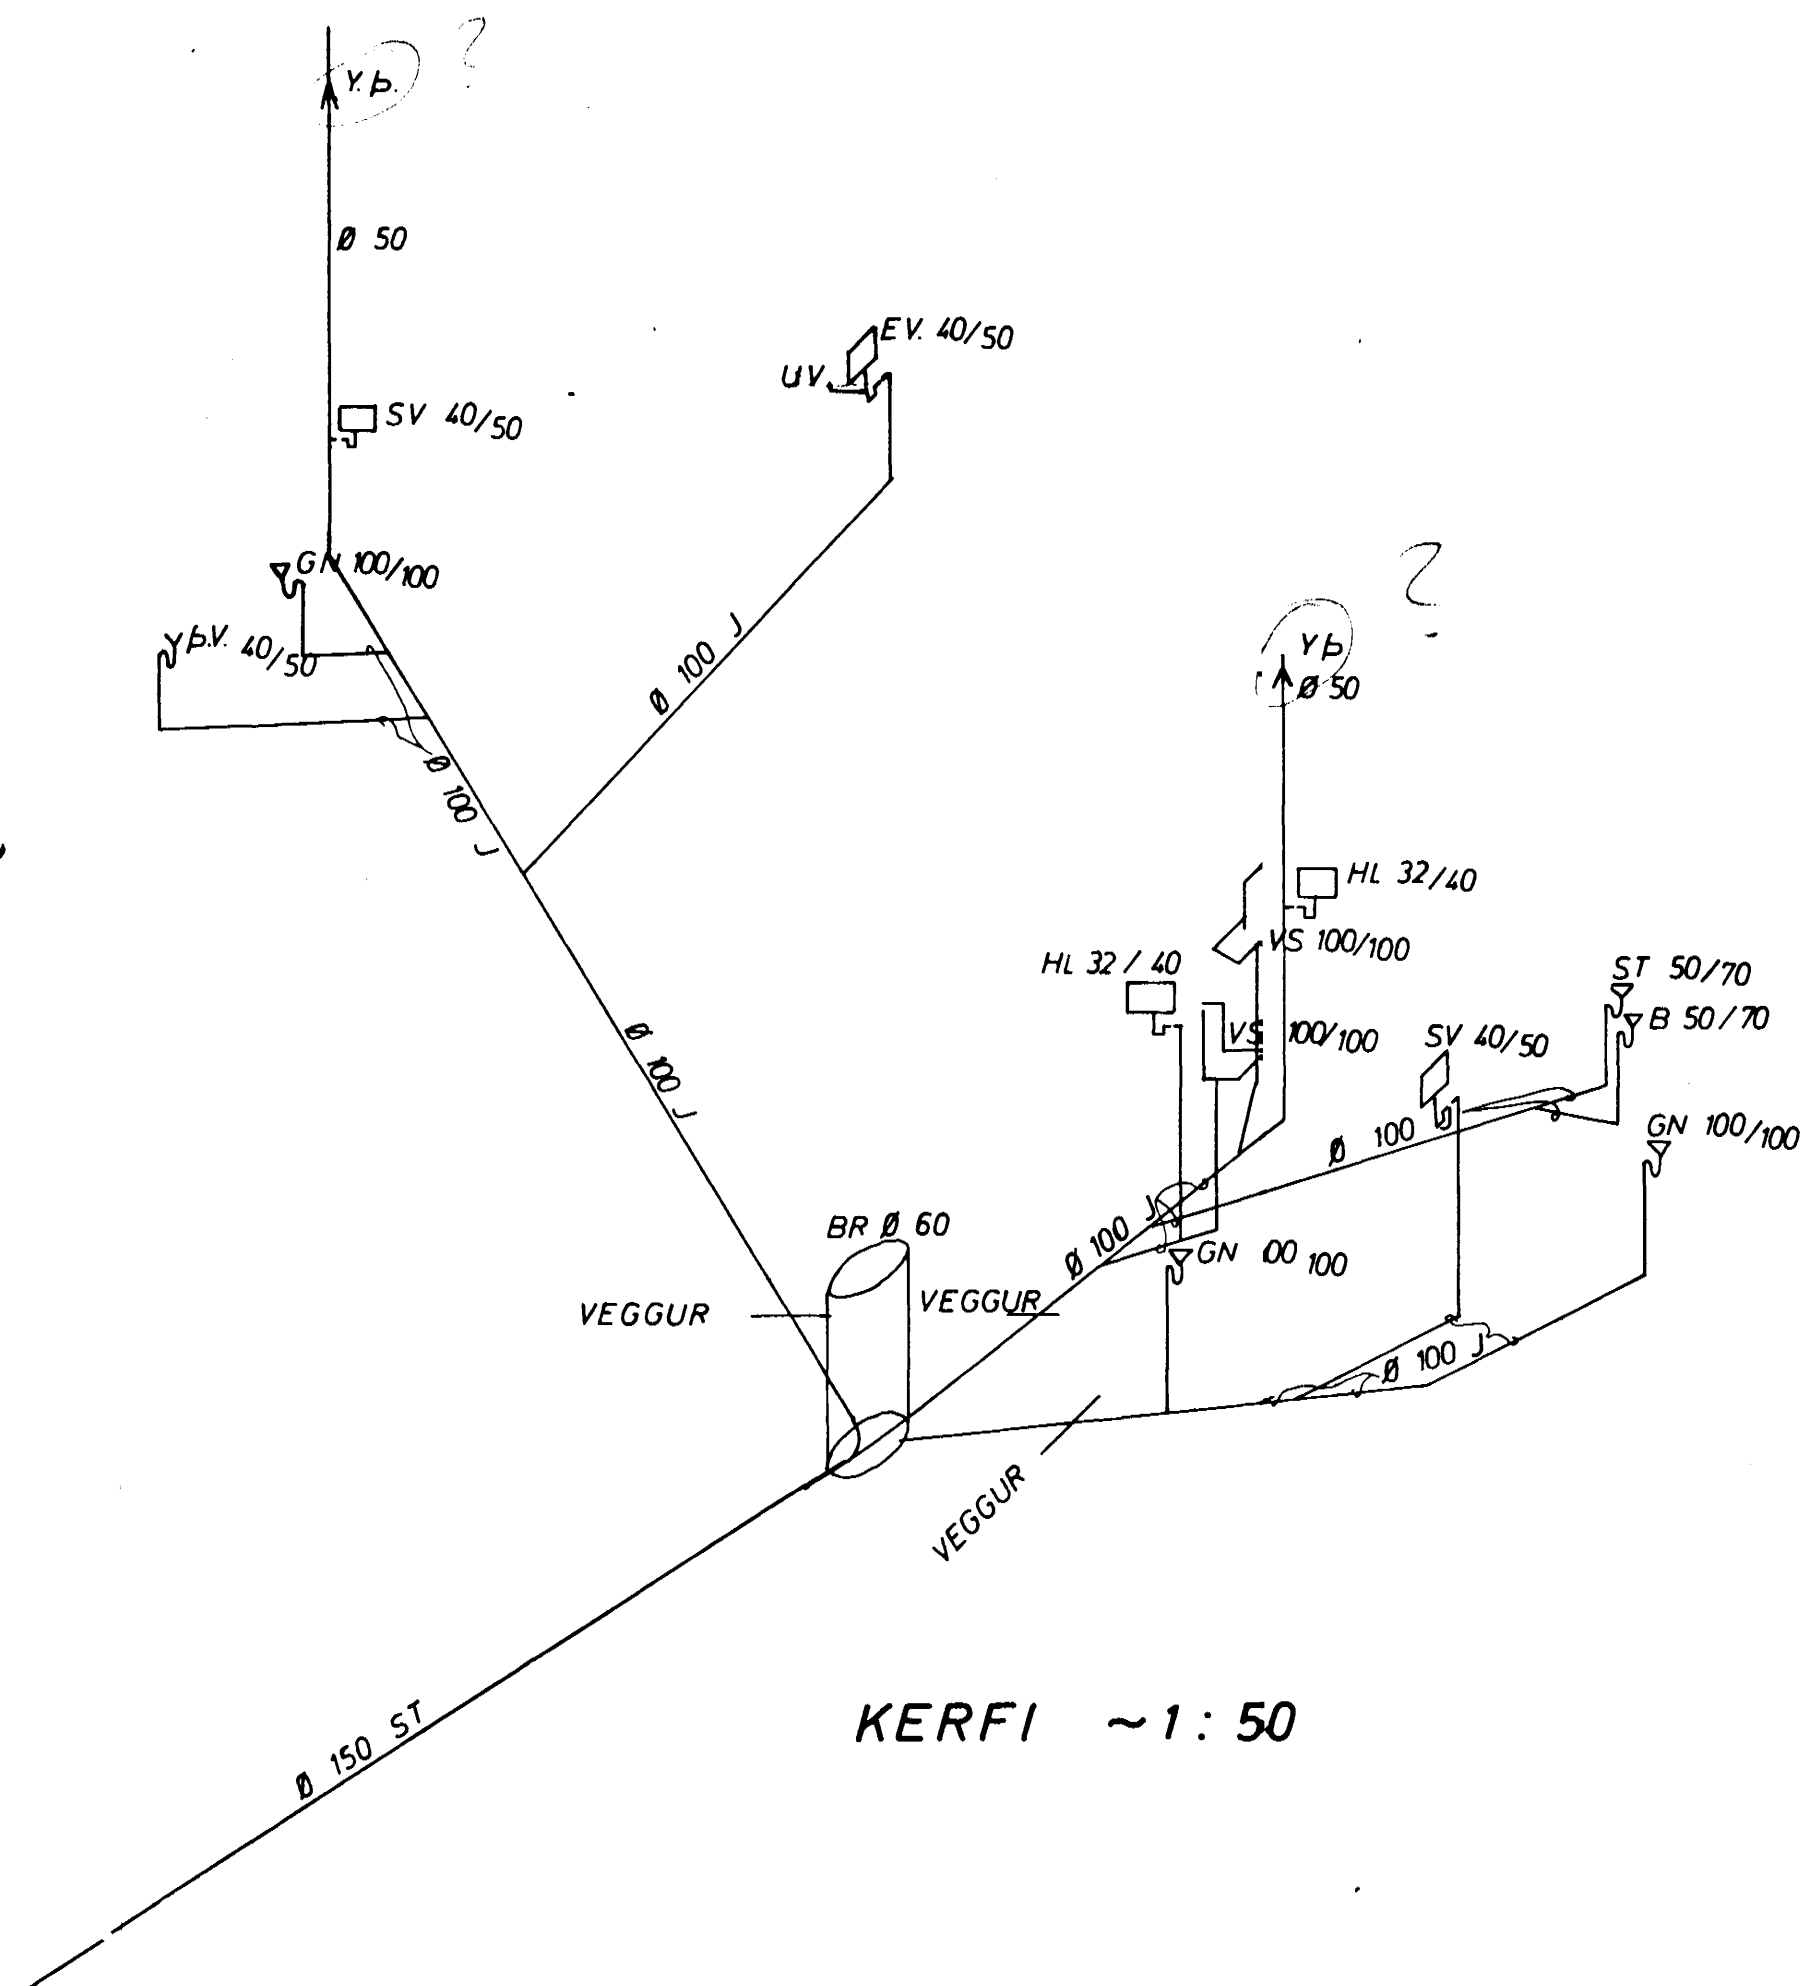

KERFI ~1:50

SKÝRINGAR:	
YS	VATNSSALERNI
HL	HANDLAUG
S	STEYPIBAD
B	BAD
SV	SKOLVASKUR
ÞV	ÞVOTTIÞVÆL
EV	ELDHÚSVASKUR
UP	UPPÞVOTTIÞVÆL
GN	GÖLFNDURFALL
Þ	ÞAKNDURFALL
ST	STEYPIRÖR
J	STEYPIJARNSKÖR
BR	BRUNNUR

BREIDVANGUR 37	MELIKVARDI ~1:50	VERK 7312	TEIKN NR 5
FRÆRENNISLÖGN KERFI	Hannað: AP Teiknað: AS	Yfirfarð: Samb: JB	DAGS JULÍ '73
JÓHANN GUNNAR BERGPÓRSSON VERKFR MVMÍ KÖLDUKINN 9 - HAFNARFIRÐI - Sími 52895	BREYTT		