


Rauf f. V5 má ekki komi vegna milli stöðva.

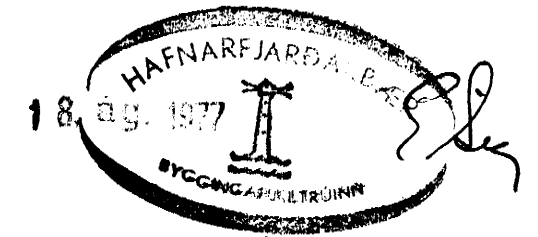

Sjá athugasemdir

Benedikt B. Sigurðsson		veftr.
Breiðvangur nr. 3		
M.	1:50	Varnslagn
D.	29. 77	Leiðslukerfi
Nr.	11. bl.	Ben. B. Sigurðsson