
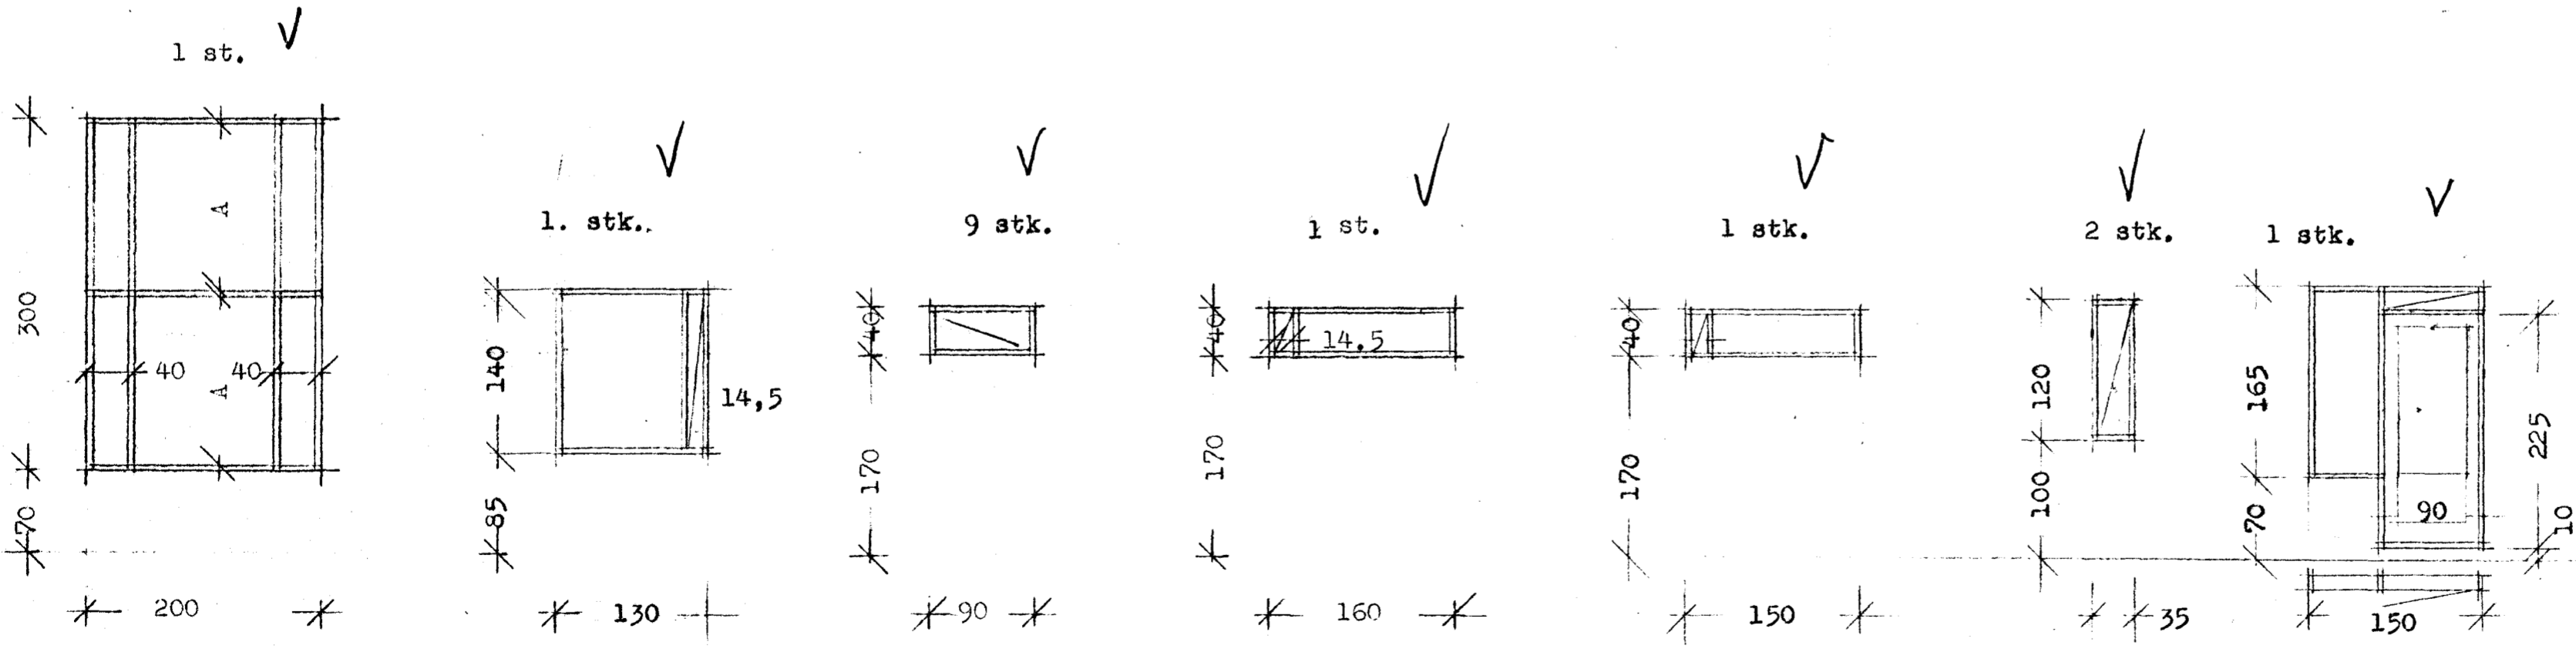


Sýnir opnulegt spjald.

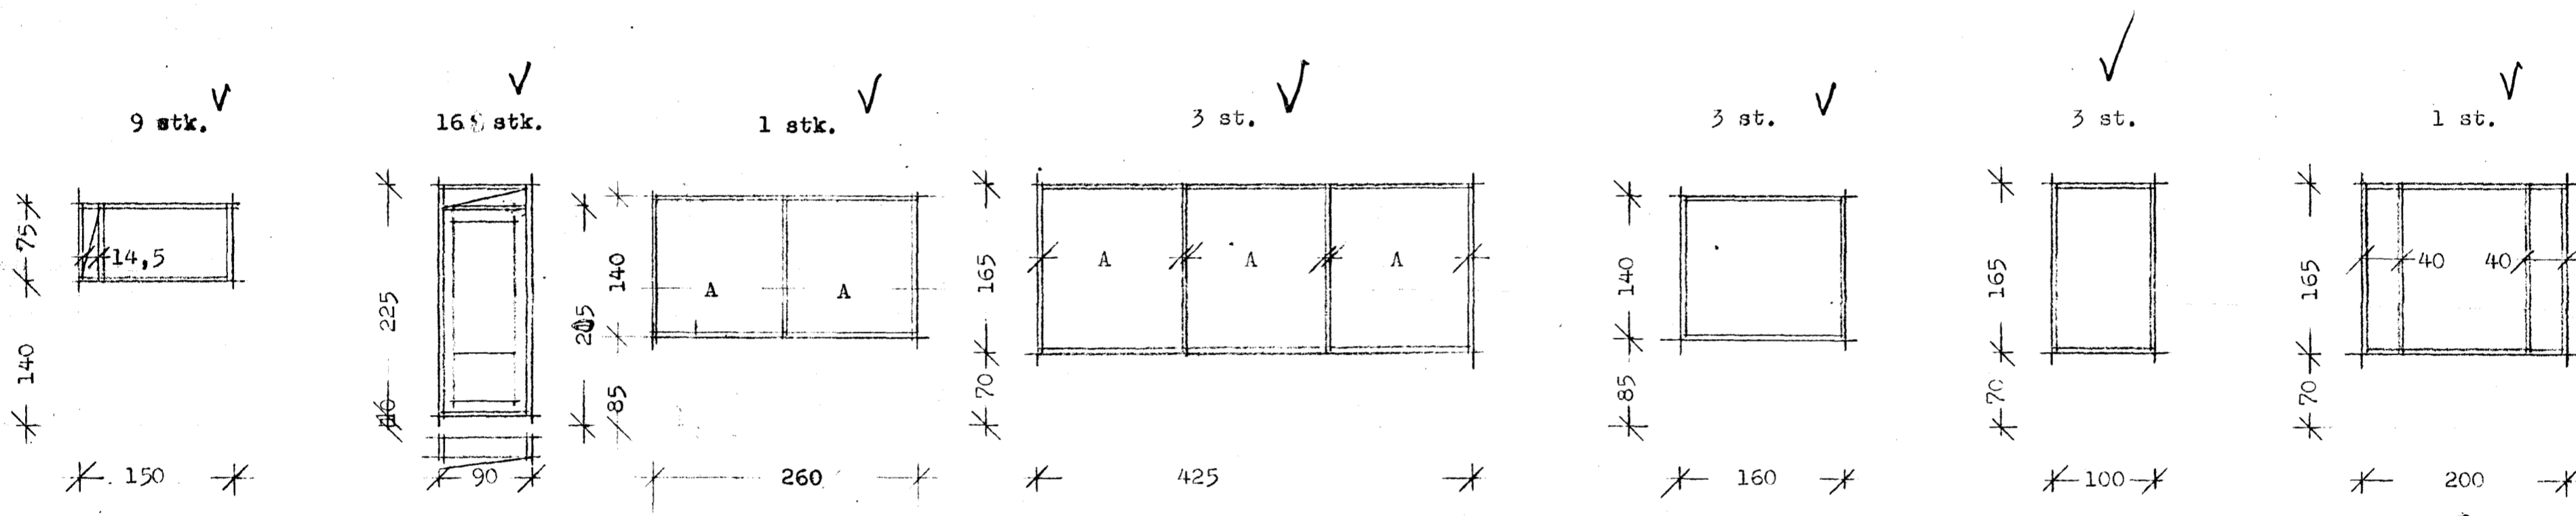

Reykjavík / 1 des. 1976.
 S. Gertan Sveinsson