


GRUNNMYN. 1:50

OFNÁLISTI

NR	GERIÐ	HÆÐ	LENGD	TENING
A1	VK2	63	900	φ10 AD
A2	V	63	800	φ10 AD
A3	VK	63	1800	φ10 AD
A4	V2	63	1400	φ10 AD
A5	V2	63	1300	φ10 BC
A6	V	63	1000	φ10 AD
A7	VK2	63	1300	φ10 BC
A8	VK2	28	4500	φ15 BC
A9	V	63	1300	φ10 BC
A10	V	63	1300	φ10 BC
A11	V	77	5000	φ15 AD
A12	V	77	1500	φ10 AD
A13	V	77	1500	φ10 AD
B1	VK2	63	900	φ10 AD
B2	V	63	700	φ10 AD
B3	VK	63	1300	φ10 AD
B4	V2	63	1300	φ10 AD
B5	V2	63	1300	φ10 BC
B6	VK2	56	2000	φ15 BC
B7	VK2	56	1700	φ10 BC
B8	VK2	28	4400	φ15 BC
B9	V	63	1300	φ10 BC
B0	V	63	1300	φ10 BC

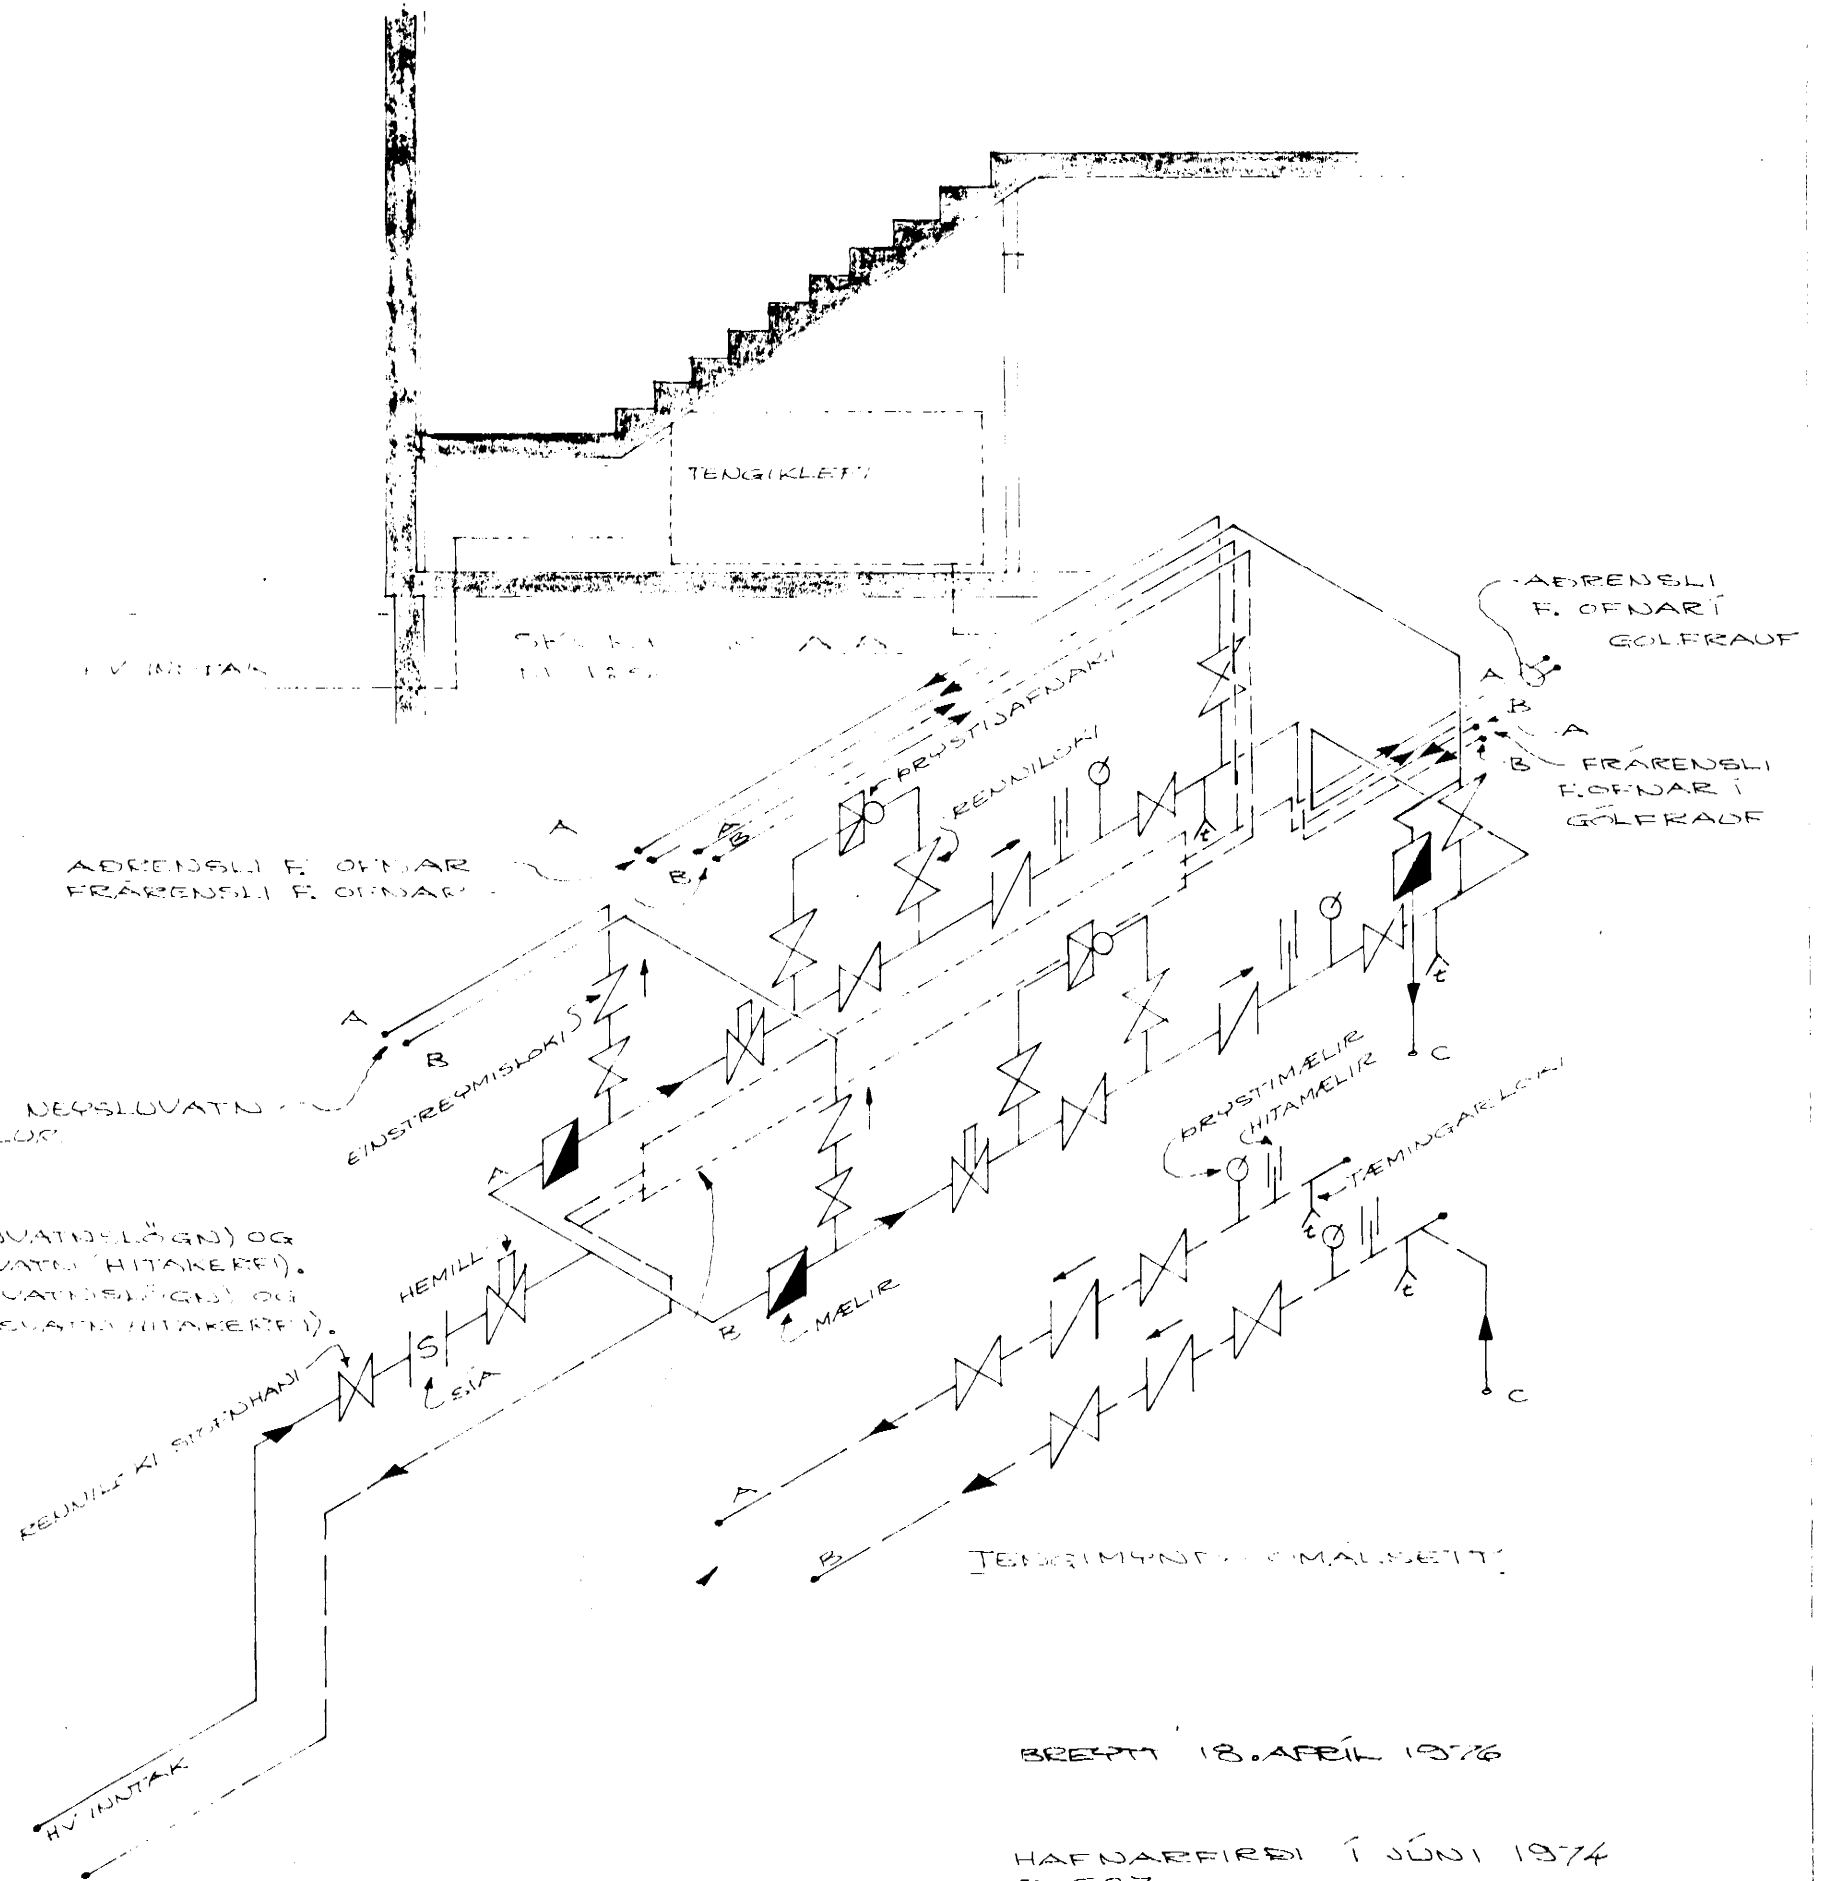

C = BILSKUR Geymslu  
 A = NLERI HÆF.  
 R = LEIÐ HÆF.  
 KALT VATN (NEPSLOVATN) OG  
 EINNIG AÐRENLSVATN (HITAKERFI).  
 HEITT VATN (NEPSLOVATN) OG  
 EINNIG FRÆNDELISVATN (HITAKERFI).

BRETTI 18. APRÍL 1976

 S0587  
 HITALÖGN  
 EFRÍ HÆÐAR

Ígual, Magnússon, MVEI.