


Samþykkt á fundi bygginga-  
nefndar þ. 6/6 1977  
BYGGINGAÞULLTRÚN  
Í HAFNARFIRÐI  
*F. Sigurðsson*

ATH! Sjá bl. 1.  
F. Sig.




VESTURHLID

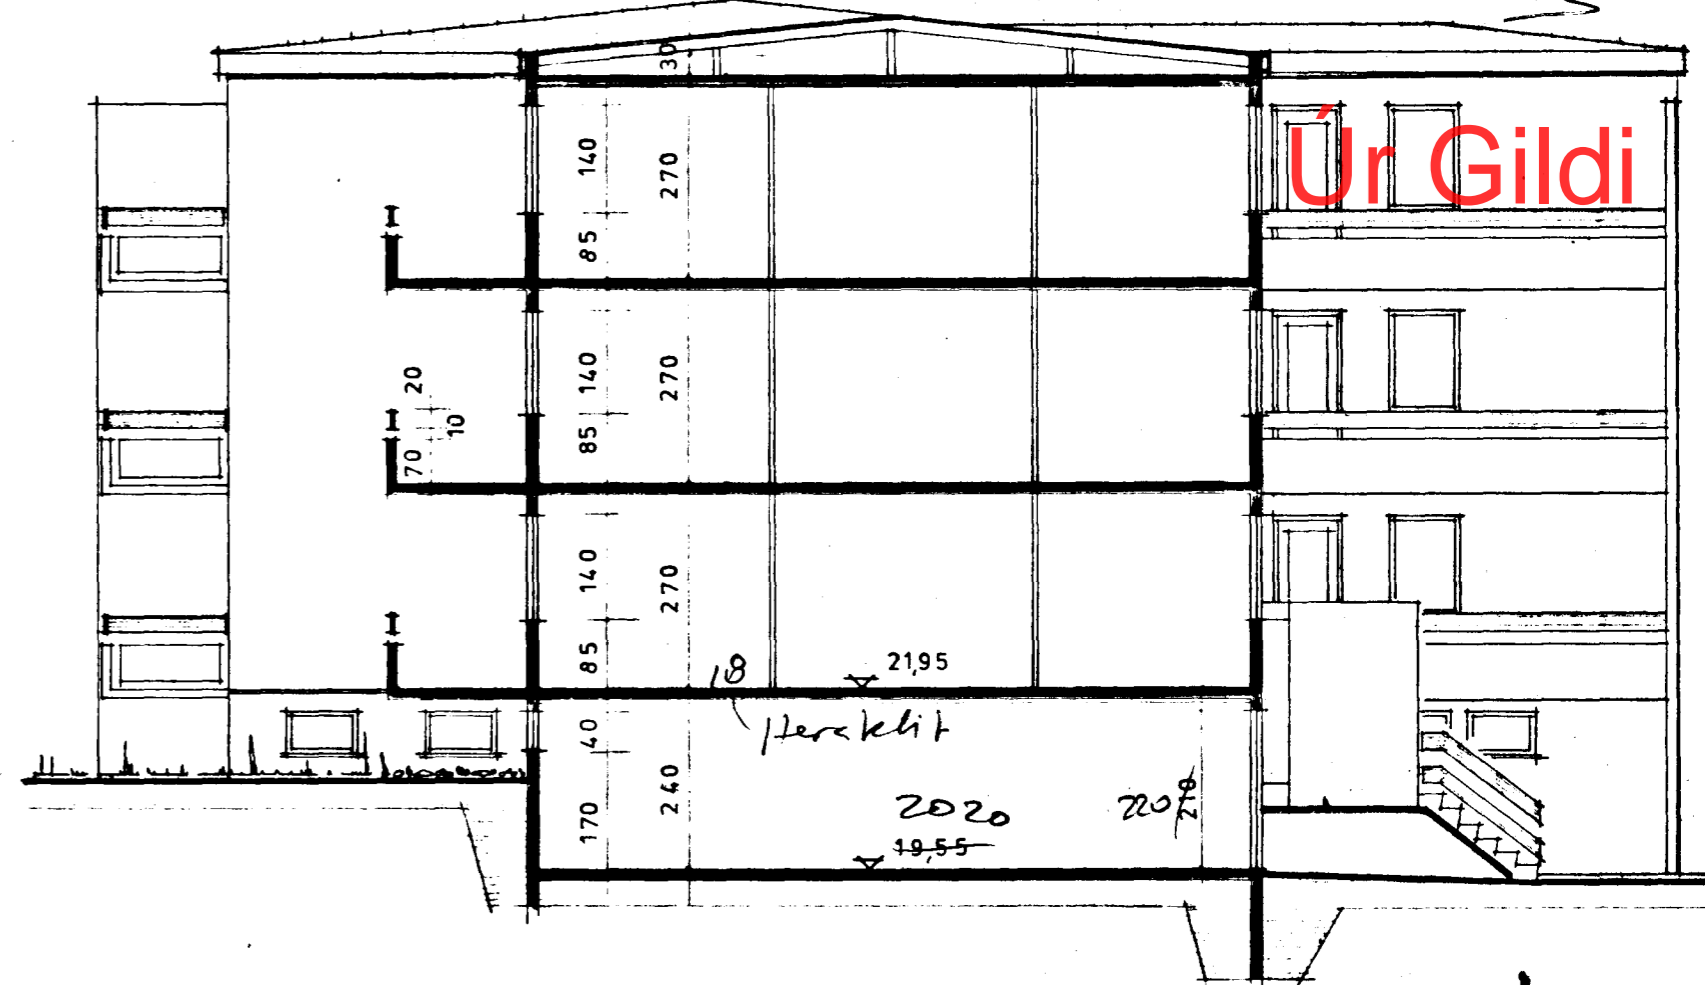

SNEIDING A-A


Úr Gildi

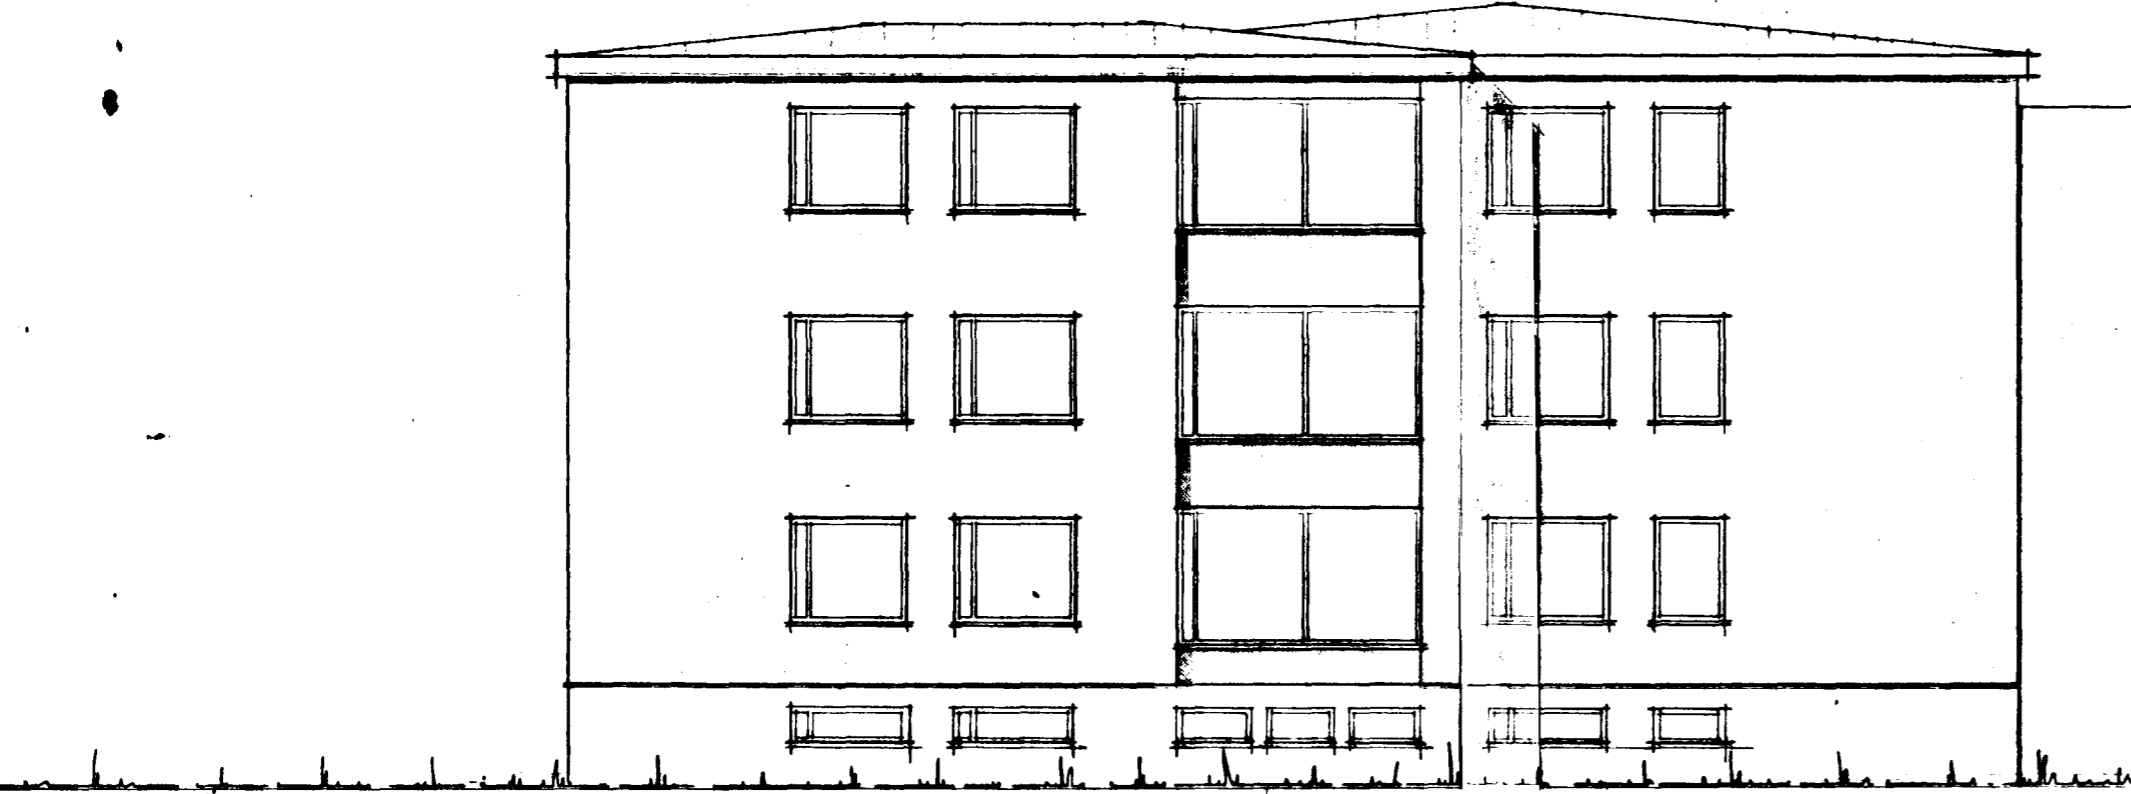

NORDURHLID

ATH. HÆBALEGA LÓBAR ER EKKI AKVEDIN

VERK **BREIDVANGUR 7**

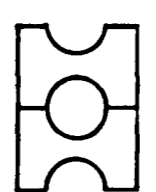	HEITI ÚTLITSMYNDIR, SNEIDING A A	TEIKN NR
	MKV 1:100 DAGS APRIL '77 REIKN YFIRF	<b>6</b>
VERK		

TEIKNISTOFA HAUKS HARALDSSONAR S.F. Sími 96-23202 AKUREYRI