


VATTN LAGAR HE. 32/40
 EV. 40/50
 D. 40/50
 SU. 32/40
 VS. 100/100
 BV. 32/40

STRAFSTÖÐUNYND.

Pr. 60cm

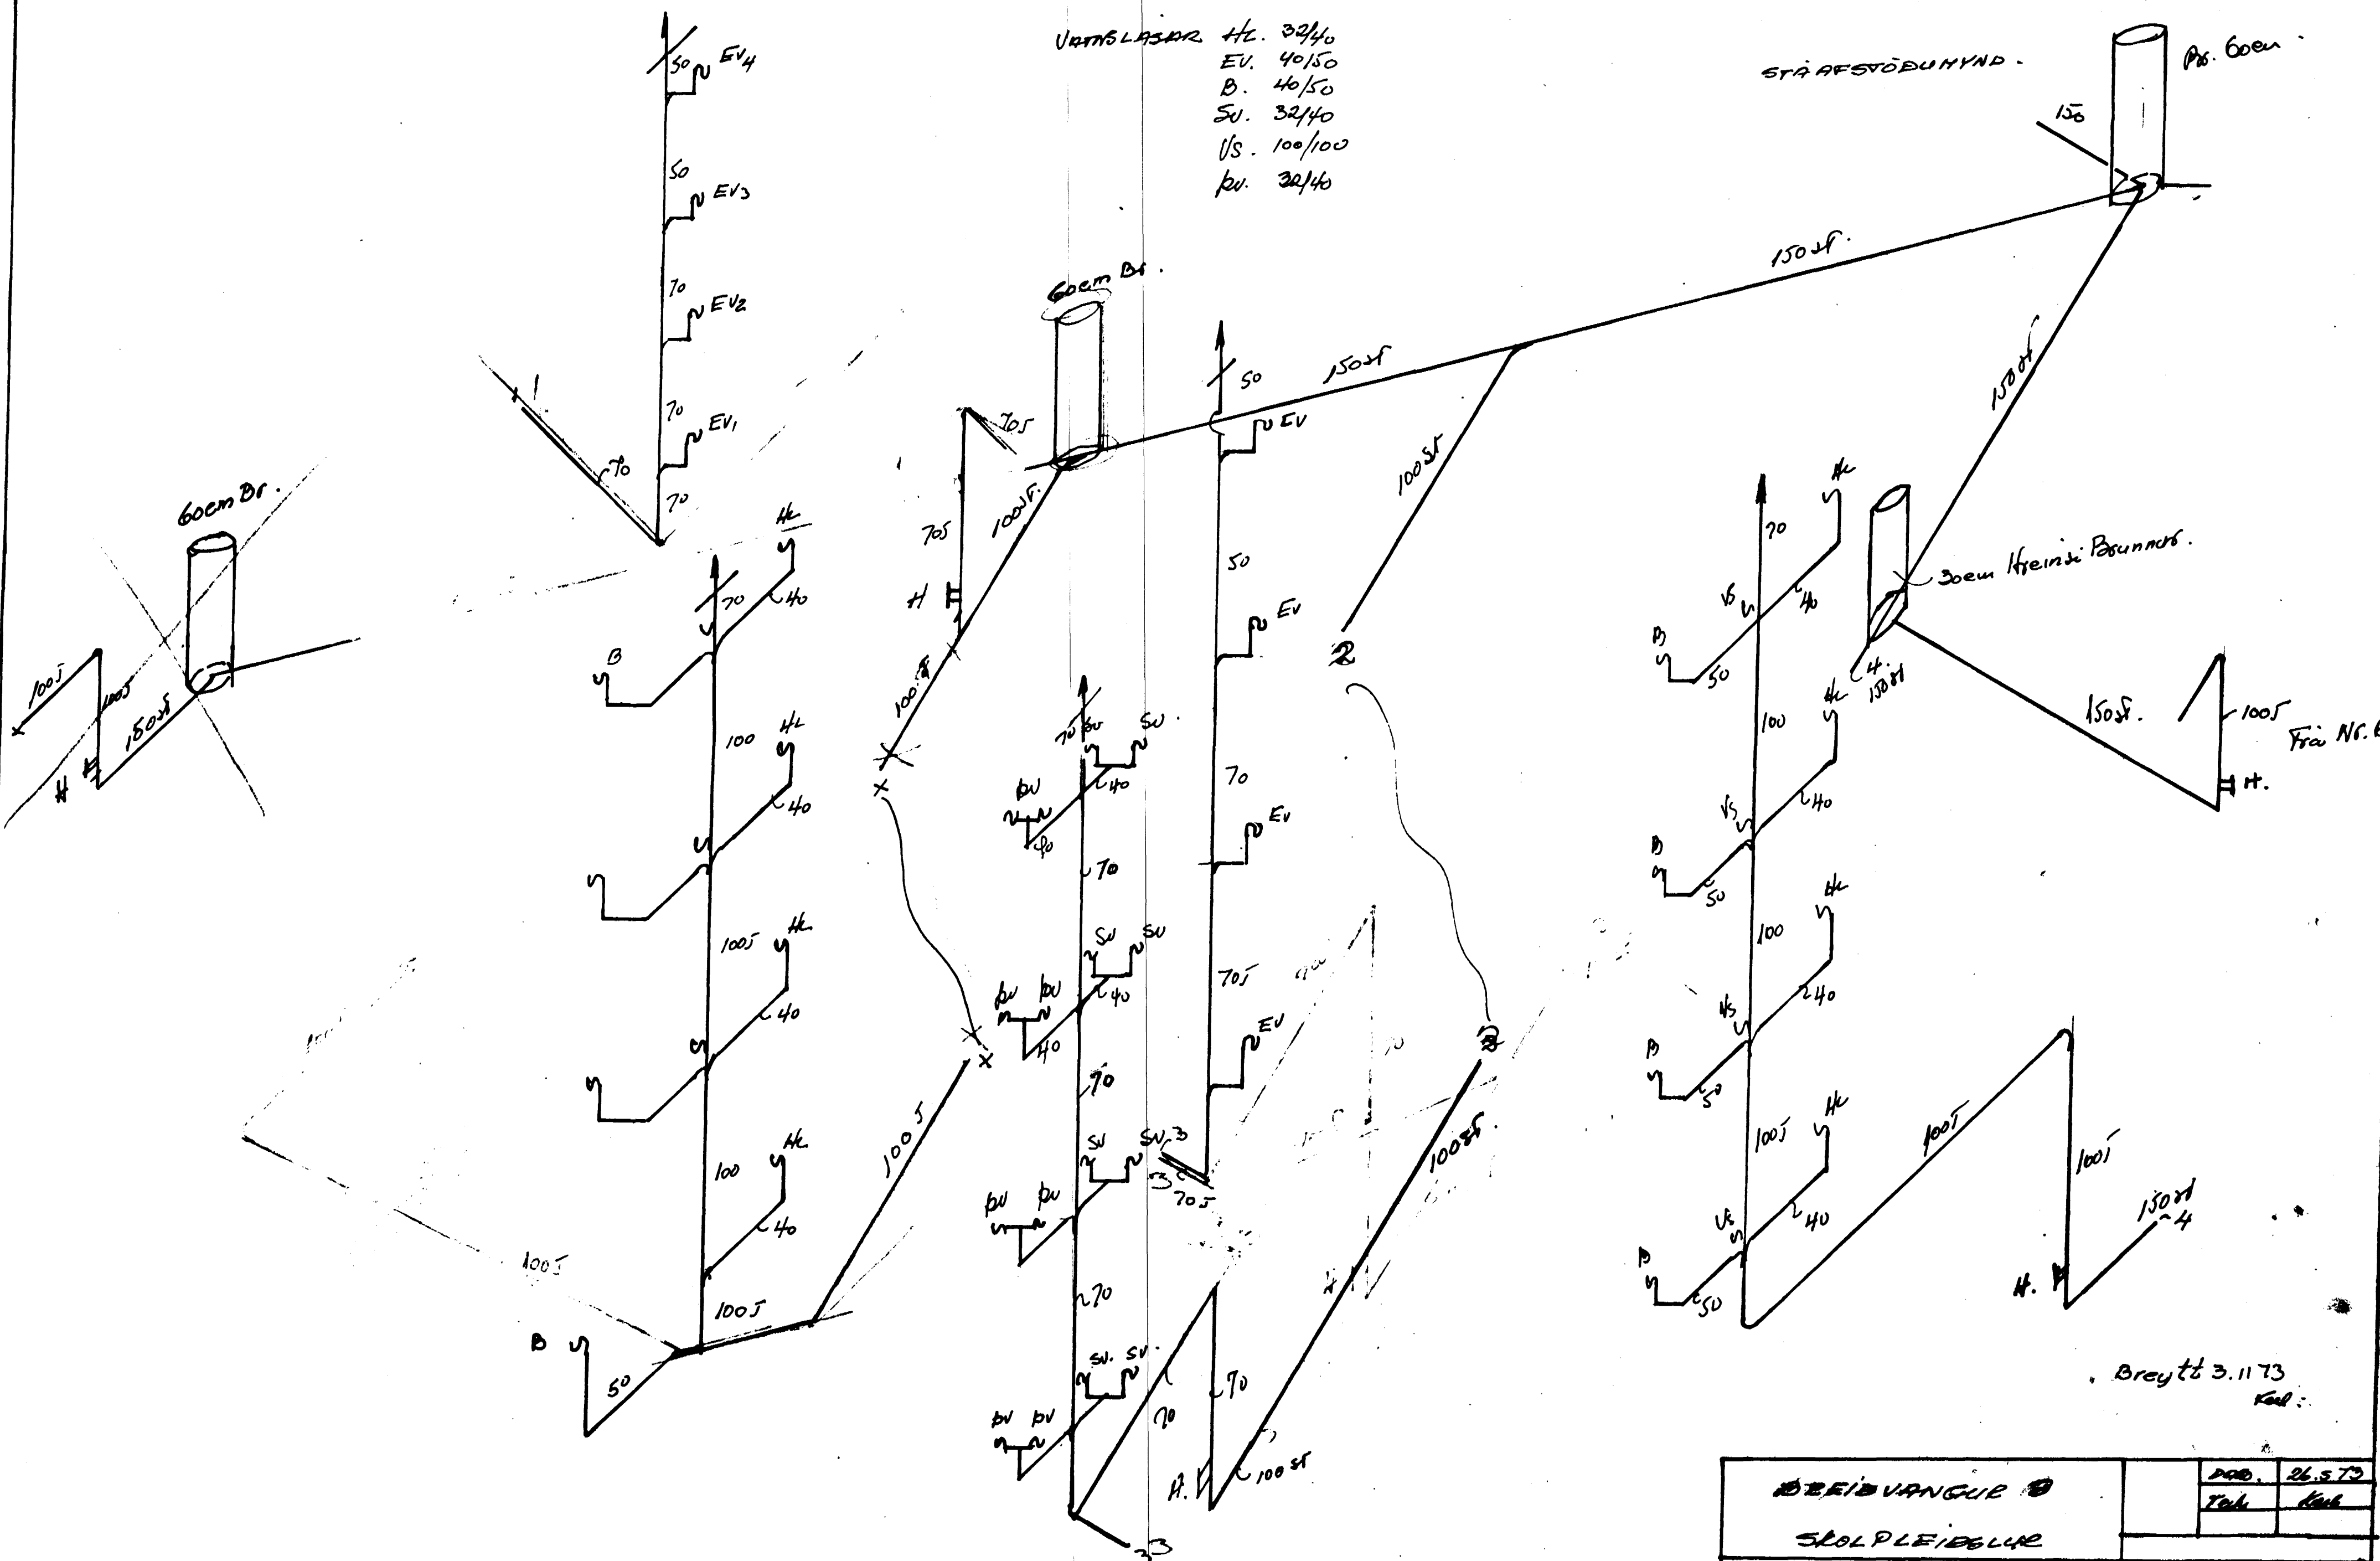

Breytt 3.11.73
Kall:

DEIÐVANGUR SKOLPLEIÐLUR	DDD. 26.5.73
	Tala Kall
Stefni Kf. Þouss Fabrik.	Tala Nr. 7317 Bl. 6