


Stendi lagna innf. of J.G.B. 1/2 '75
 Millifari of E. Sig.

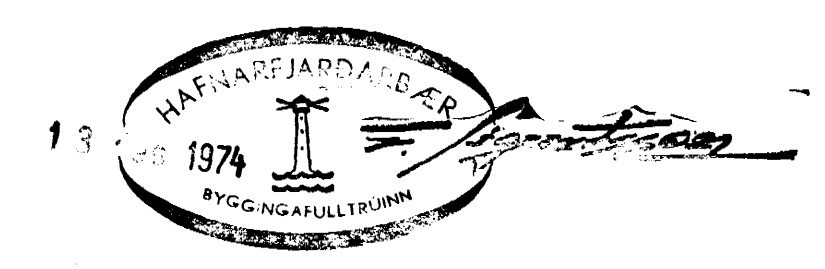

| | | | |
|--|-----------------------------------|---------------------------------|-----------------|
| BREIDVANGUR 9 | MÆLIKVARDI ~1:50 | VERK 7428 | TEIKN NR 10 |
| HITALÖGN KERFI | Hannað VG Teiknað: [Signature] | Yfirfarir: [Signature] Samb. | DAGS NOV '74 |
| JÓHANN GUNNAR BERGPÓRSSON VERKFR MVFI | BREYTT | | |
| STRANDGÖTU 11 — HAFNARFIRDI — SÍMI 53315 | | | |