

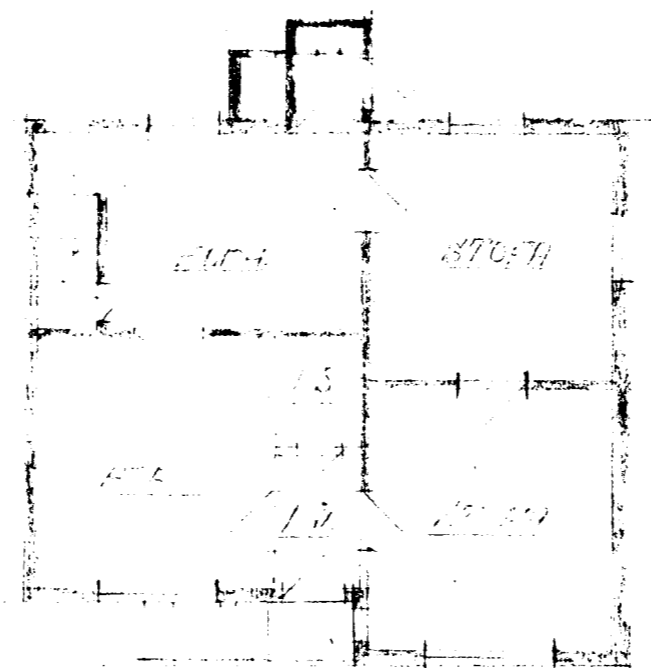




I. HED
 ETIR BRETINGU
 77.5 m²

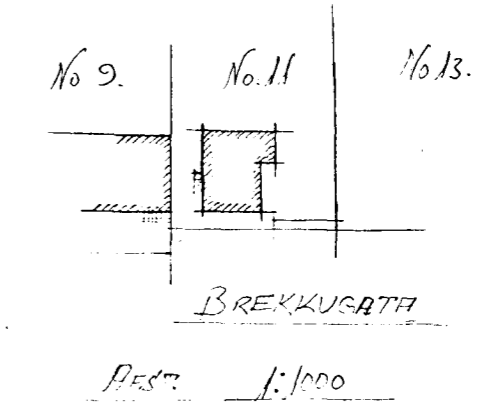

I. HED
 ETIR BRETINGU
 47.8 m²

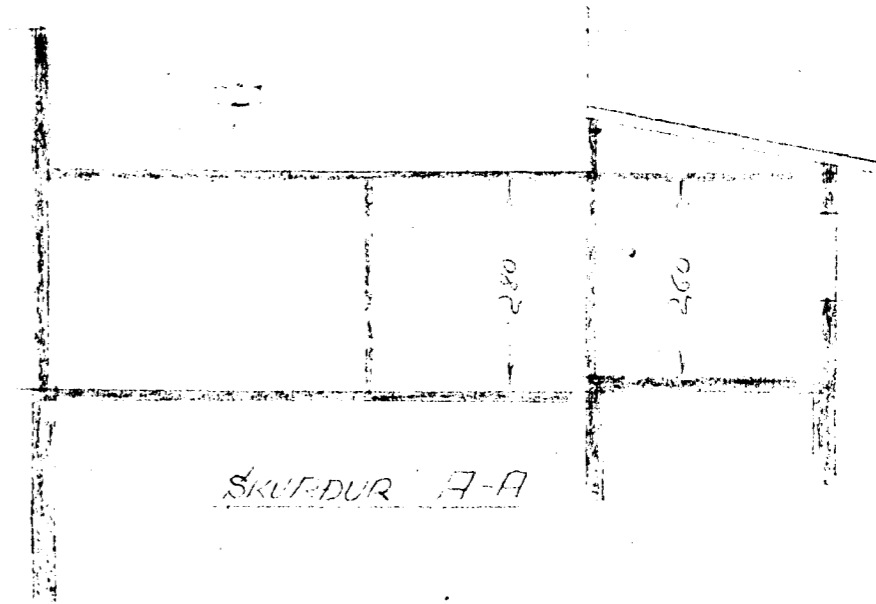

Sp. 2/5/58

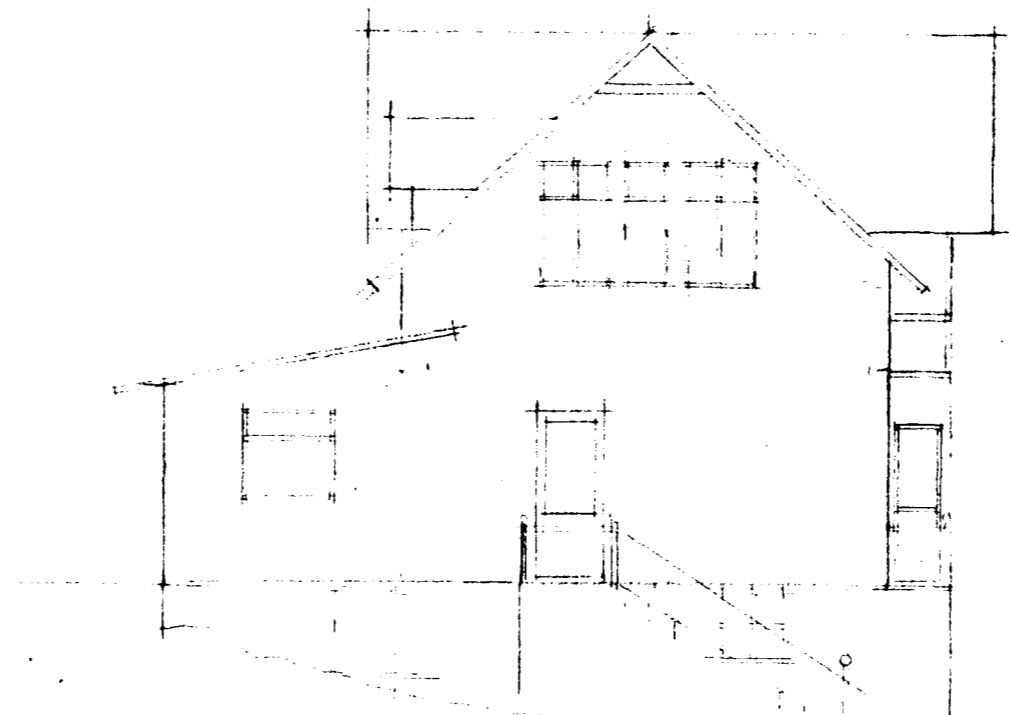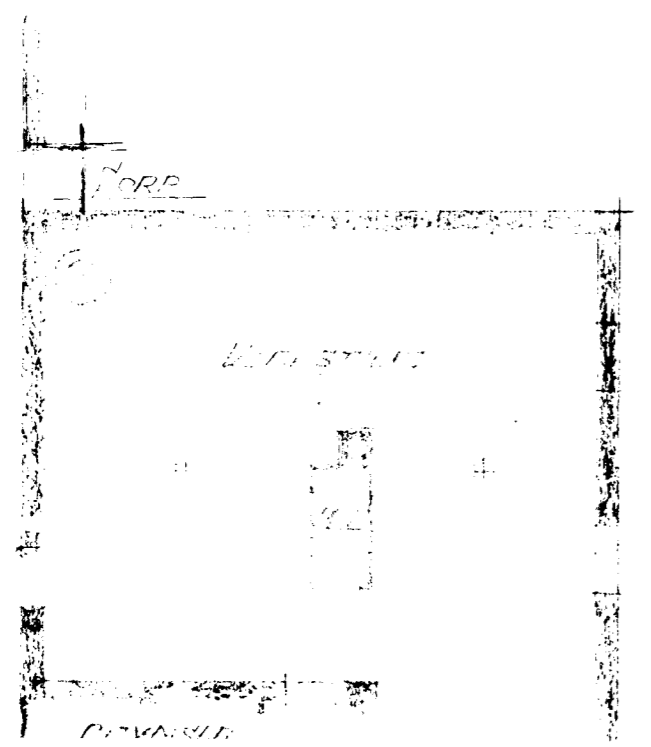

