
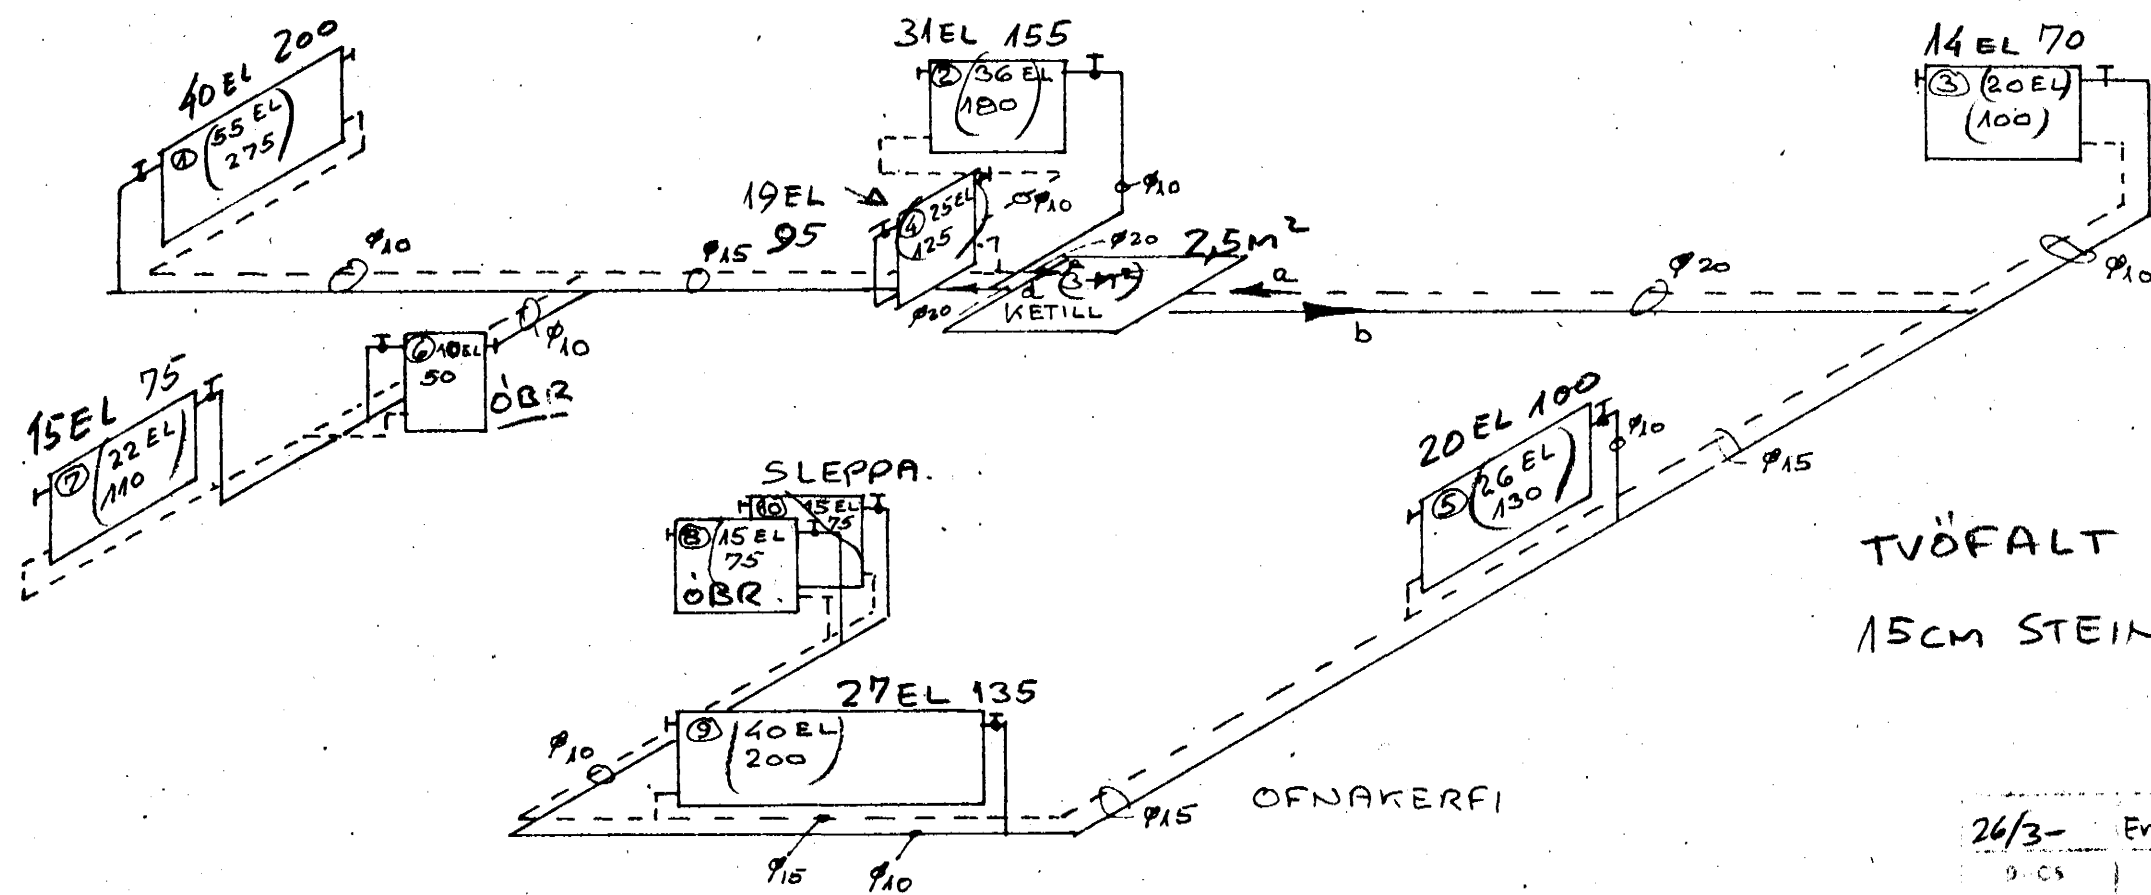


A ÖLLUM ÖFNUM TVÍSTILLIHANAR OG LOFTSKRUFUR.

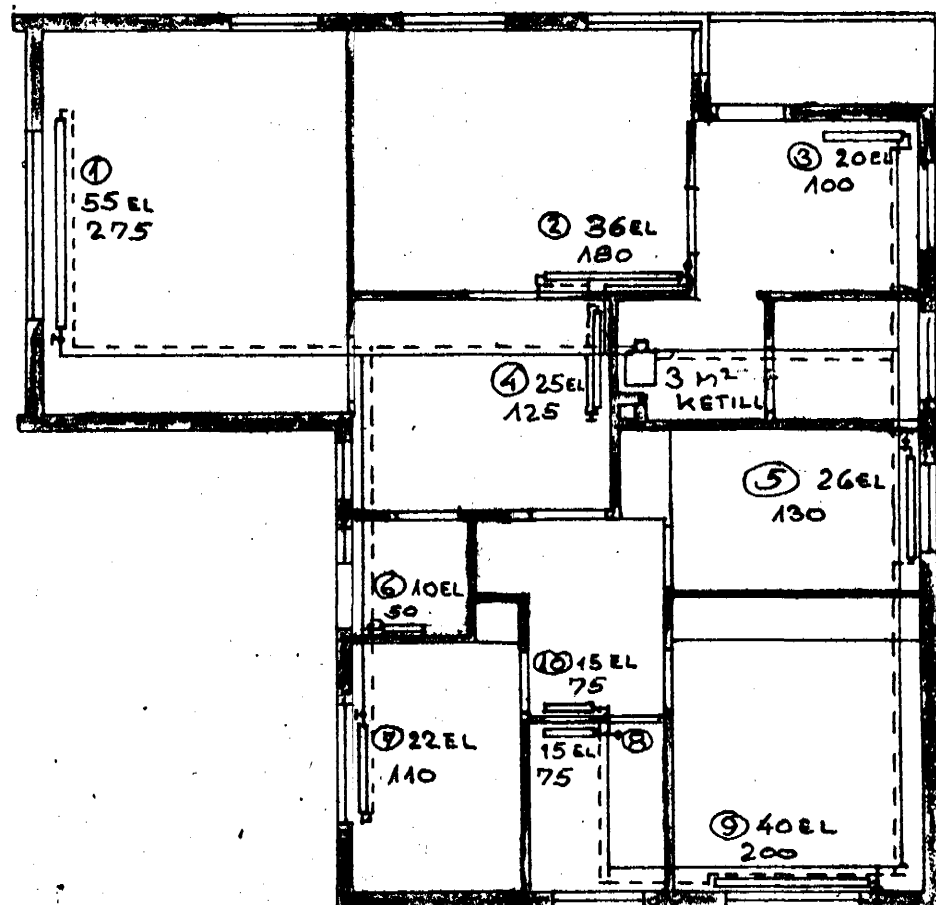

TVÖFALT GLER.
15CM STEINULL Á LOFTI

26/3-	Endursk. f 70°C heita efna fB
B	DRÖGDEI
B	BREKKUVAMMUR 12
B	MIDSTÖÐVARLÖGN.
M: 100 0:0	MARZ '63