
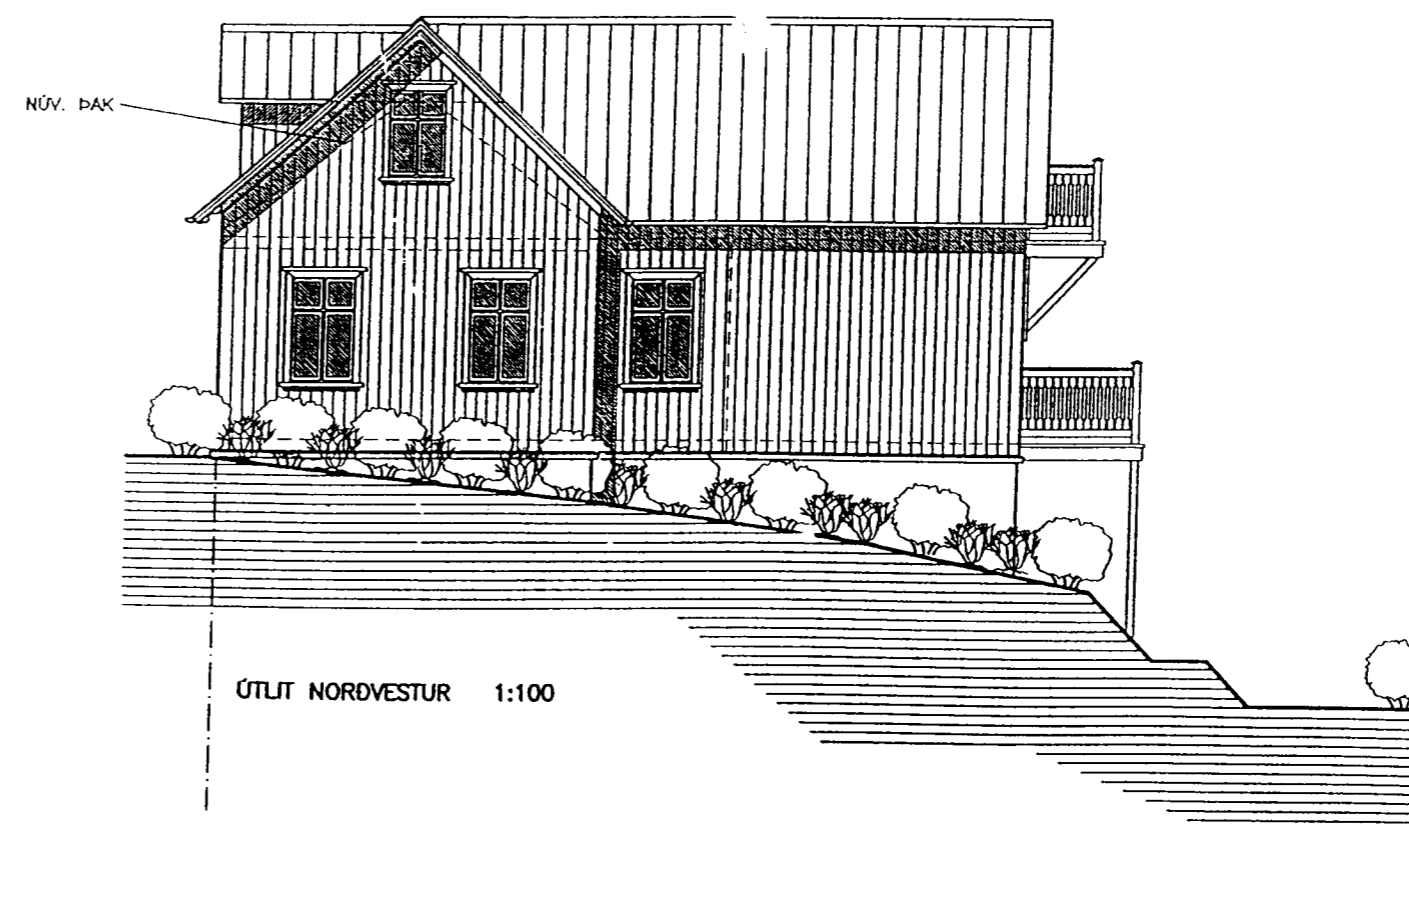
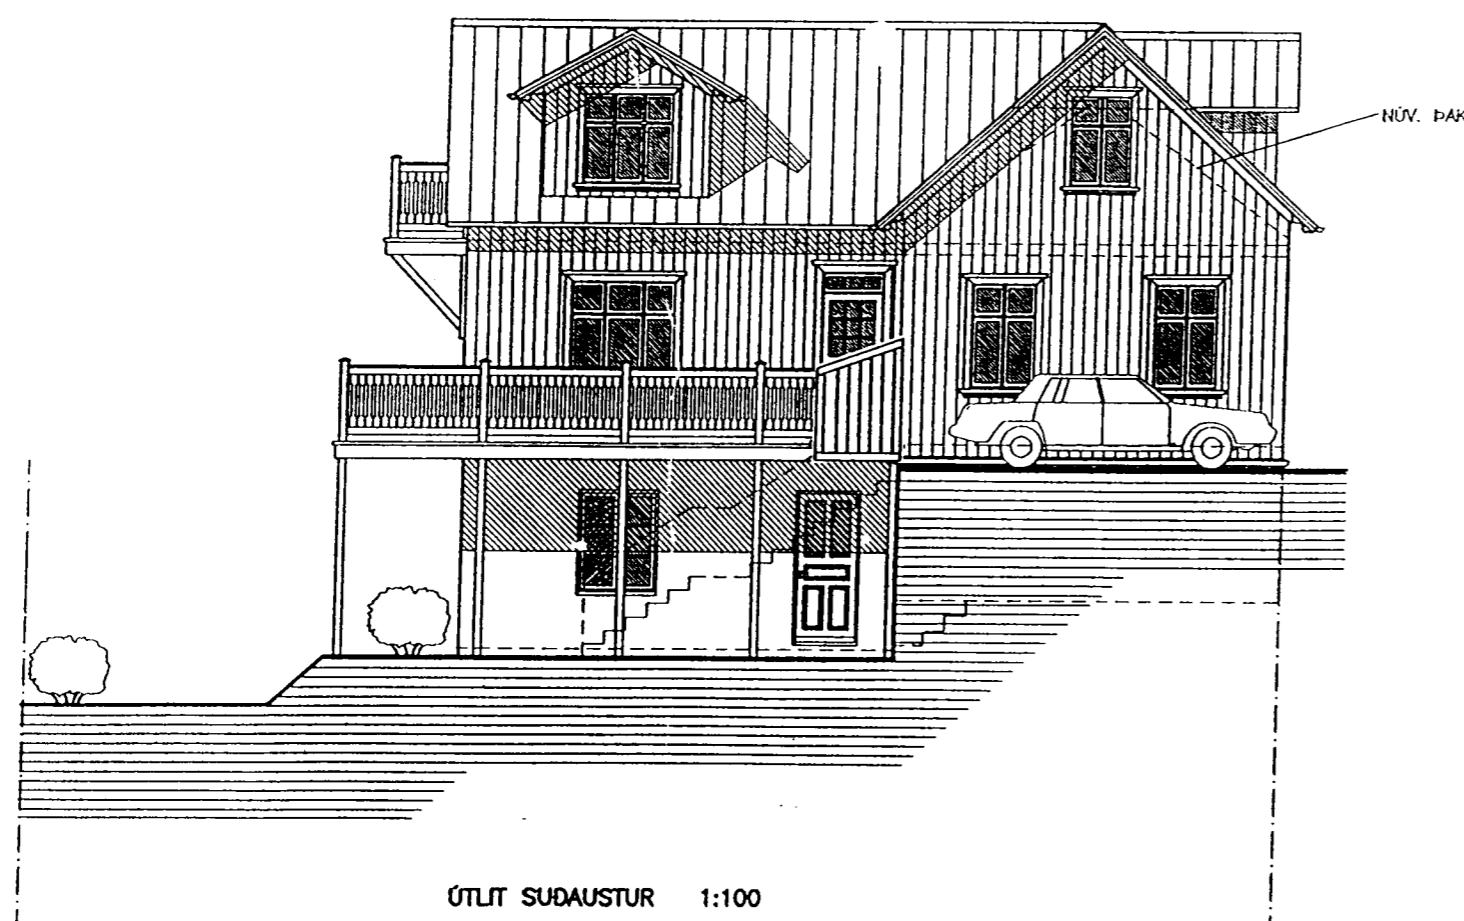
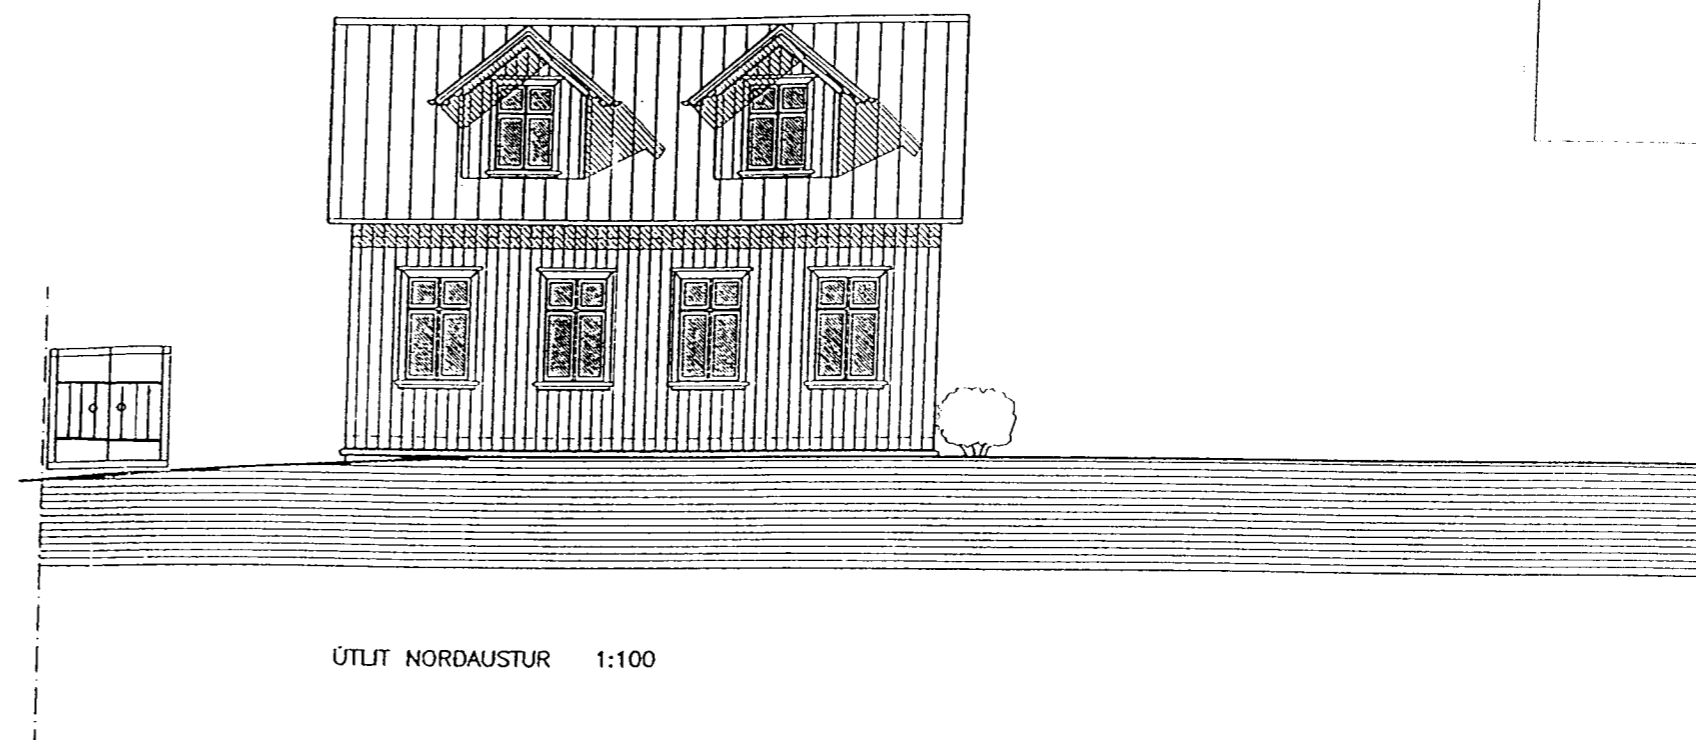


Samþykkt þann

23 FEB. 2005

Byggingafulltrúinn í Hafnarfirði  
F.h. Kristján Þórarinnsson

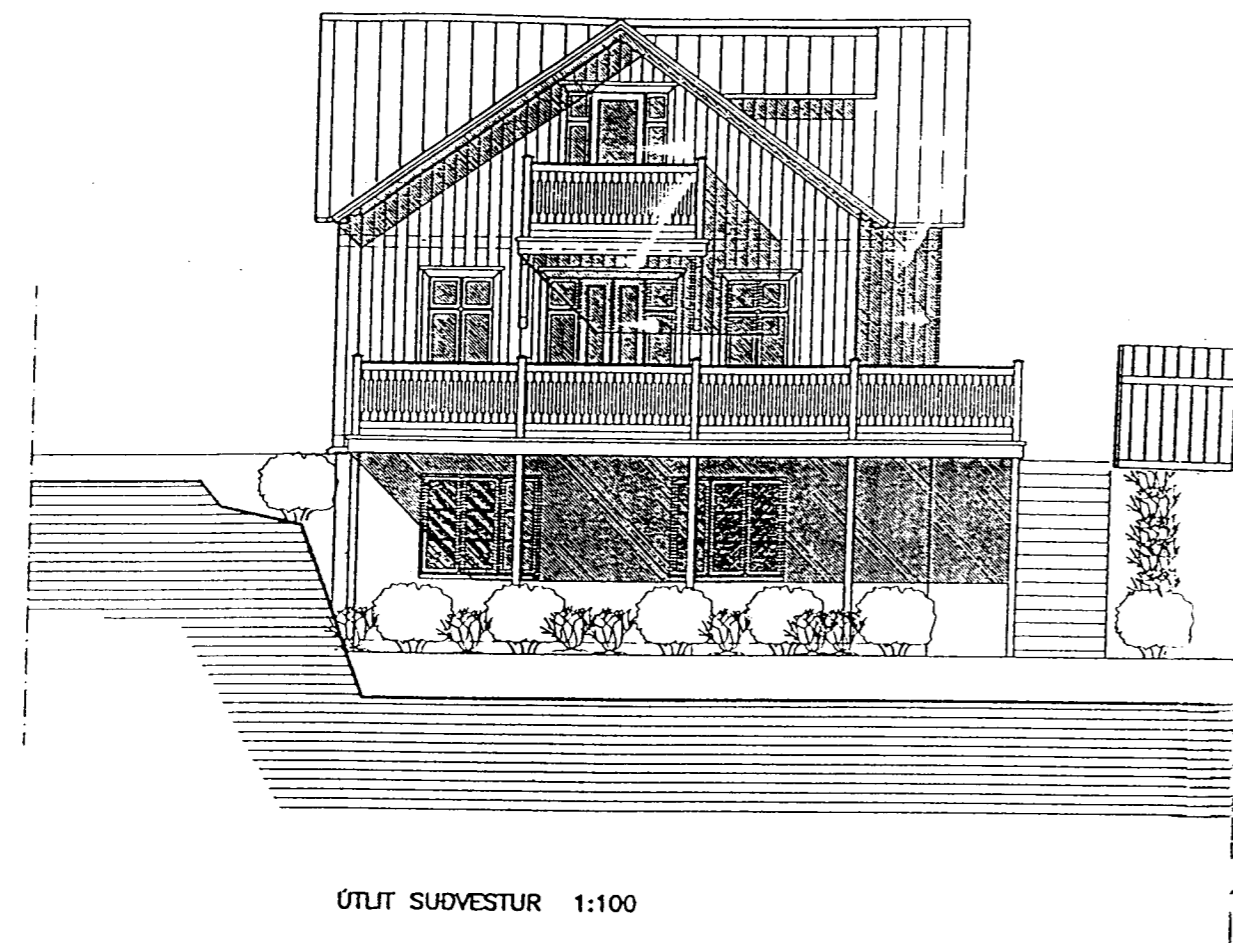

BREYTT: DAGS: LYSING:  
30.09.04 Rúslatunnugeymsla br. 200, dypt: 113, hæð: 160

|  |                                     |
|--|-------------------------------------|
| BRUNNSTÍGUR 7<br>Einbýlishús mhl 01  |                                     |
| ÚTLIT<br>VDBYGGING: RÚSLATUNNUGEYMSLA  | TEIKNAD 30.09.04<br>MÆLKVARDI 1:100 |
| BREYTING Á TEIKNINGU FRÁ<br>TEIKNISTOFAN BRÖDGANI<br>DALL V. BJARNARSON FAI<br>LAUFÁSVEGI 7 101 RVK<br>KT: 060346-2249 | TEIKNAD HI<br>SAMÞYKKT:             |