




GRUNNMYND HÆÐAR 1:50

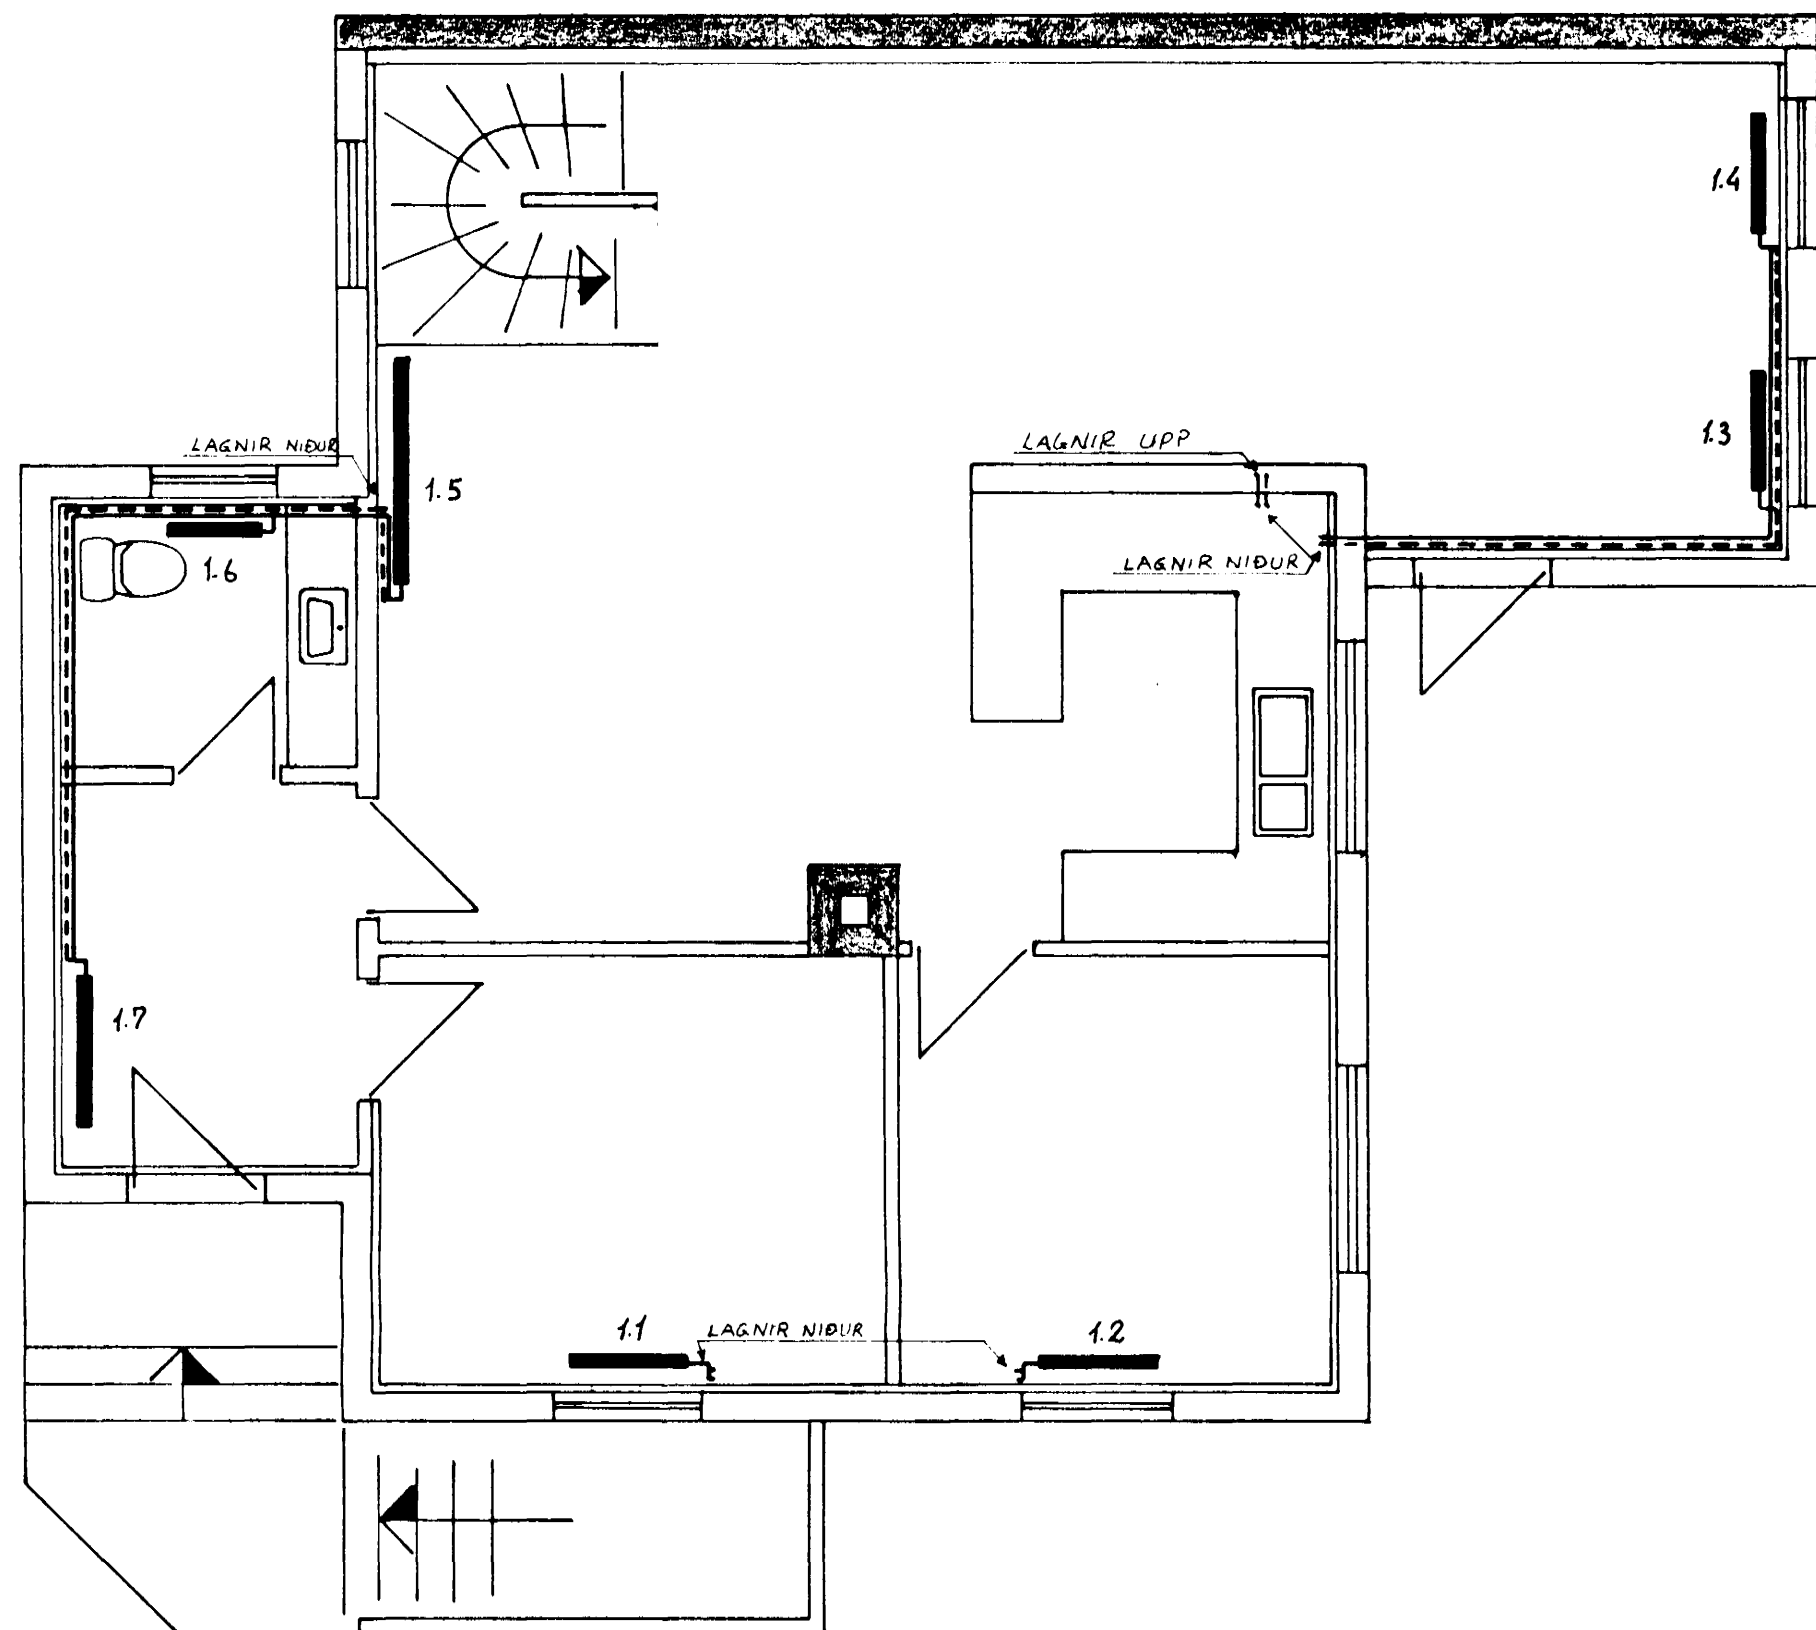

GRUNNMYND RISHÆÐAR 1:50

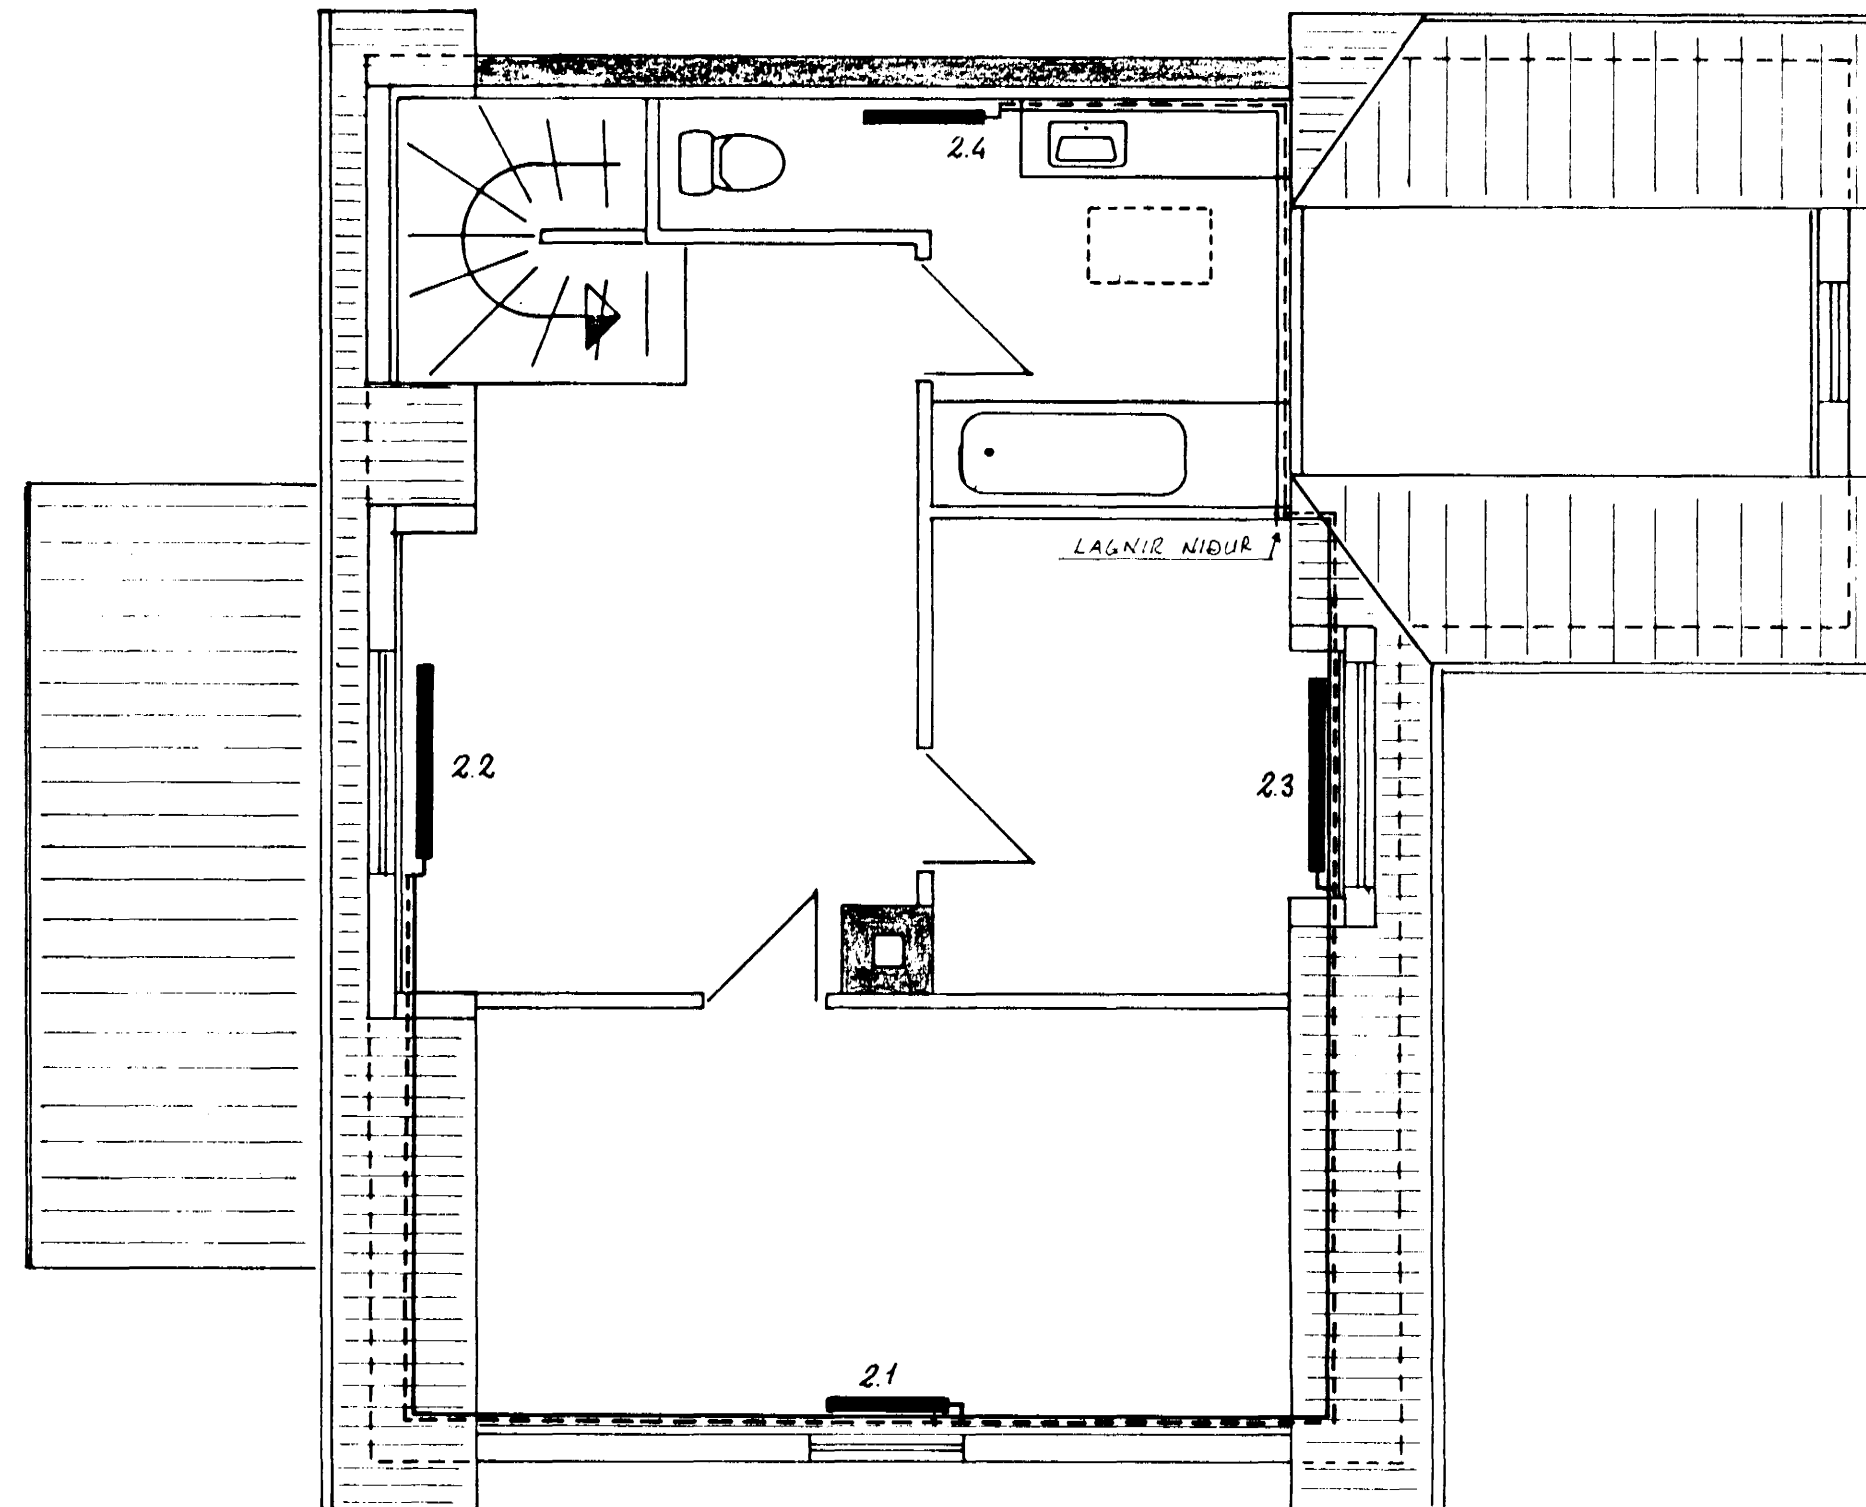


GRUNNMYND KJALLARA 1:50

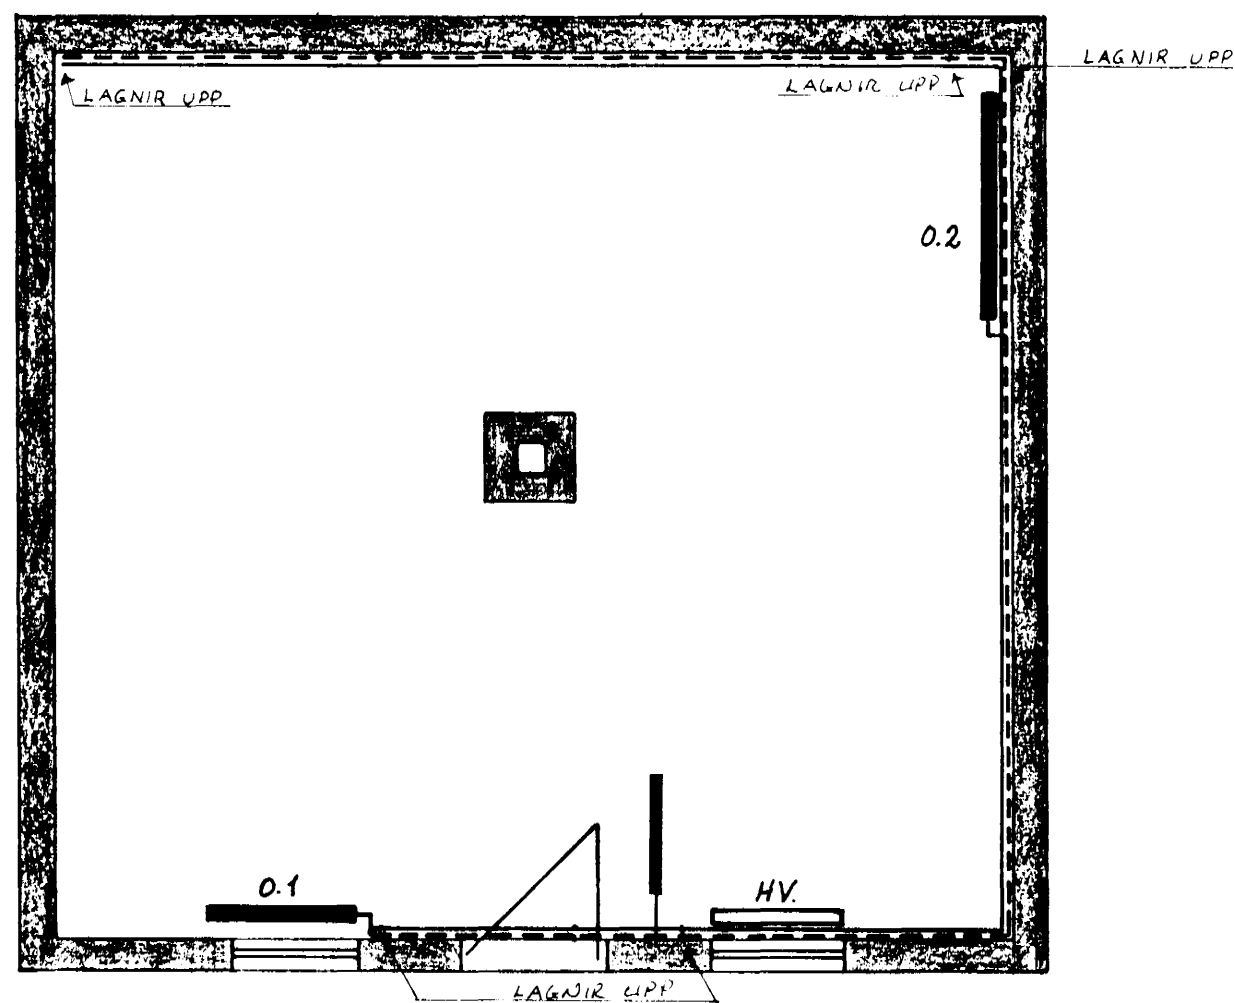

OFNASKRÁ $\Delta T=40^{\circ}\text{C}$

NR	AFKÖST Kcal/h	MESTA HÆÐ	MESTA LENGD	TENGING	ATH.
0.1	1000	700	1000	AB	
0.2	1000	700	1500	CD	
1.1	600	650	800	AB	
1.2	900	650	800	CD	
1.3	675	650	800	CD	
1.4	675	650	800	CD	
1.5	960	650	1500	AB	
1.6	320	650	700	CD	
1.7	600	650	1000	CD	
2.1	680	650	800	AB	
2.2	765	650	1300	AB	
2.3	480	650	1300	CD	
2.4	385			CD	

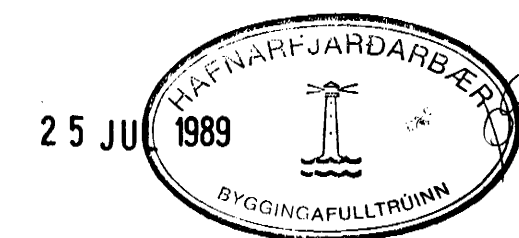

BREYTT í Júlí '89 Síðin 3

VERKFRÆDISTOFA	HALLDÓRS HANNESSONAR S. 91-54355 SUDURGÖTU 14 - 220 HAFNARFJÖRÐUR
	Mkv. 1:50
BRUNNSTÍGUR 6, HAFNARFIRÐI	Reiknað: <i>Sigur B</i>
HITALAGNIR, GRUNNMYNDIR OG OFNASKRÁ.	Teiknað: <i>Sigur B</i>
Verk:	Yfirfarið:
Blað nr. 4,1	Dags: Október '86