


VATNSLÖGN: HÚS NR 3.

KERFI, RÚMMYND, 1:50.

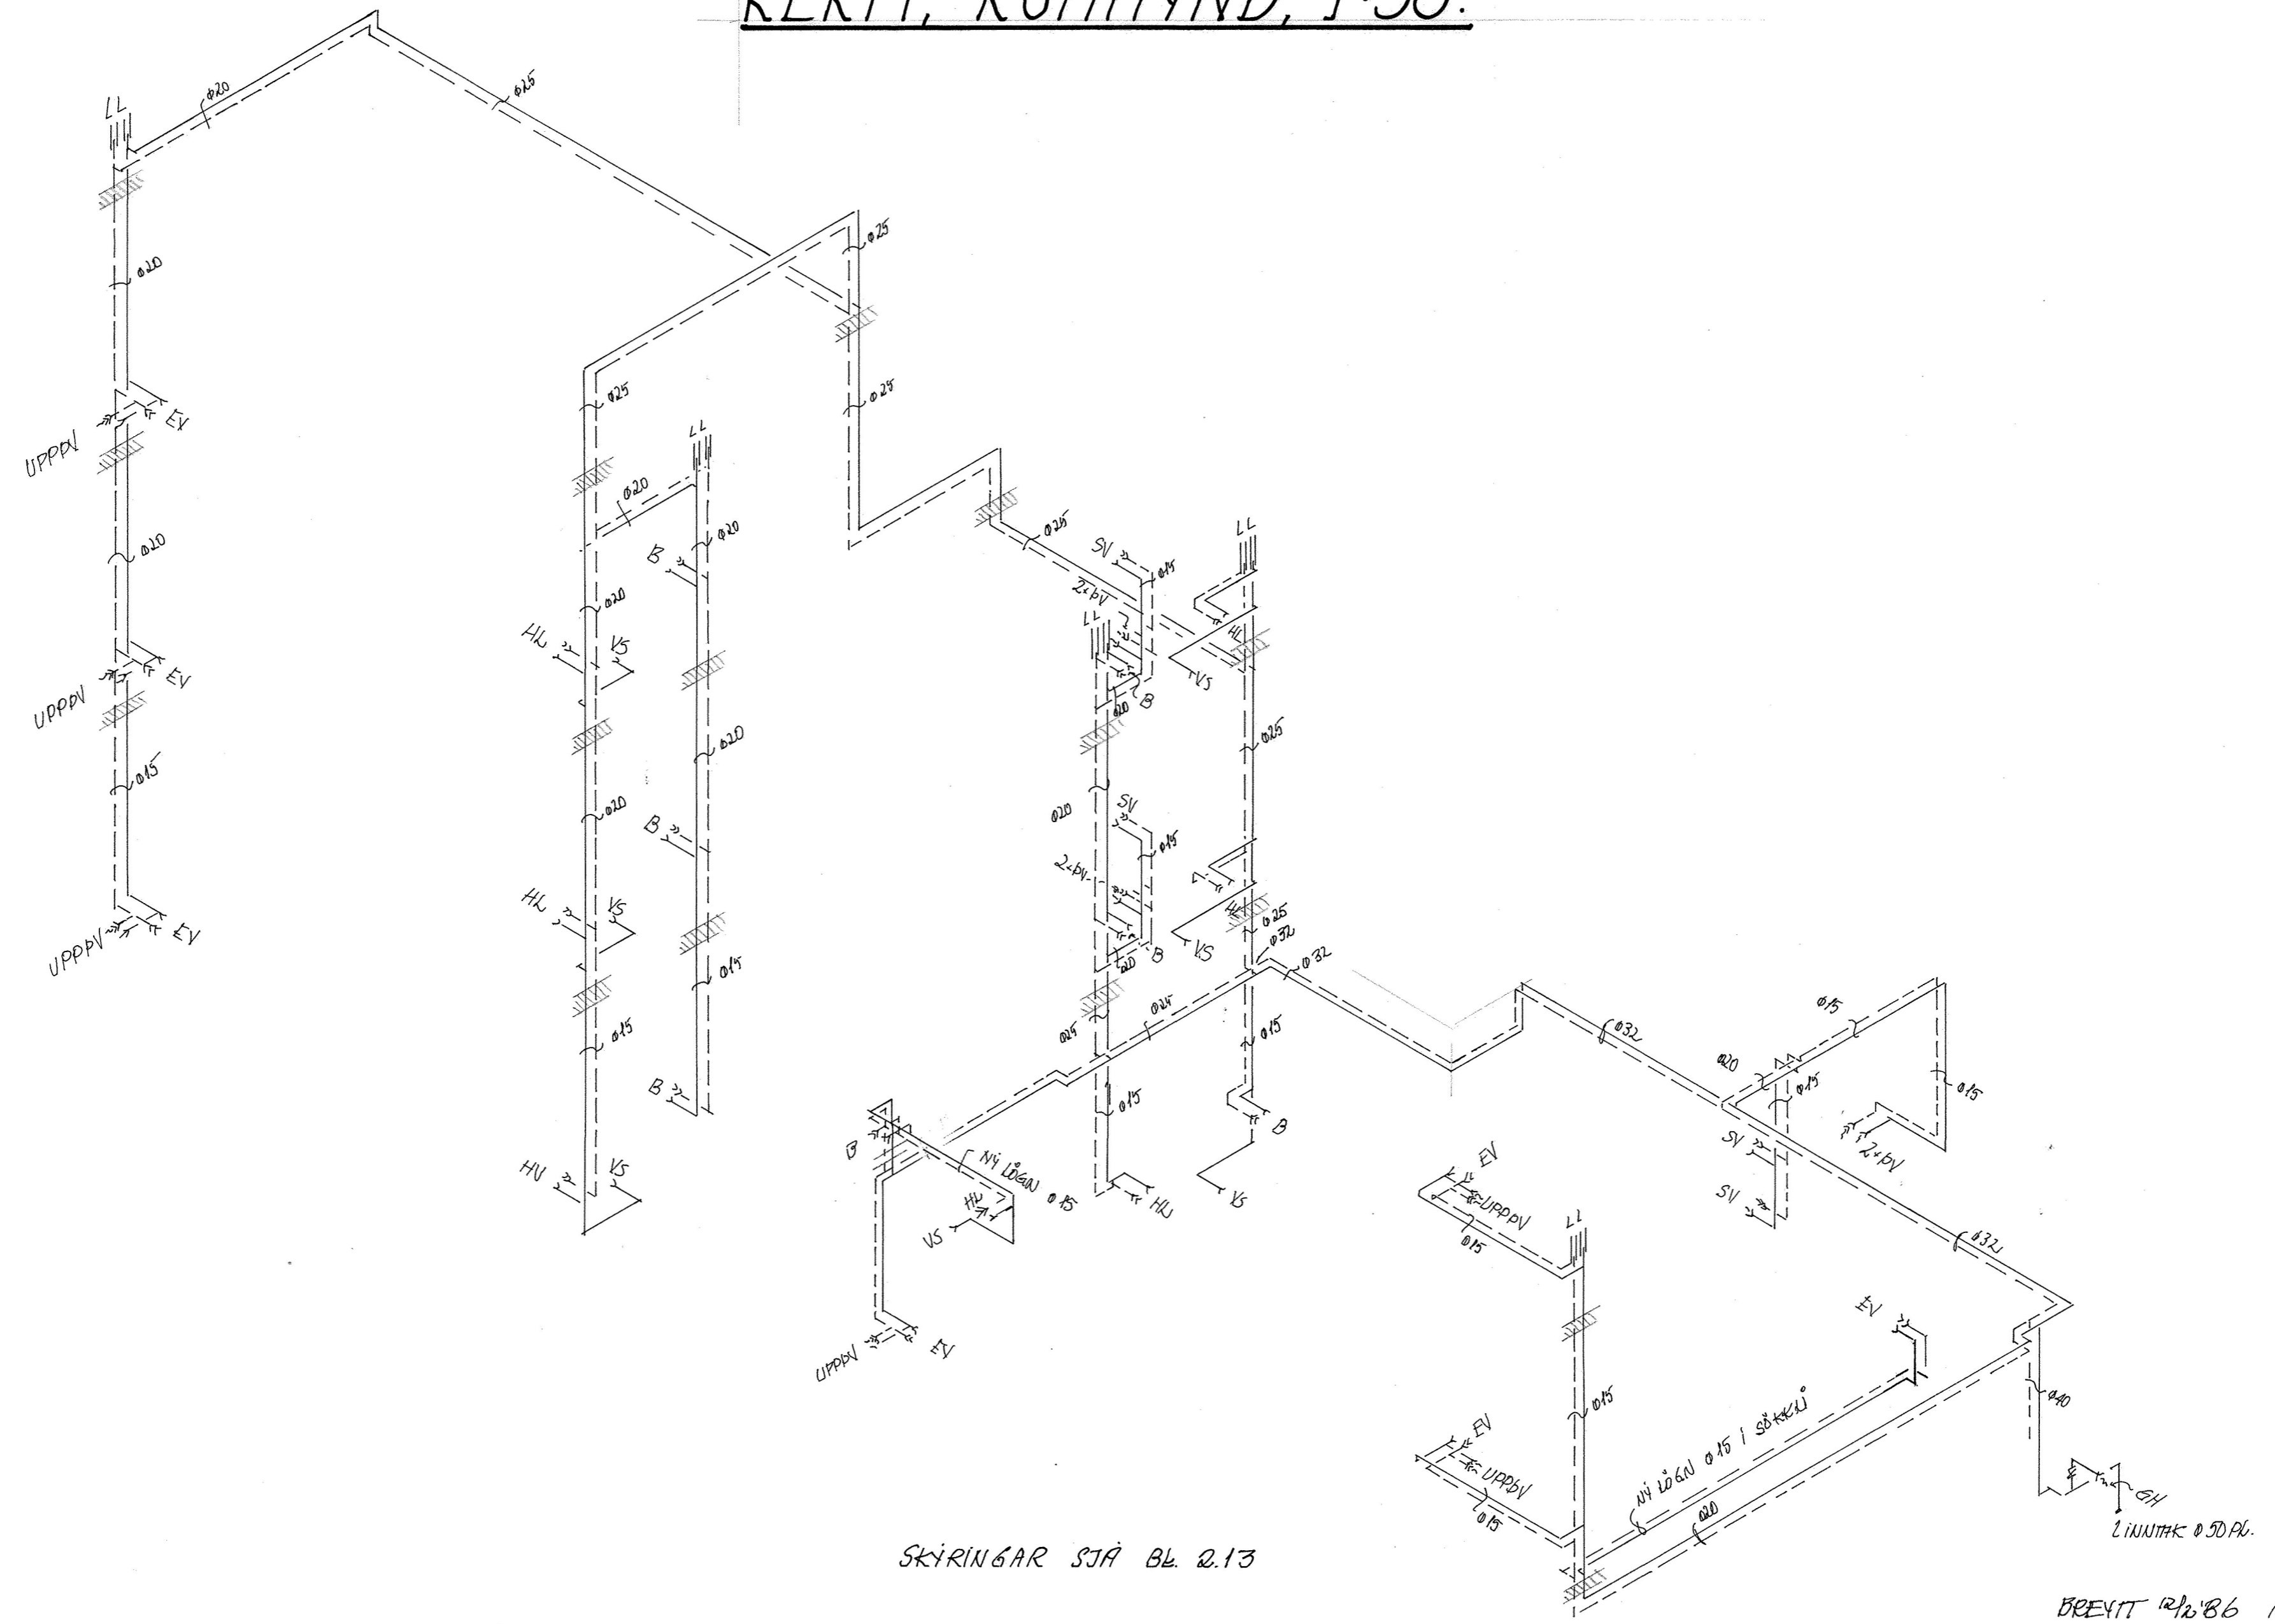

SKIRINGAR SJÁ BL. 2.13

Hilmar Knudsen