


HITALÖGN: HÚS NR. 3.

GRUNNMYND 2. HÆÐAR, 1:50.

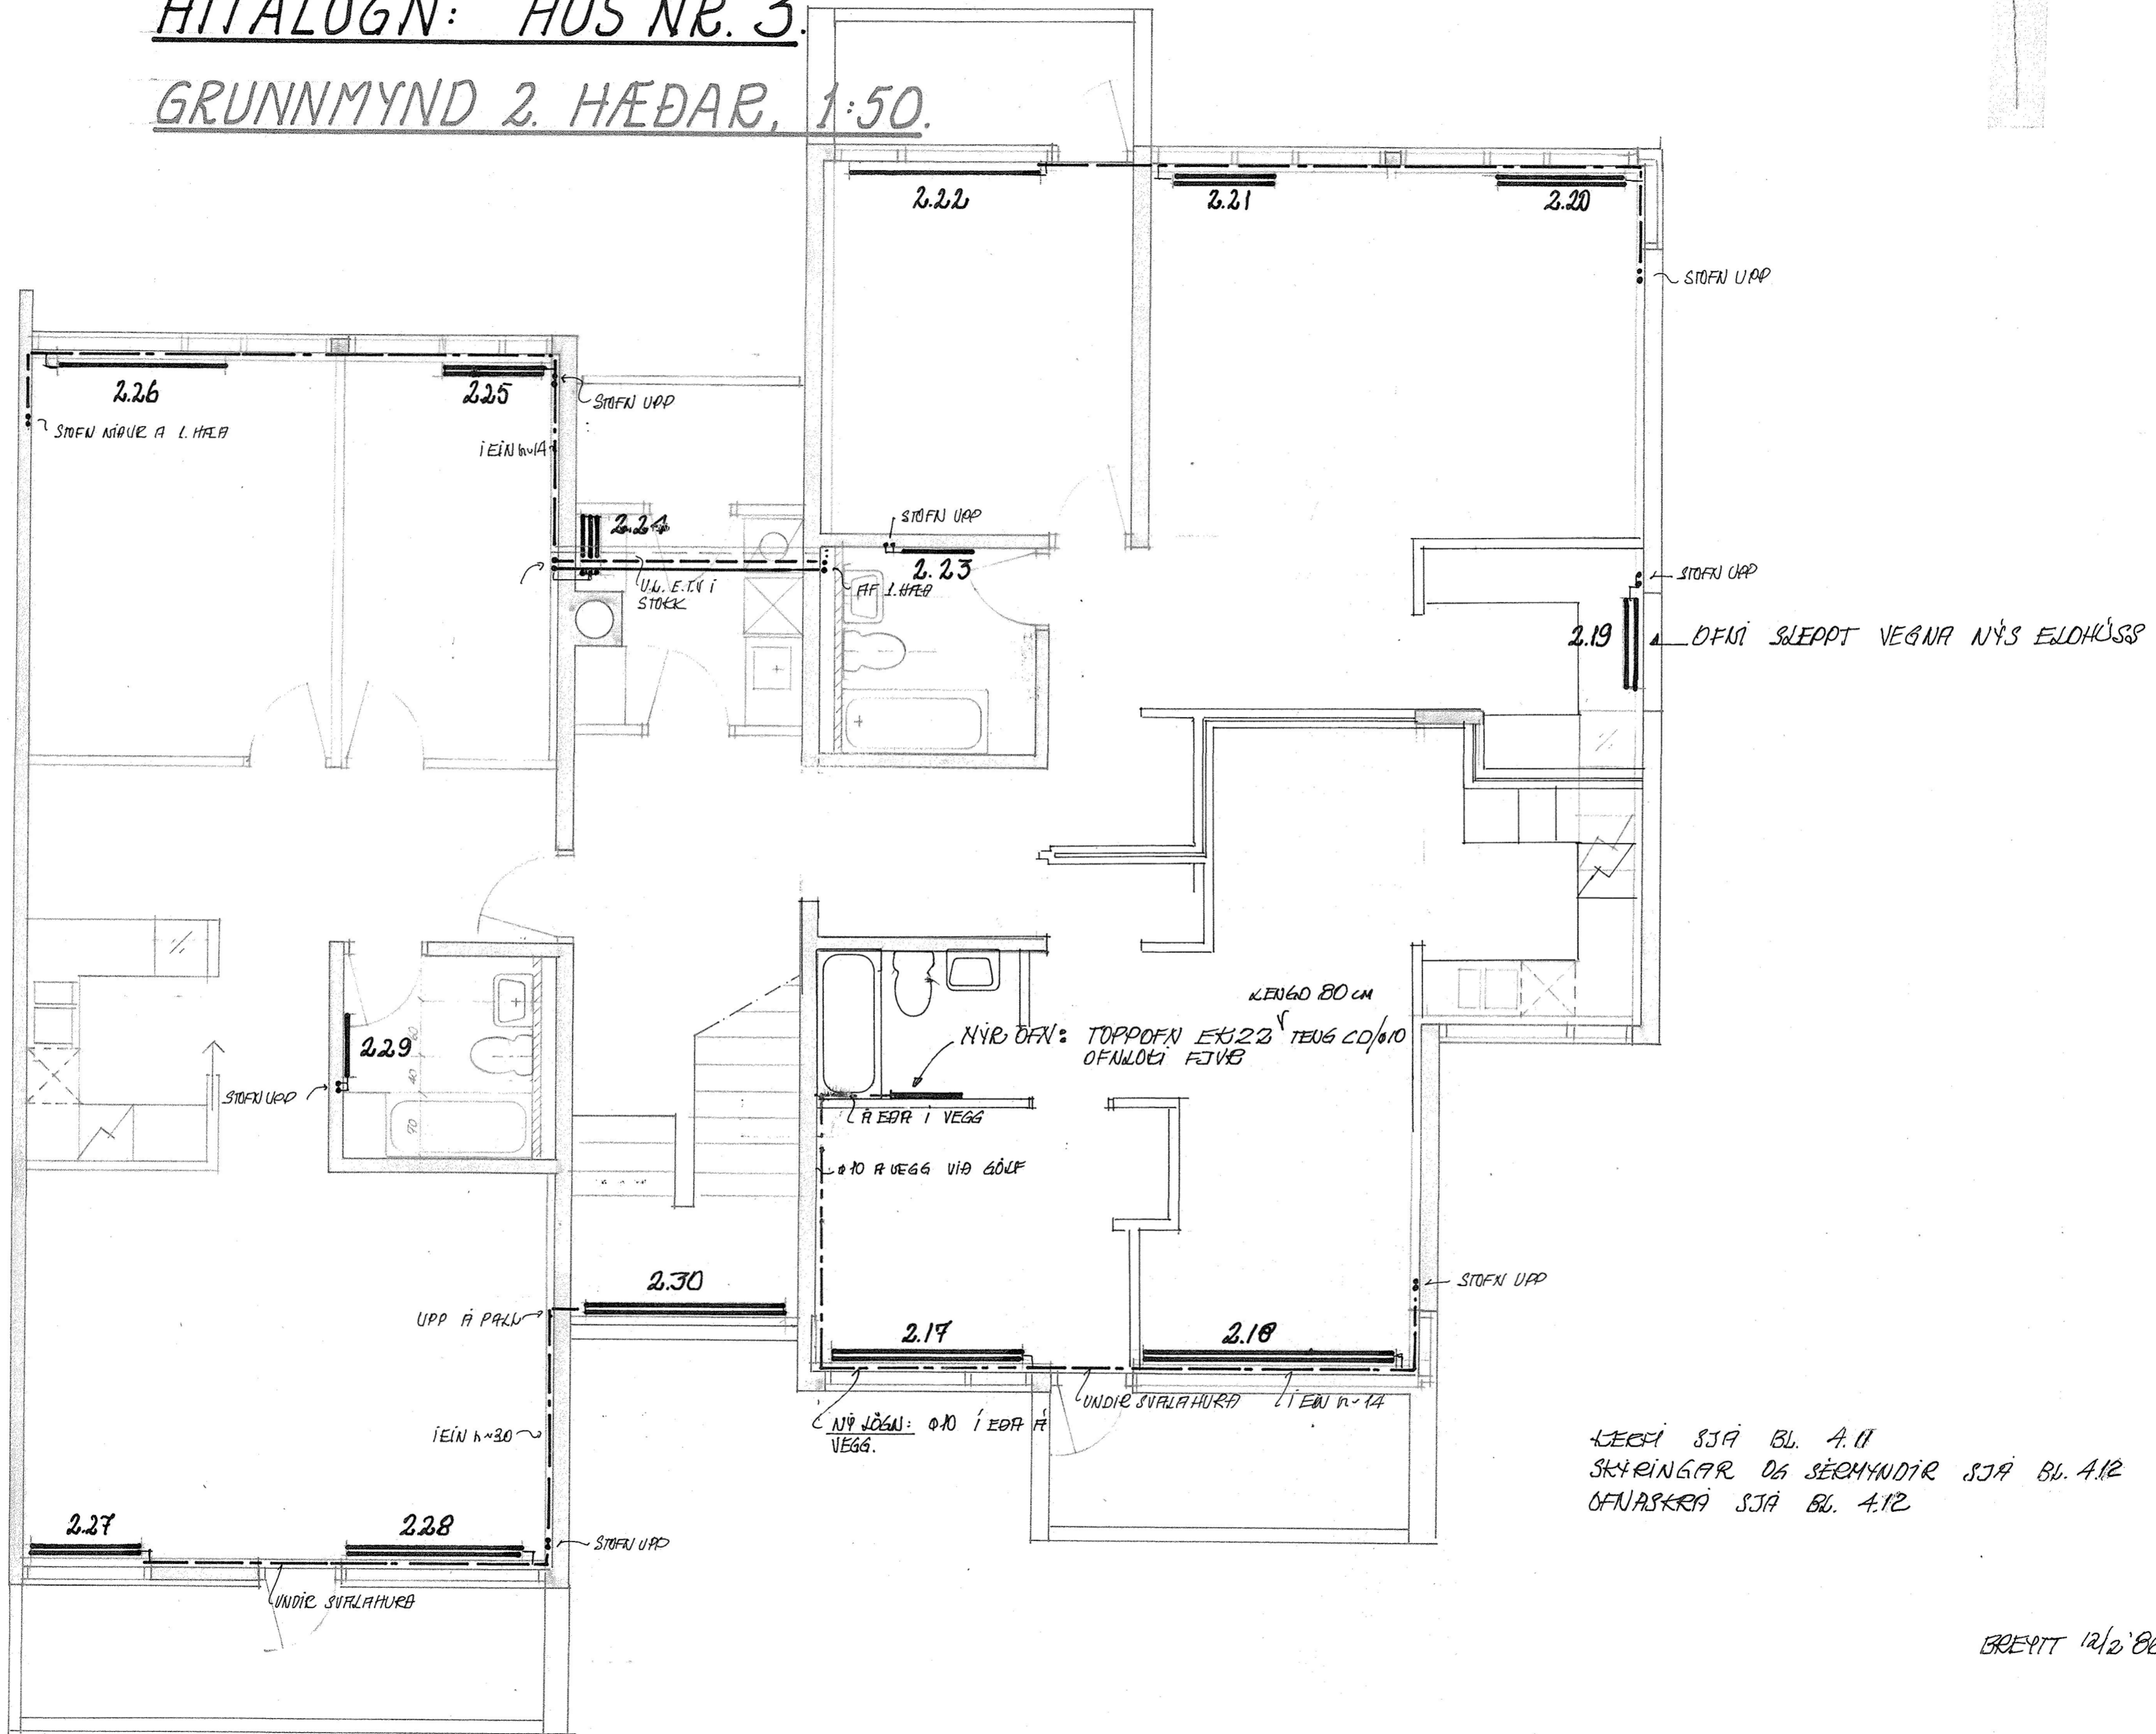

BREYTT 12/2'86 HKJ