


FRÆRENNSLI: HÚS NR. 3.
GRUNNMYND 2. HÆÐAR, 1:50!

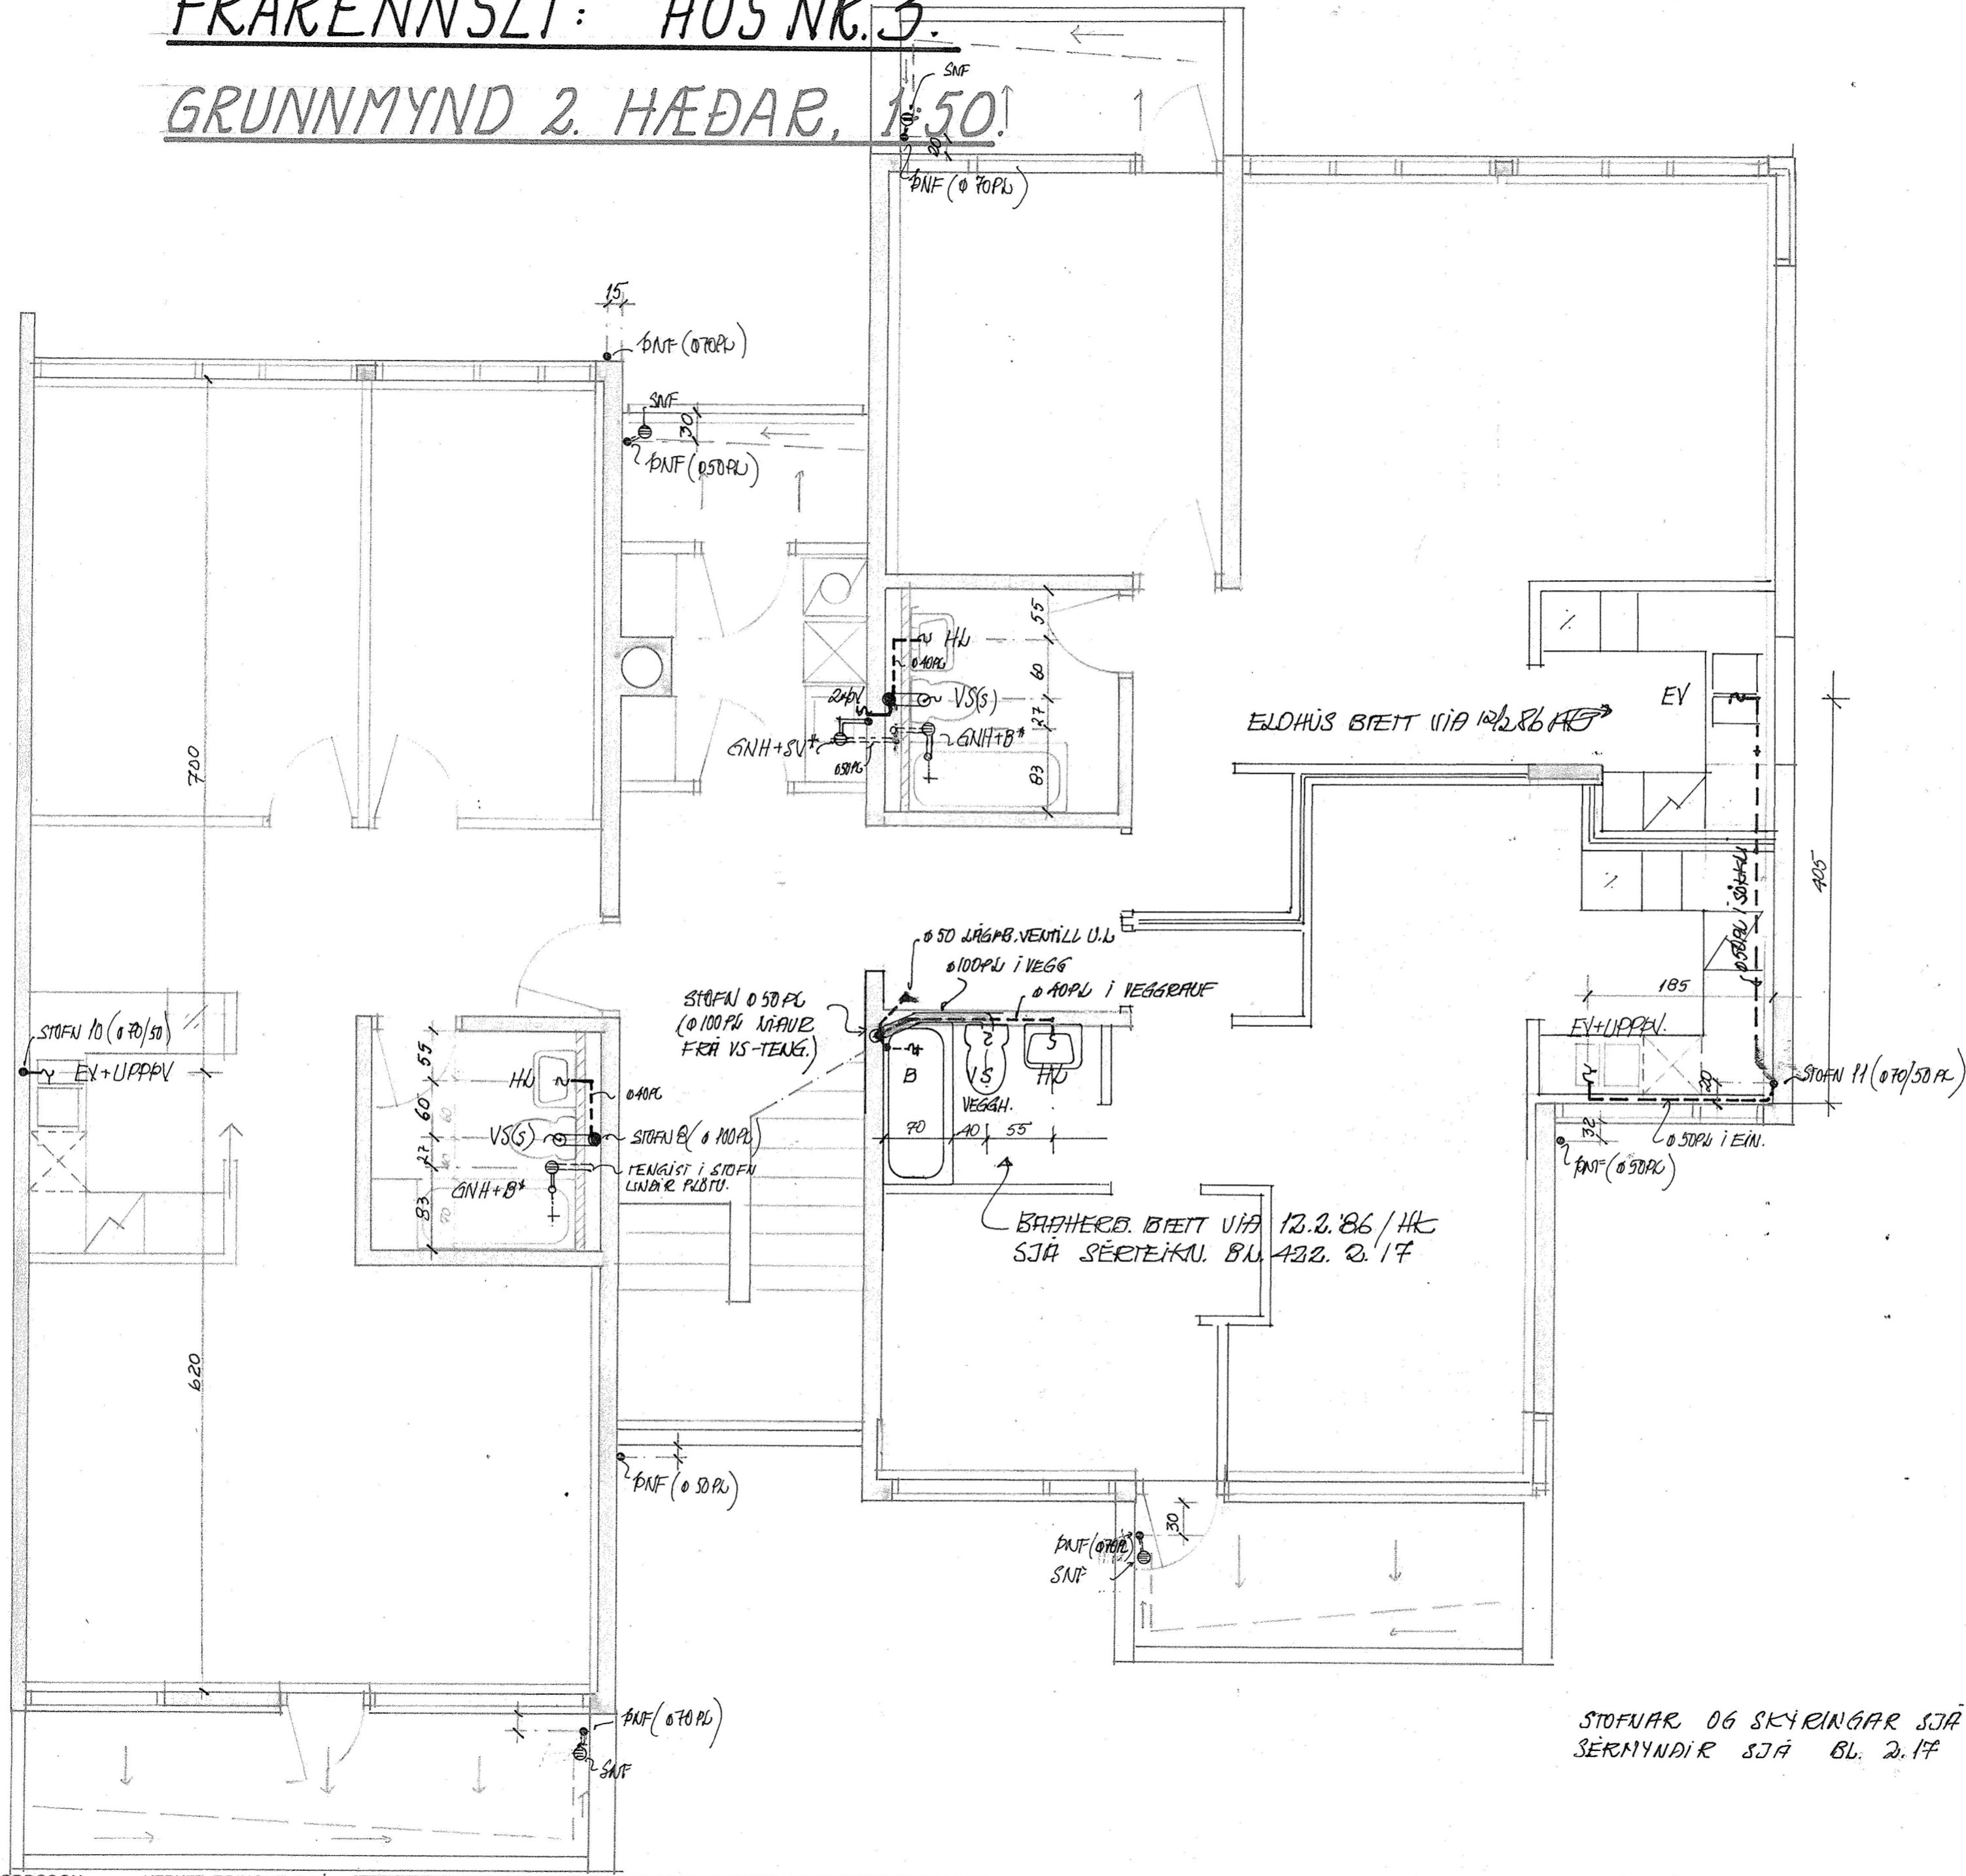

STOFNAR 06 SKYRINGAR SJÁ BL. 2.16
 BERNYNDIR SJÁ BL. 2.17

BRETT 12.2.'86 HK