

PIZZAHÖLLIN

DALSHRAUN 12 HFJ.

ÖLL LOKUB RÝMI VERDA LOFTRÆST MED VÉLRÆNUM LOFTRÆSTIBÚNAÐI



↑
BÞJÖRGUNARÖP
BO 0,8x1,2

A60 MERKI UM BRUNAMÖTSTÖÐU

Í HÚSINU SKAL VERA ÚTGÖNGU OG NEYDARLÝSING
STADSETT DAR SEM VÍÐ Á.

KLÆÐNINGAR Í BRUNAVEGGJUM SKU. U VERA Í FLOKKI 1

STÆÐIR:	FLATARM.	RÚMMÁL
01-01	255,6 m ²	1,049,6 m ³
01-02	72,0 m ²	286,2 m ³
01-03	72,0 m ²	286,2 m ³
01-04	72,0 m ²	286,2 m ³
01-05	72,0 m ²	286,2 m ³
01-06	123,0 m ²	488,9 m ³
SAMTALS:	666,6 m ²	2683,3 n ³

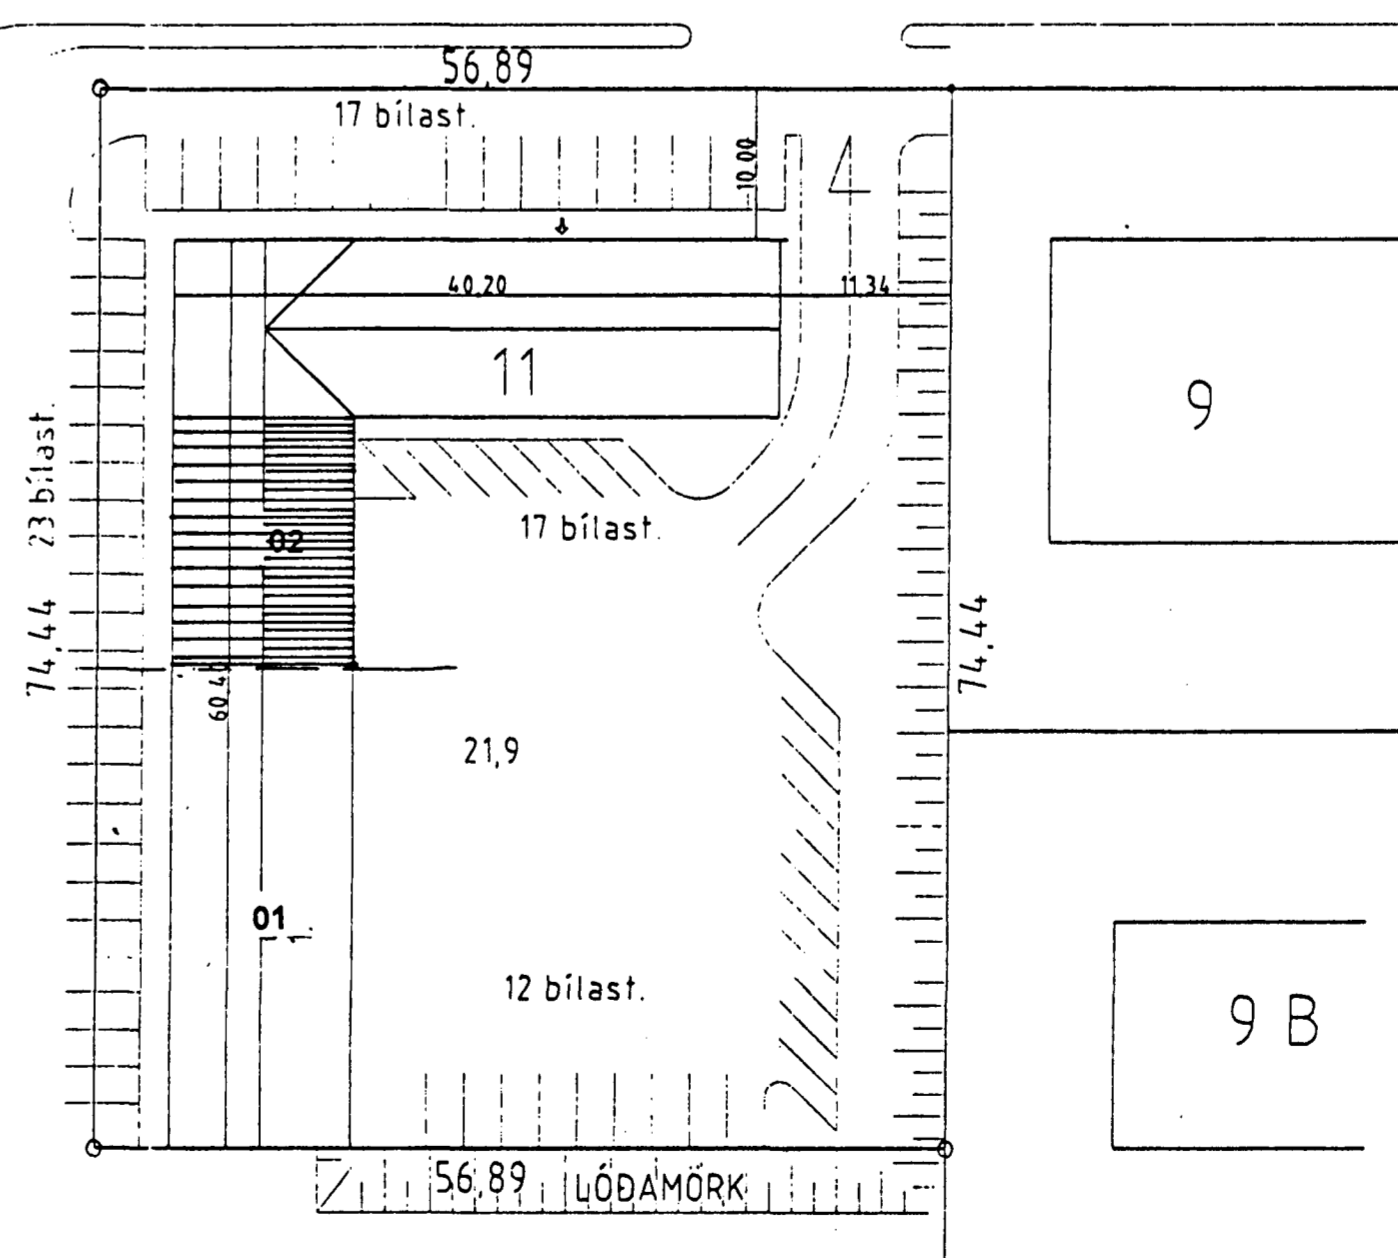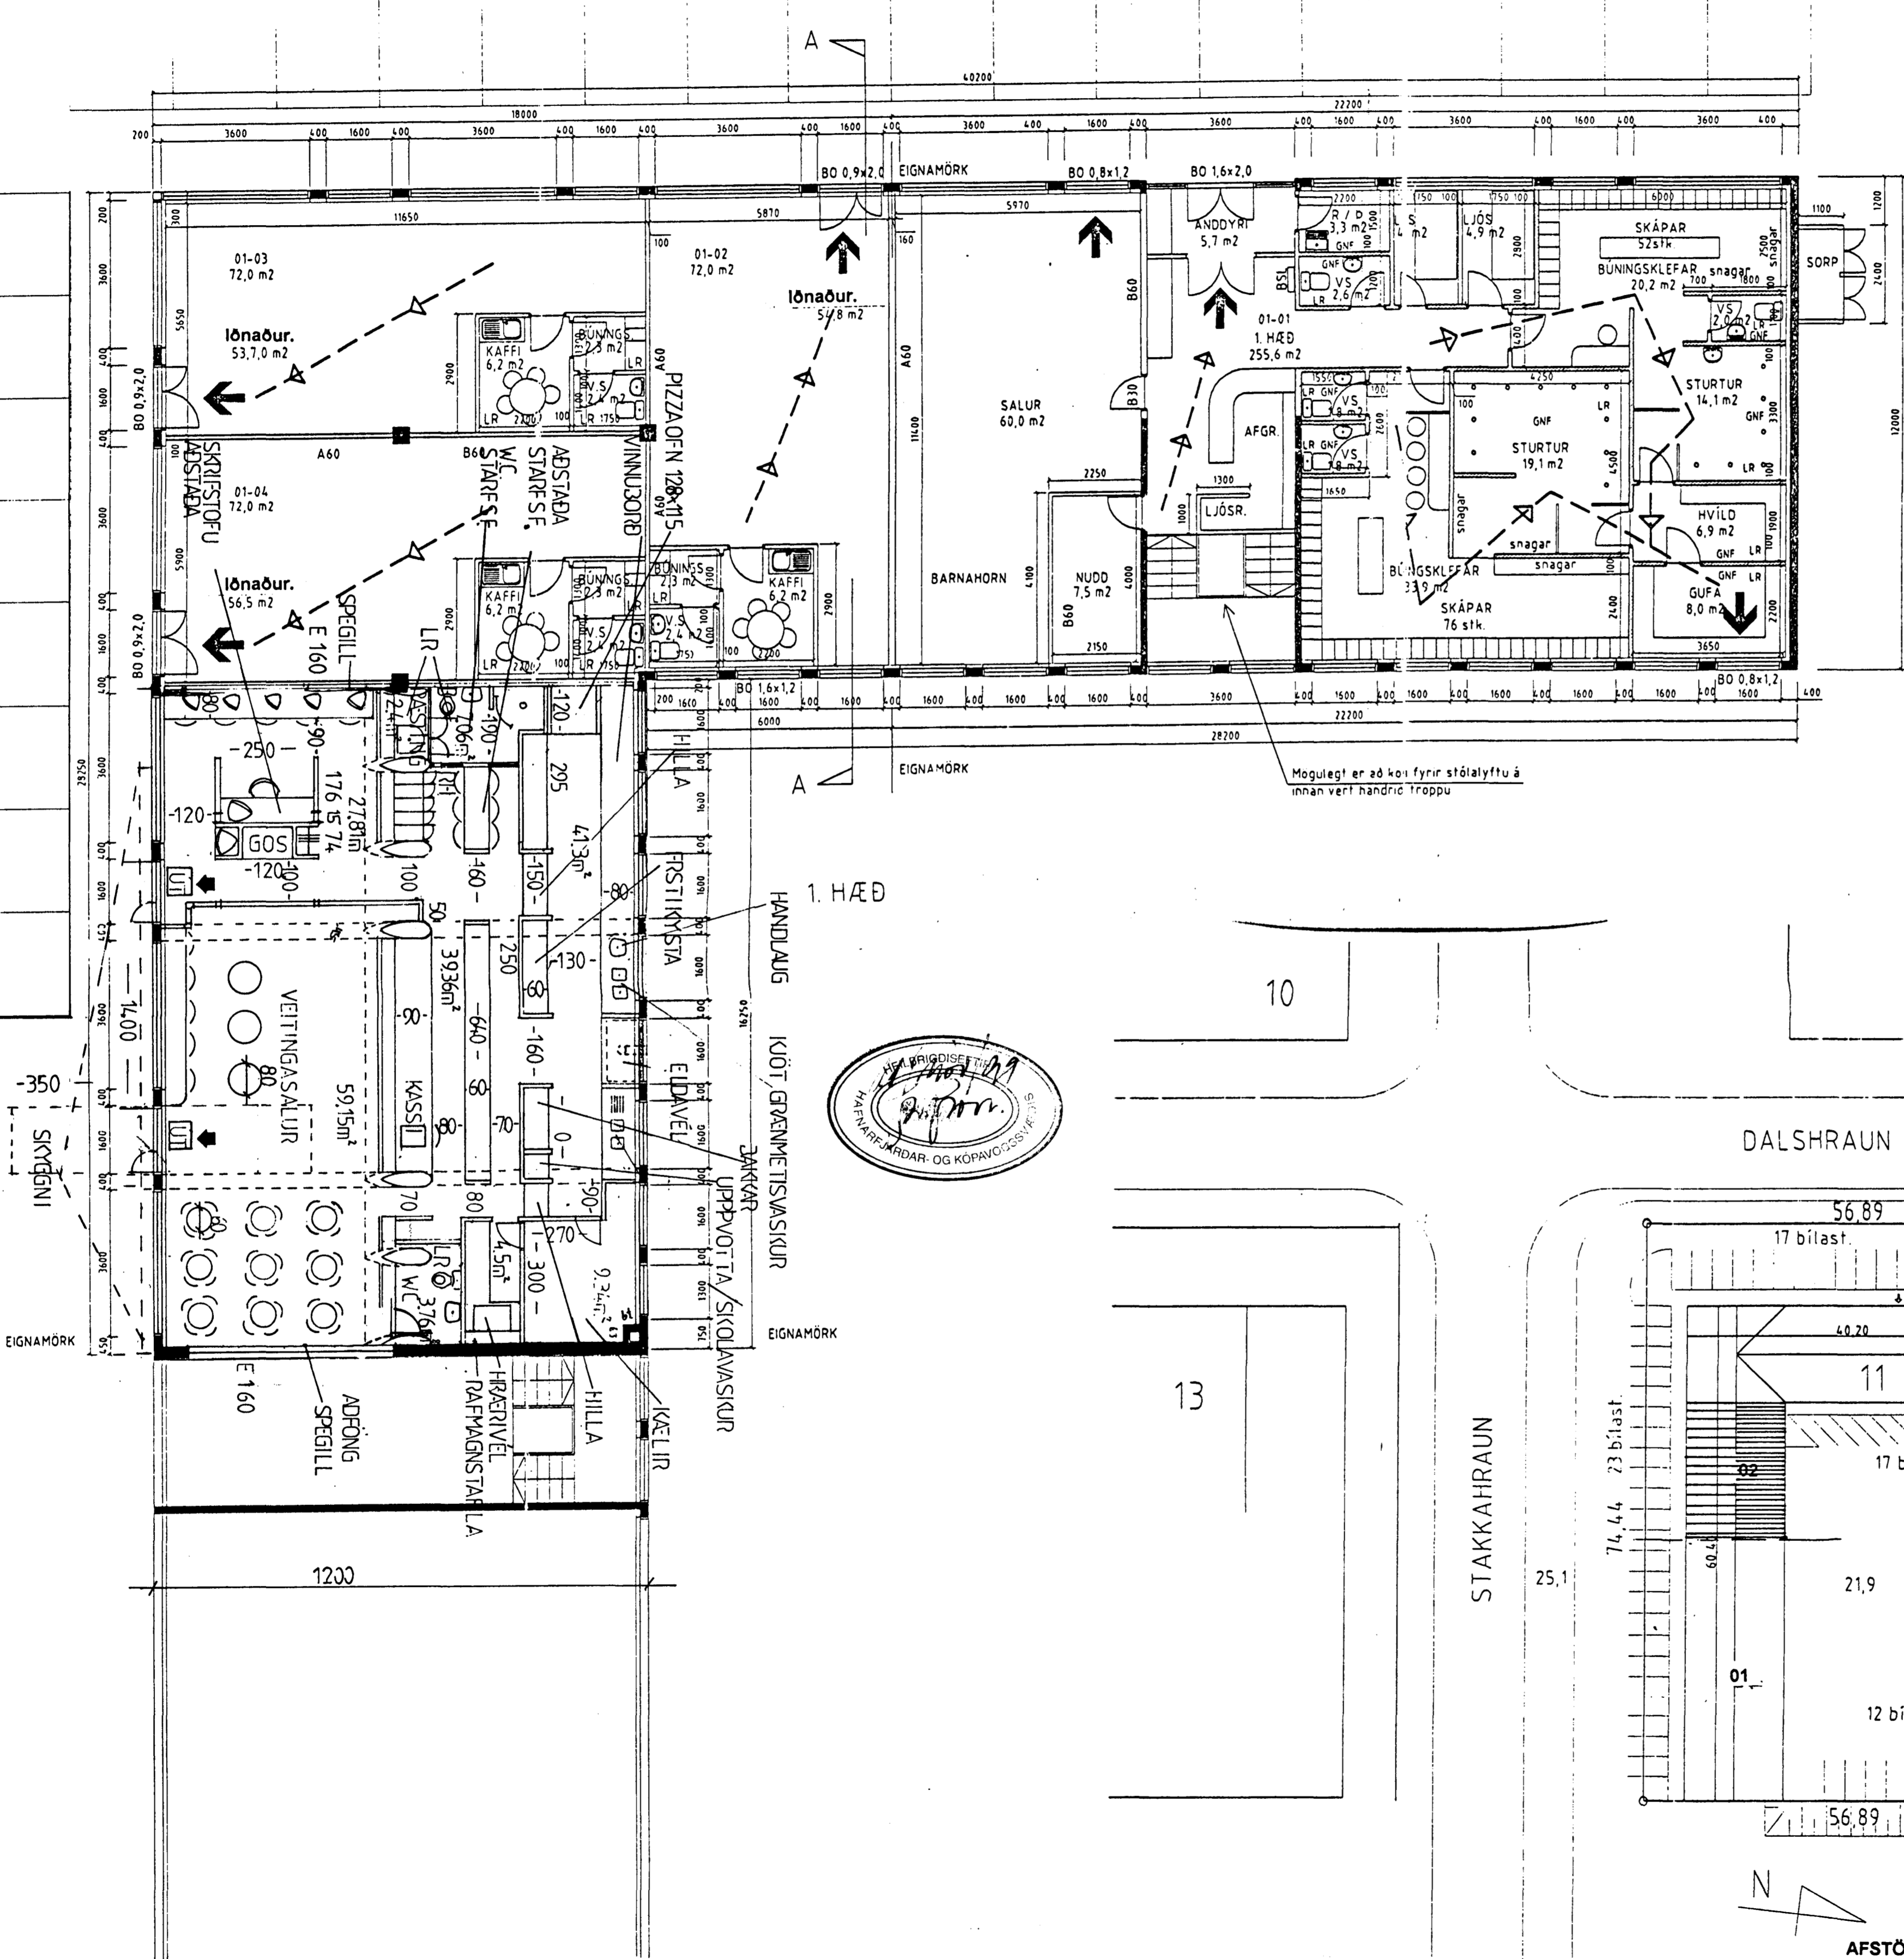

AFSTÖÐUMYND 1 : 500.

HUGSMÍÐ teiknistofa

Ahliða hönnun, ráðgjöf & framkvæmd.

VERKERNI: PIZZAHÖLLIN DALSHRAUN 12	ATHS:
TEIKNARVY: MHL GRUNNMÝND 1 : 100	
DAGS TEIKN: 10. NOV. '99	ARKITEKT: GJÖLJÓN BJARNÁSSON MFA, M.A.RCH., FAL GULLEIK LÖVSKAR BA, INT. ARC. KLAPPASTÍGUR 28, SHÆB, 101 REYKJAVÍK SÍMI 551 1770 GSM 883 1770 FAX 572 1977 E-MAIL: gulo@er.li
DAGS BREVITT:	